


5 cm

04 BH13-156 247 S

P43  
LIFT 2

0374\_4415

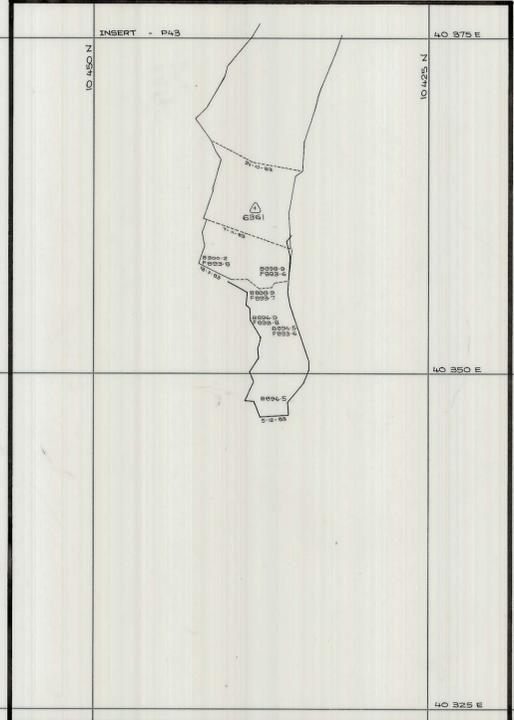

TA7 along 04BH13-156 247 S  
 TA8 along 04BH13-156 247 S

10450 N  
 40450 E  
 10425 N  
 40425 E

C1 Lens  
 2115  
 2127



LOCATION  
 BOLD HEAD MINE  
 SUBJECT  
 P43 STOPE  
 2nd Lift

KING ISLAND SCHEELITE  
 A DIVISION OF WARMAN INTERNATIONAL  
 GRASSY KING ISLAND  
 PLAN NUMBER  
 04 BH13-156 247 S

SEE INSERT