


04BH13-156 249 S

P43  
LIFT I

0374\_4416

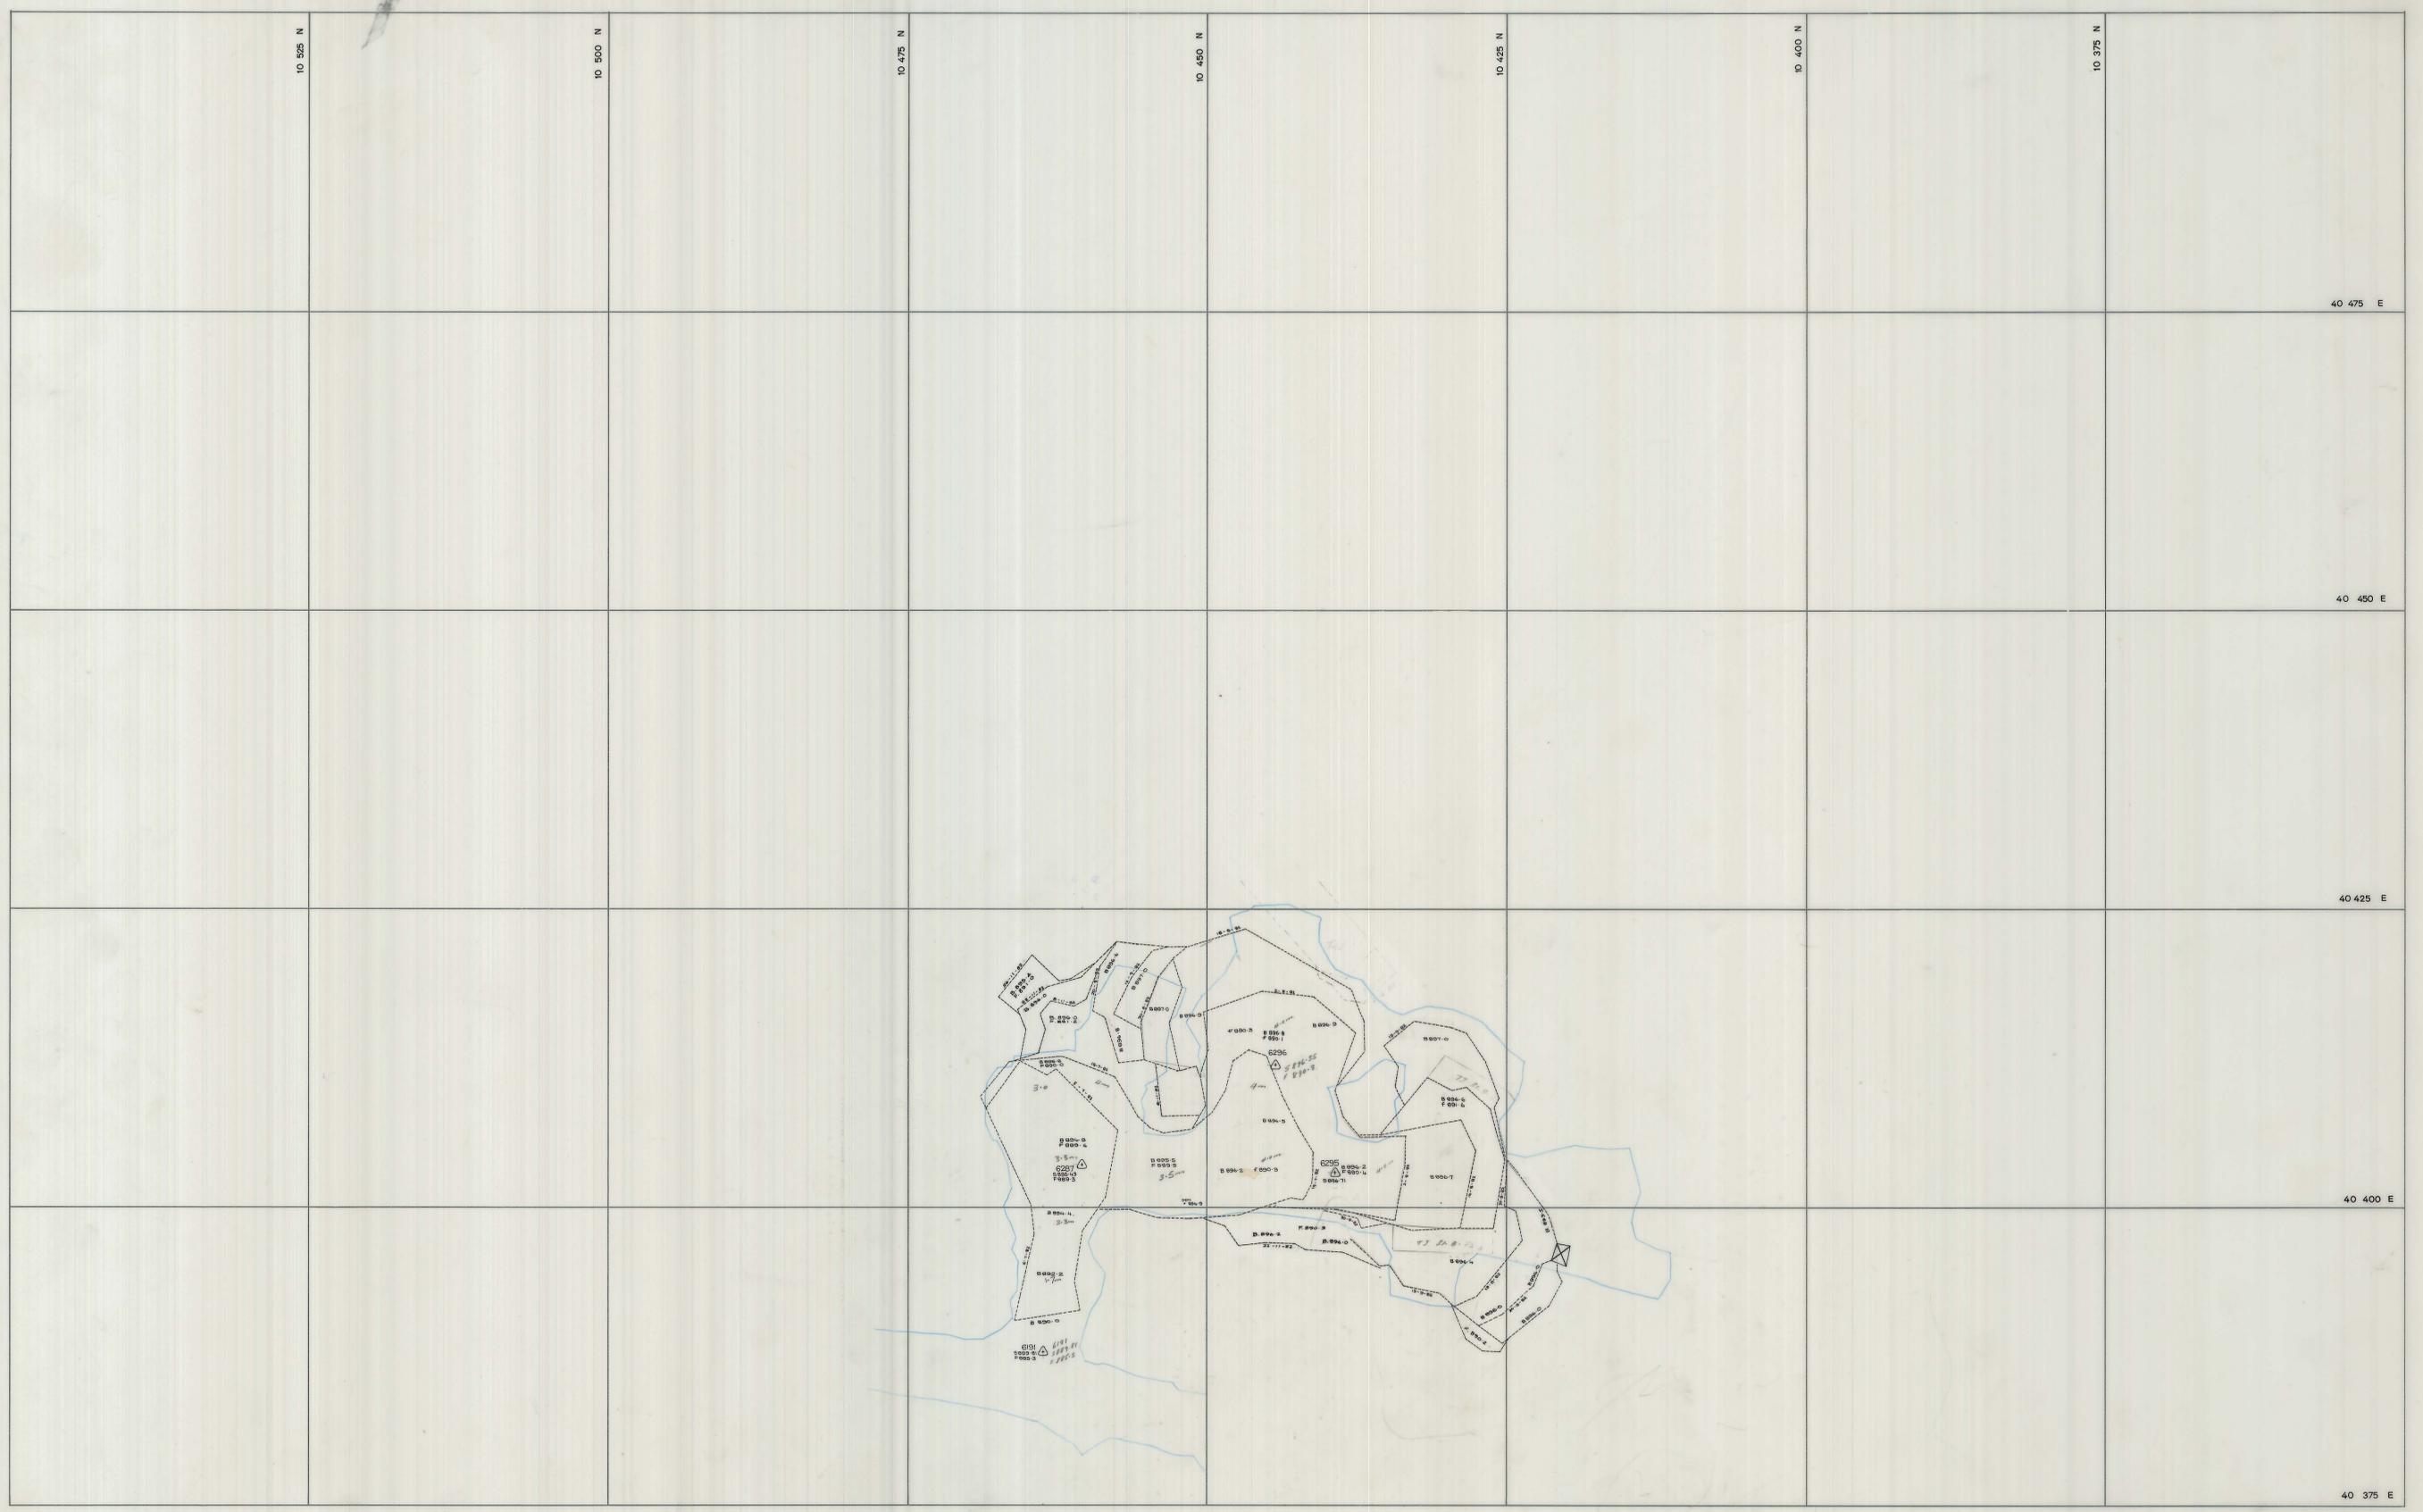

|  |              |  |   |  |
|--|--------------|--|---|--|
|  | SCALE 1: 250 |  | LOCATION<br>BOLD HEAD MINE<br><br>SUBJECT<br>P 43 STOPE<br>1st LIFT<br>P 43 STOPE<br>1st LIFT | KING ISLAND SCHEELITE<br>A DIVISION OF WARMAN INTERNATIONAL<br><br>GRASSY KING ISLAND<br>PLAN NUMBER<br>04BH13-156 249 S |
|--|--------------|--|---|--|