


04BH13 - 165 071S
 H 50
 LIFT 15
 0374_4417

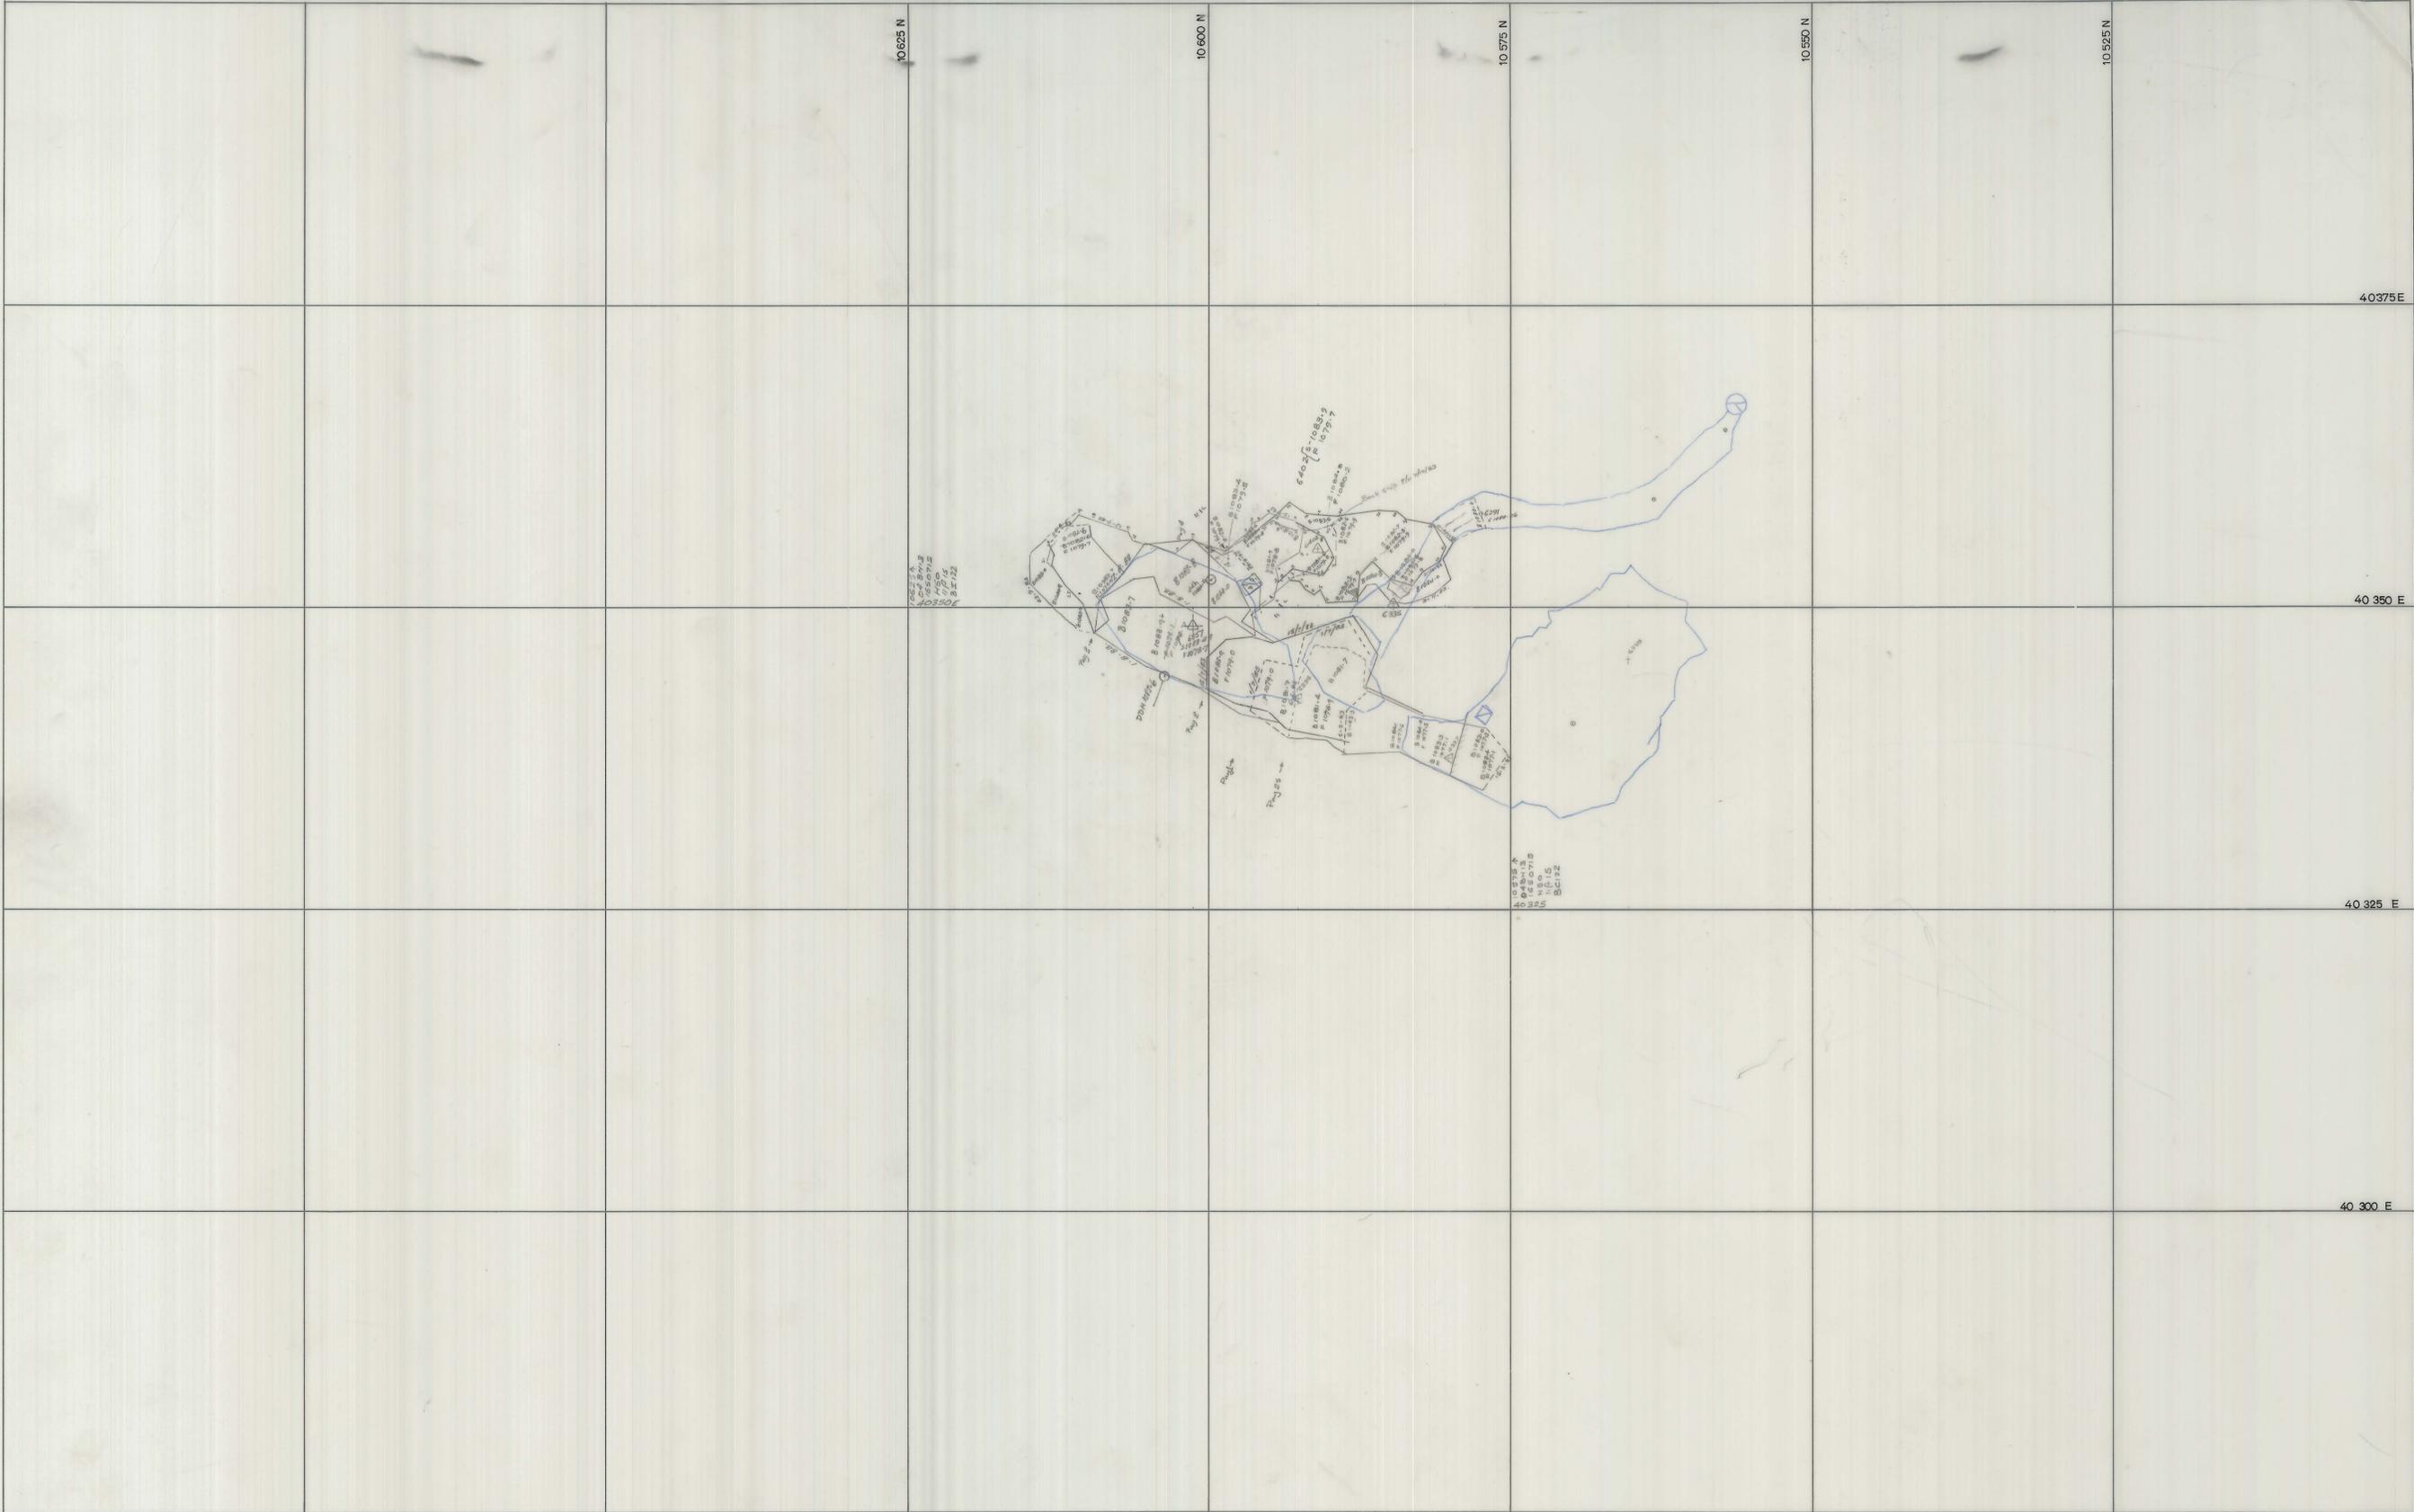

	SCALE 1:250		LOCATION BOLD HEAD MINE SUBJECT H 50 STOPE 5 A Level 15 th lift	 A DIVISION OF WARMAN INTERNATIONAL GRASSY KING ISLAND PLAN NUMBER 04BH13 - 165 071 S
--	-------------	--	--	---