


5 cm

04BH13 - 165 072 S

H50
LIFT 14

0374_4418

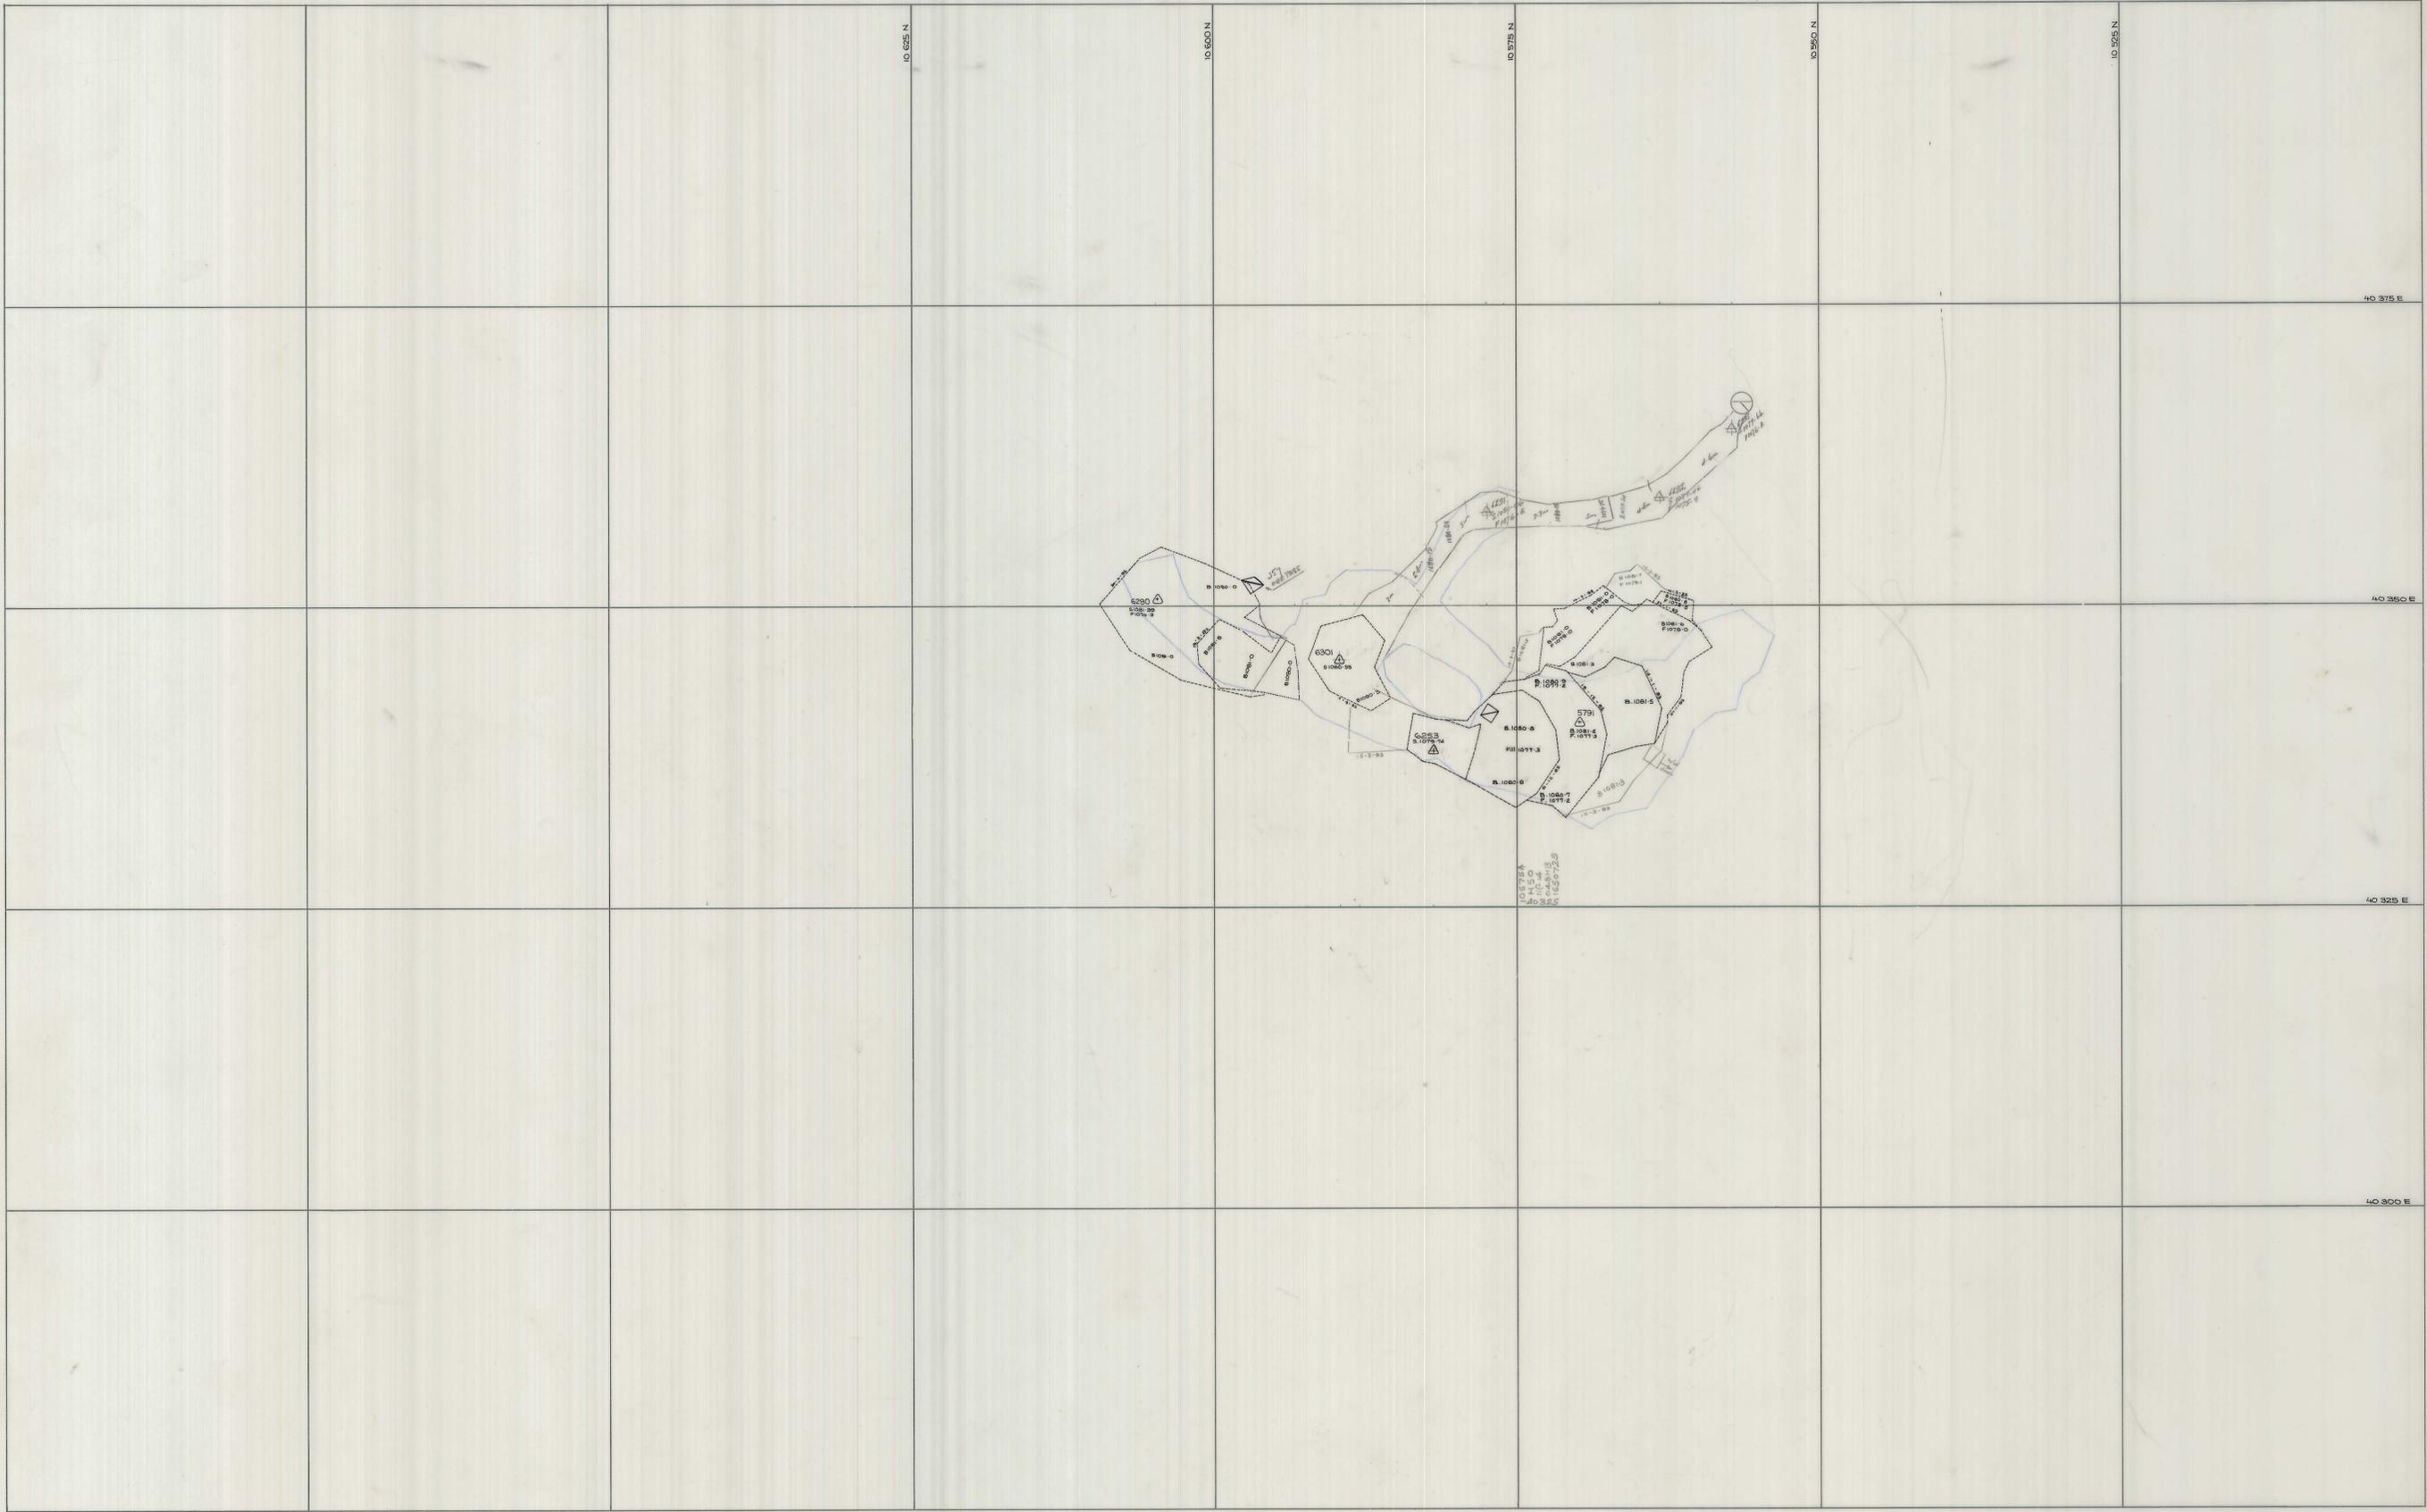

<p>SCALE 1:250</p>	<p>BSC 122</p>		<p>LOCATION BOLD HEAD MINE</p>	
<p>SUBJECT H 50 STOPE 14 th lift</p>				<p>GRASSY KING ISLAND</p>
				<p>PLAN NUMBER 04BH13 - 165 072 S</p>