


04BH13 - 156 232 S

Q52

0374_4419

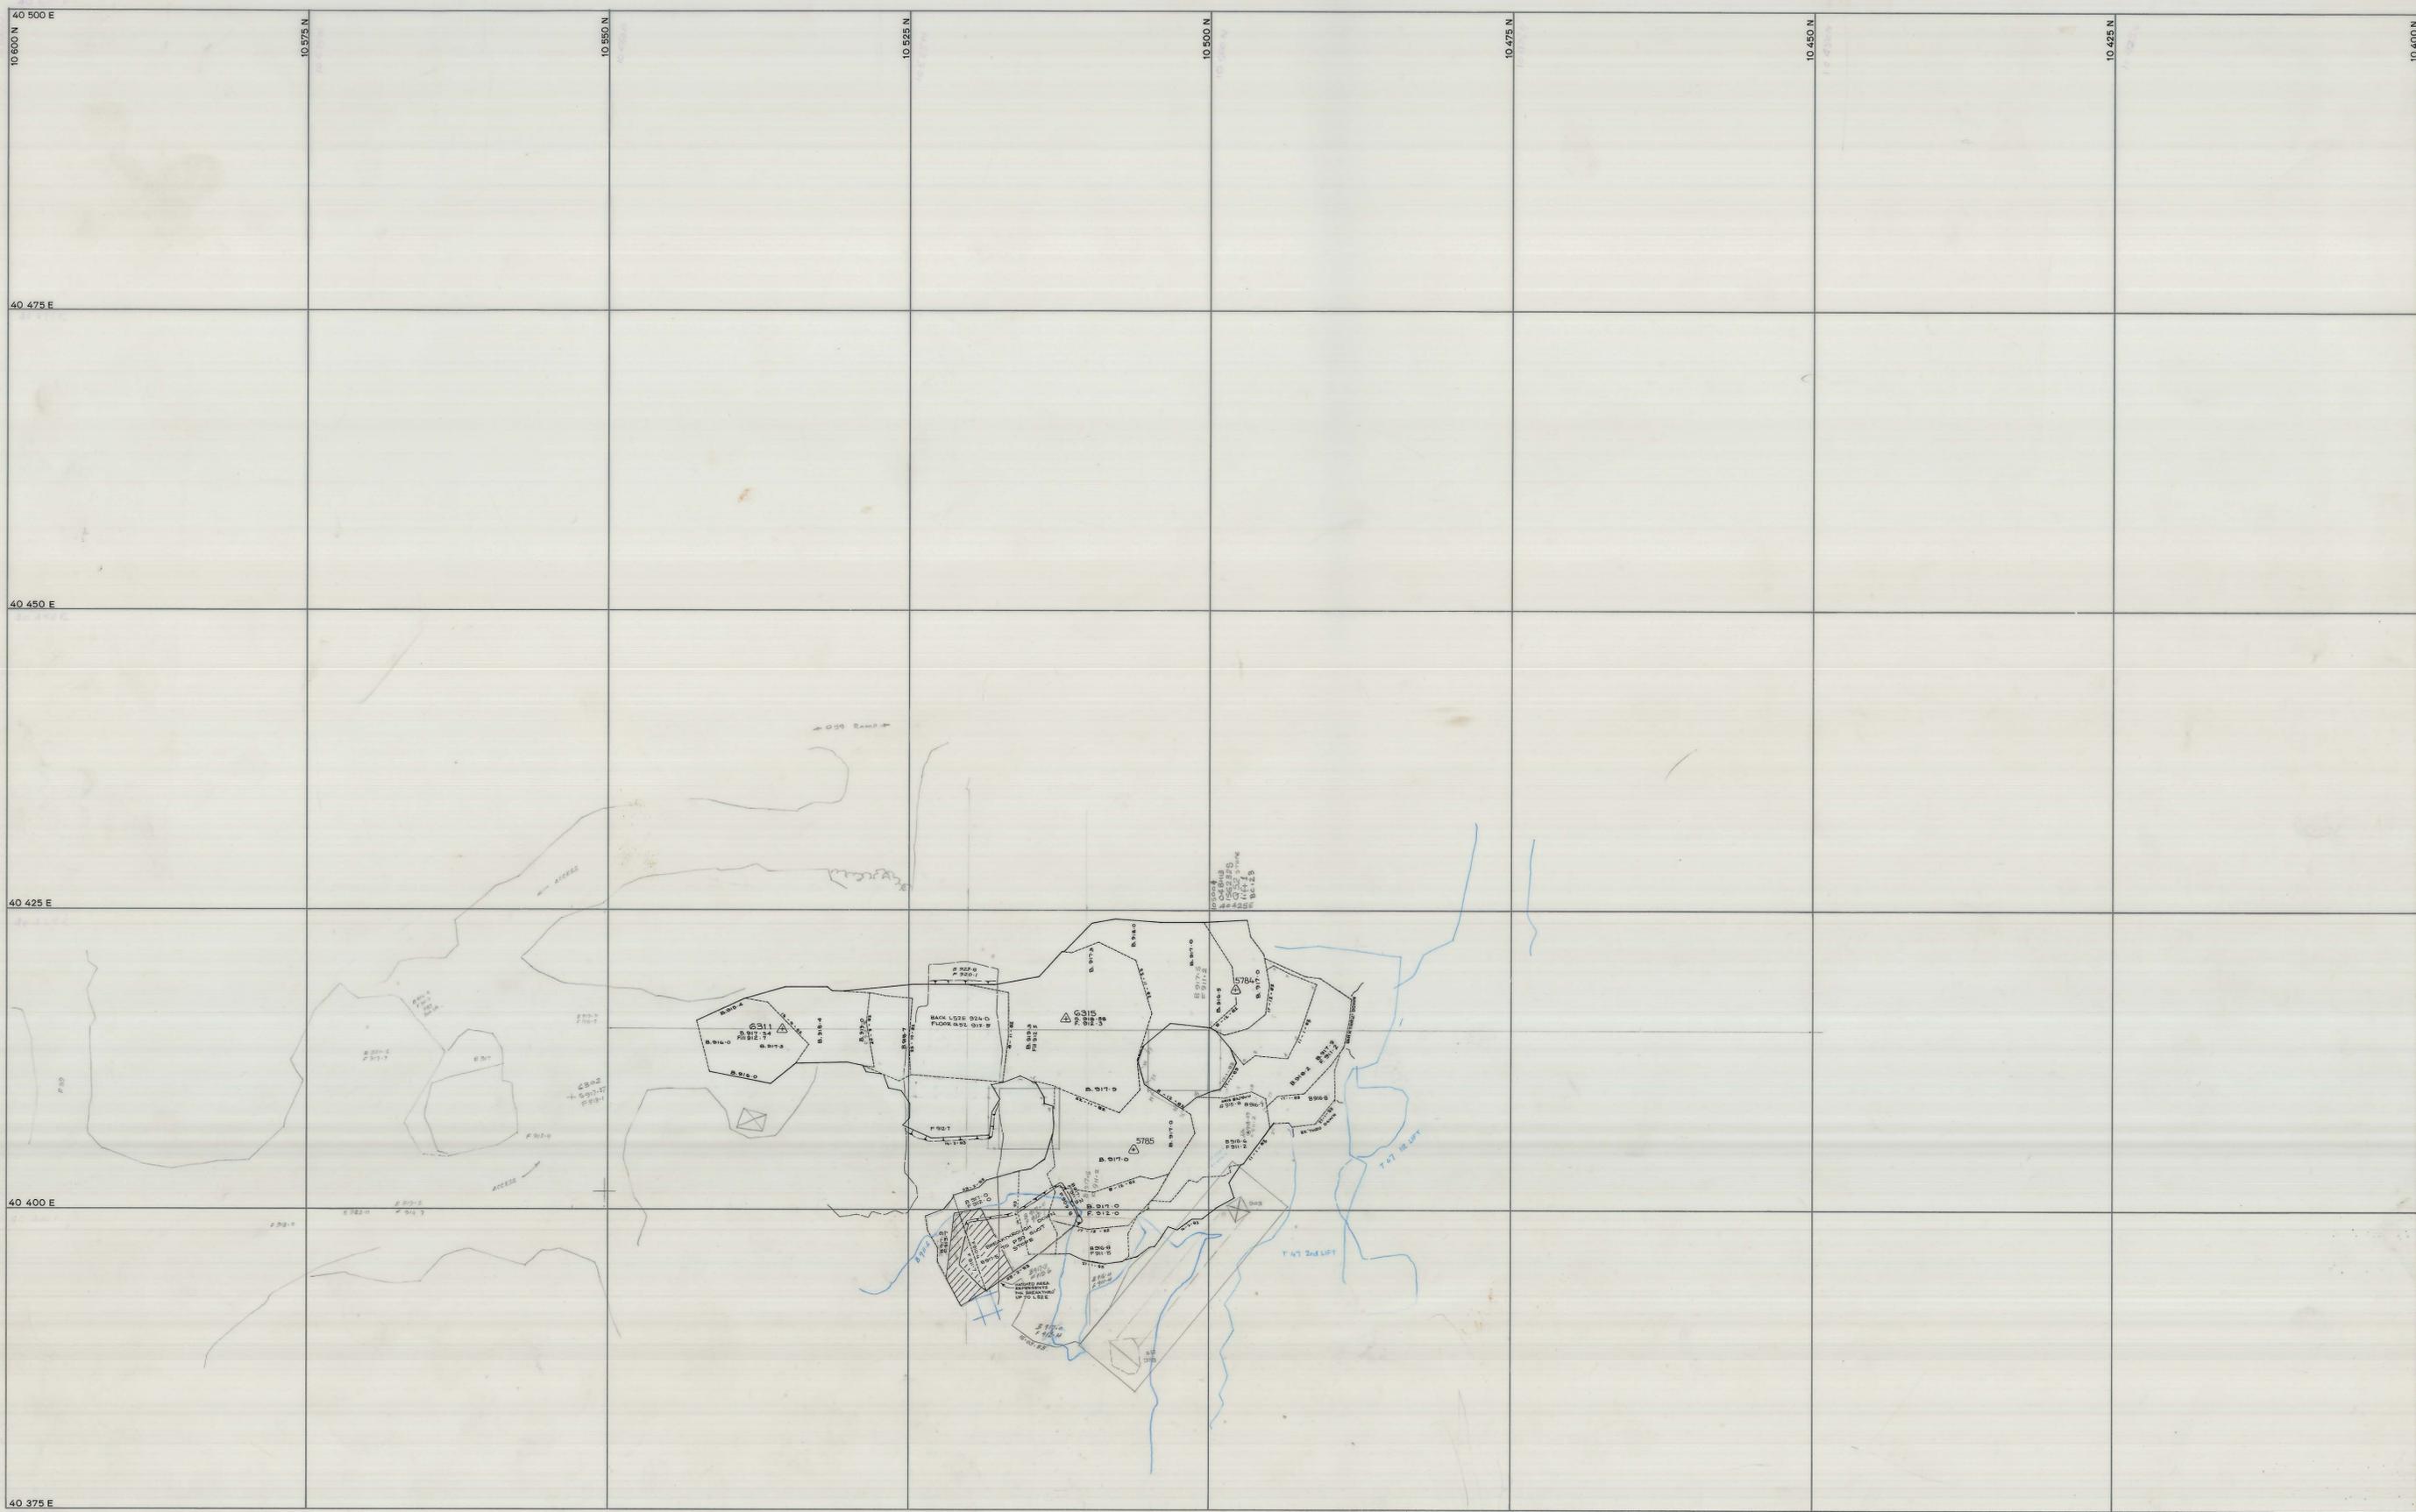

	<p>SCALE 1: 250</p>	<p>north</p>	<p>LOCATION BOLD HEAD MINE</p> <p>SUBJECT Q 52 [1st lift] T47 STOPE 4th lift</p>	<p>KING ISLAND SCHEELITE A DIVISION OF WARMAN INTERNATIONAL</p> <p>GRASSY COPPER PLAN NUMBER</p> <p>04BH13 - 156 232 S</p>
--	---------------------	--------------	--	--