
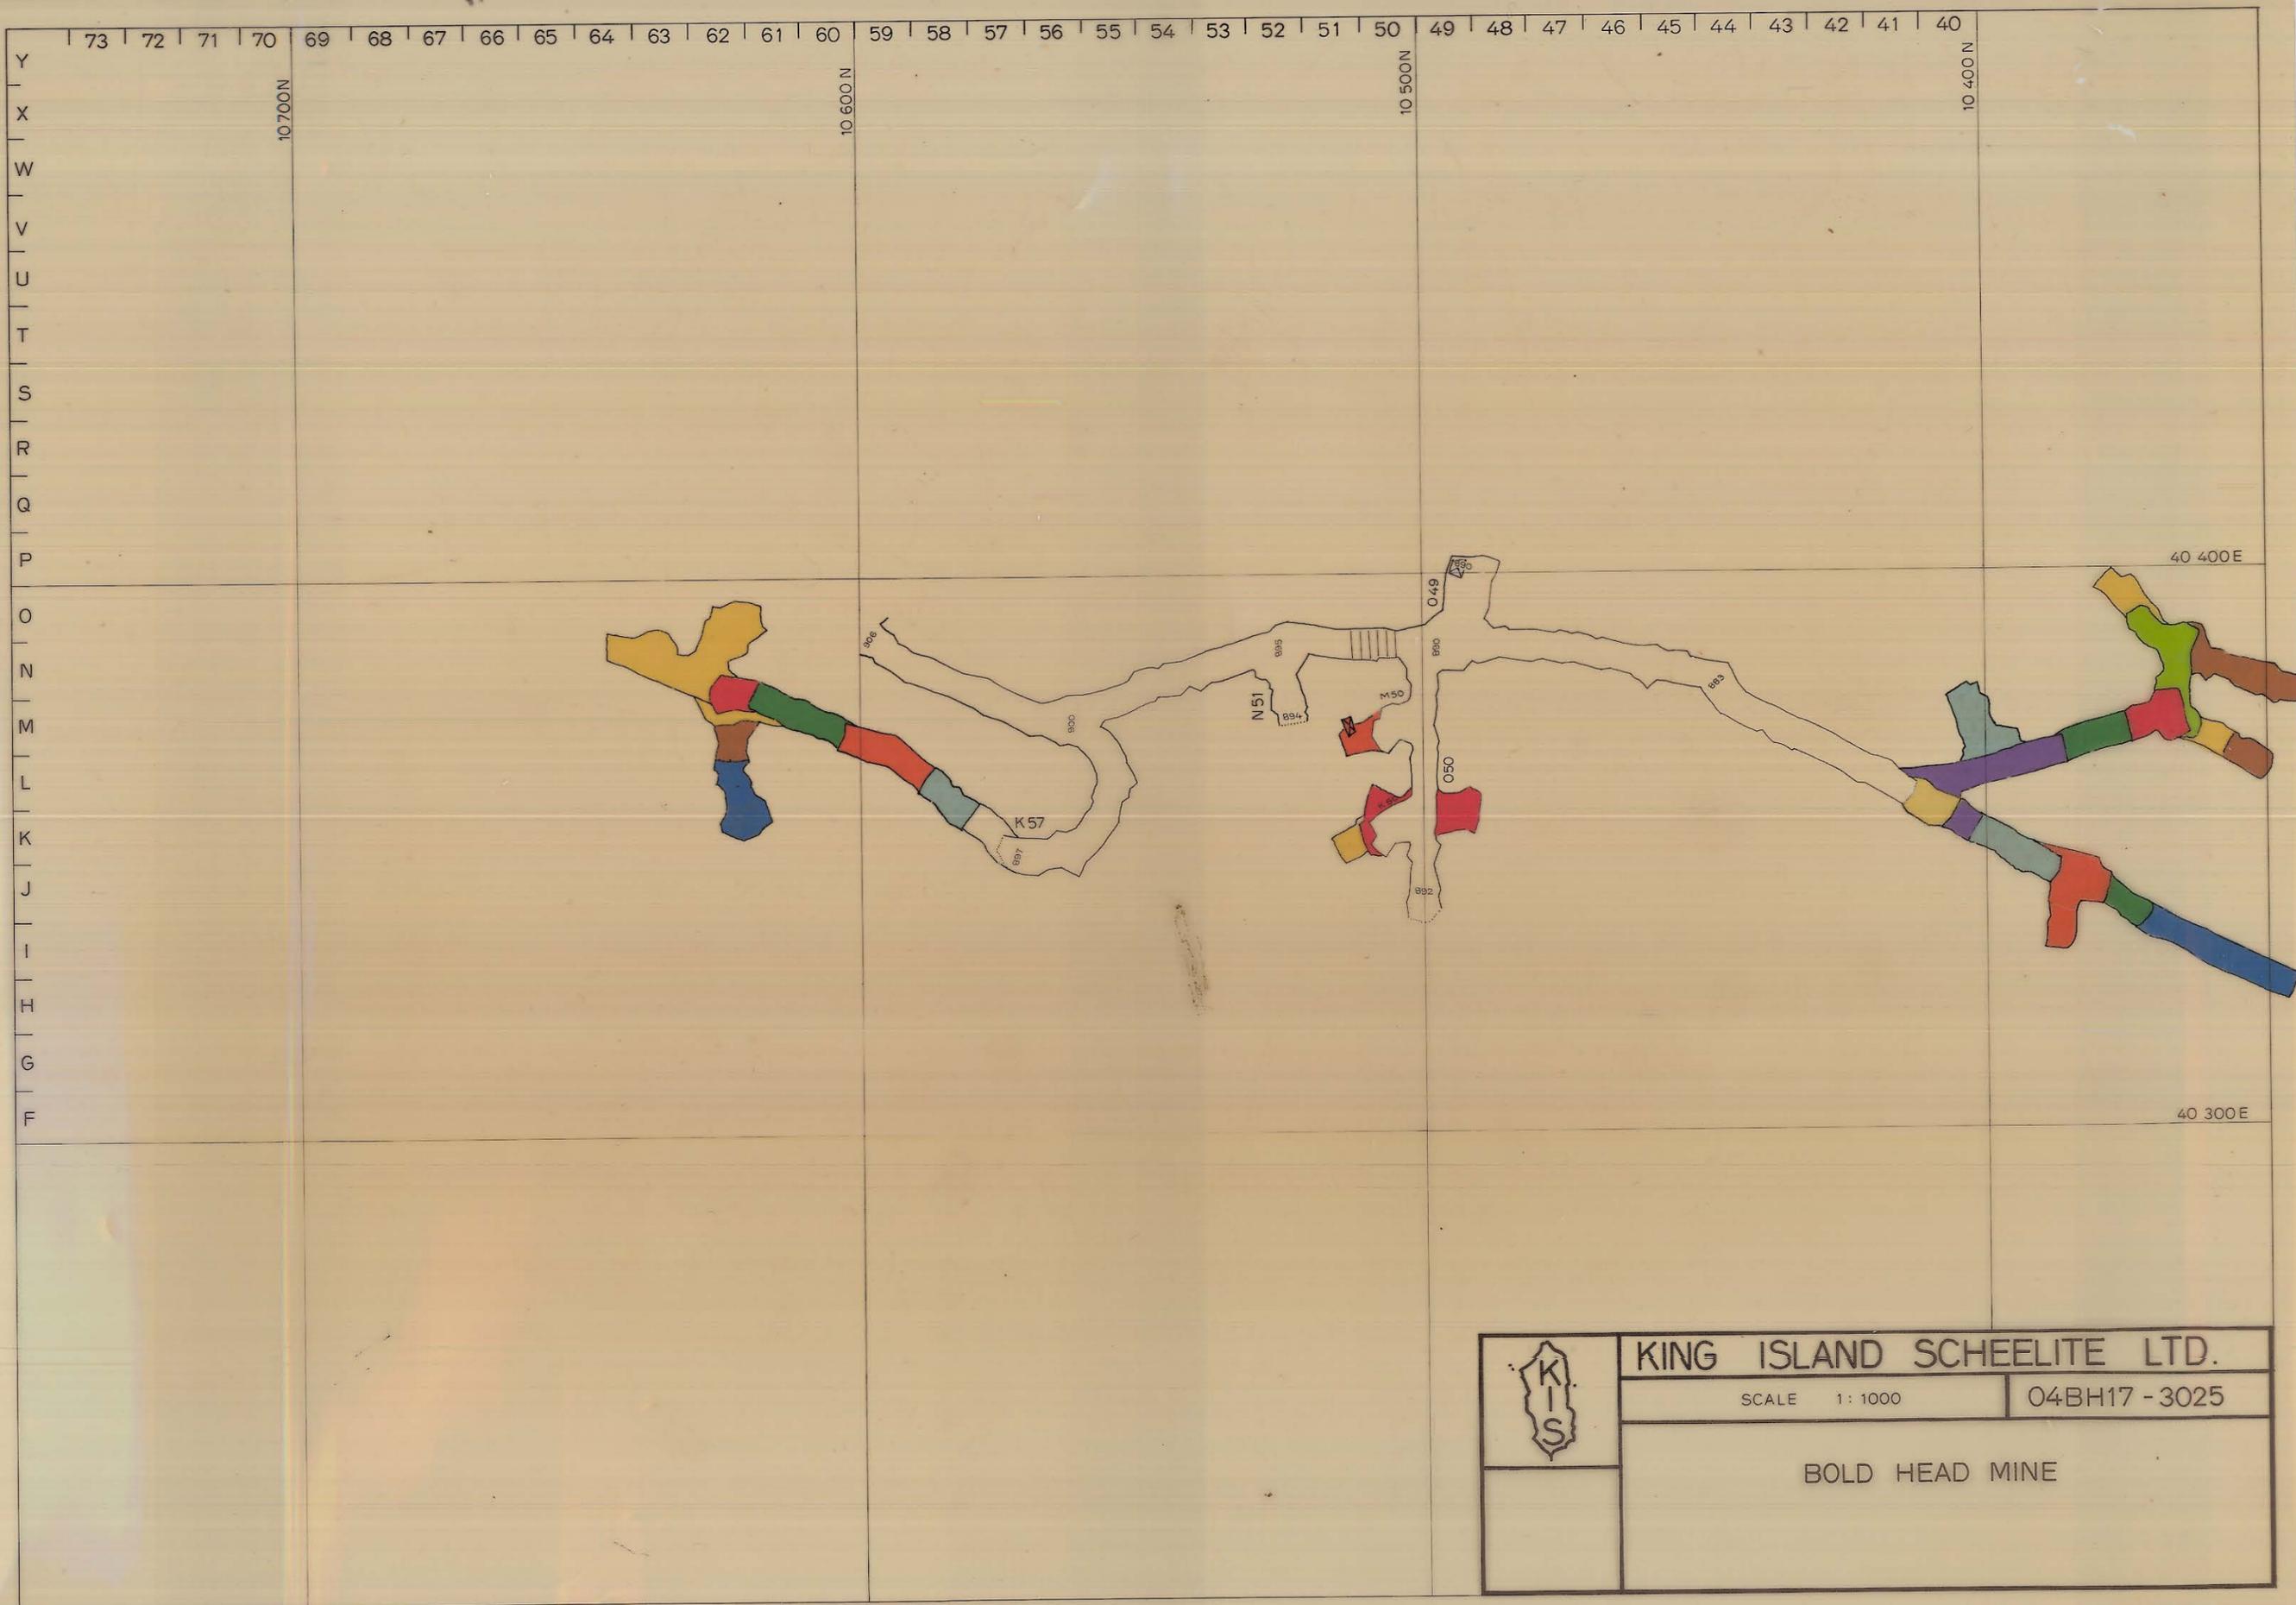


5 cm

0374_4429

1980
↓
1981

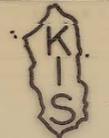

	KING ISLAND SCHEELITE LTD.	
	SCALE 1:1000	04BH17-3025
BOLD HEAD MINE		