


5 cm

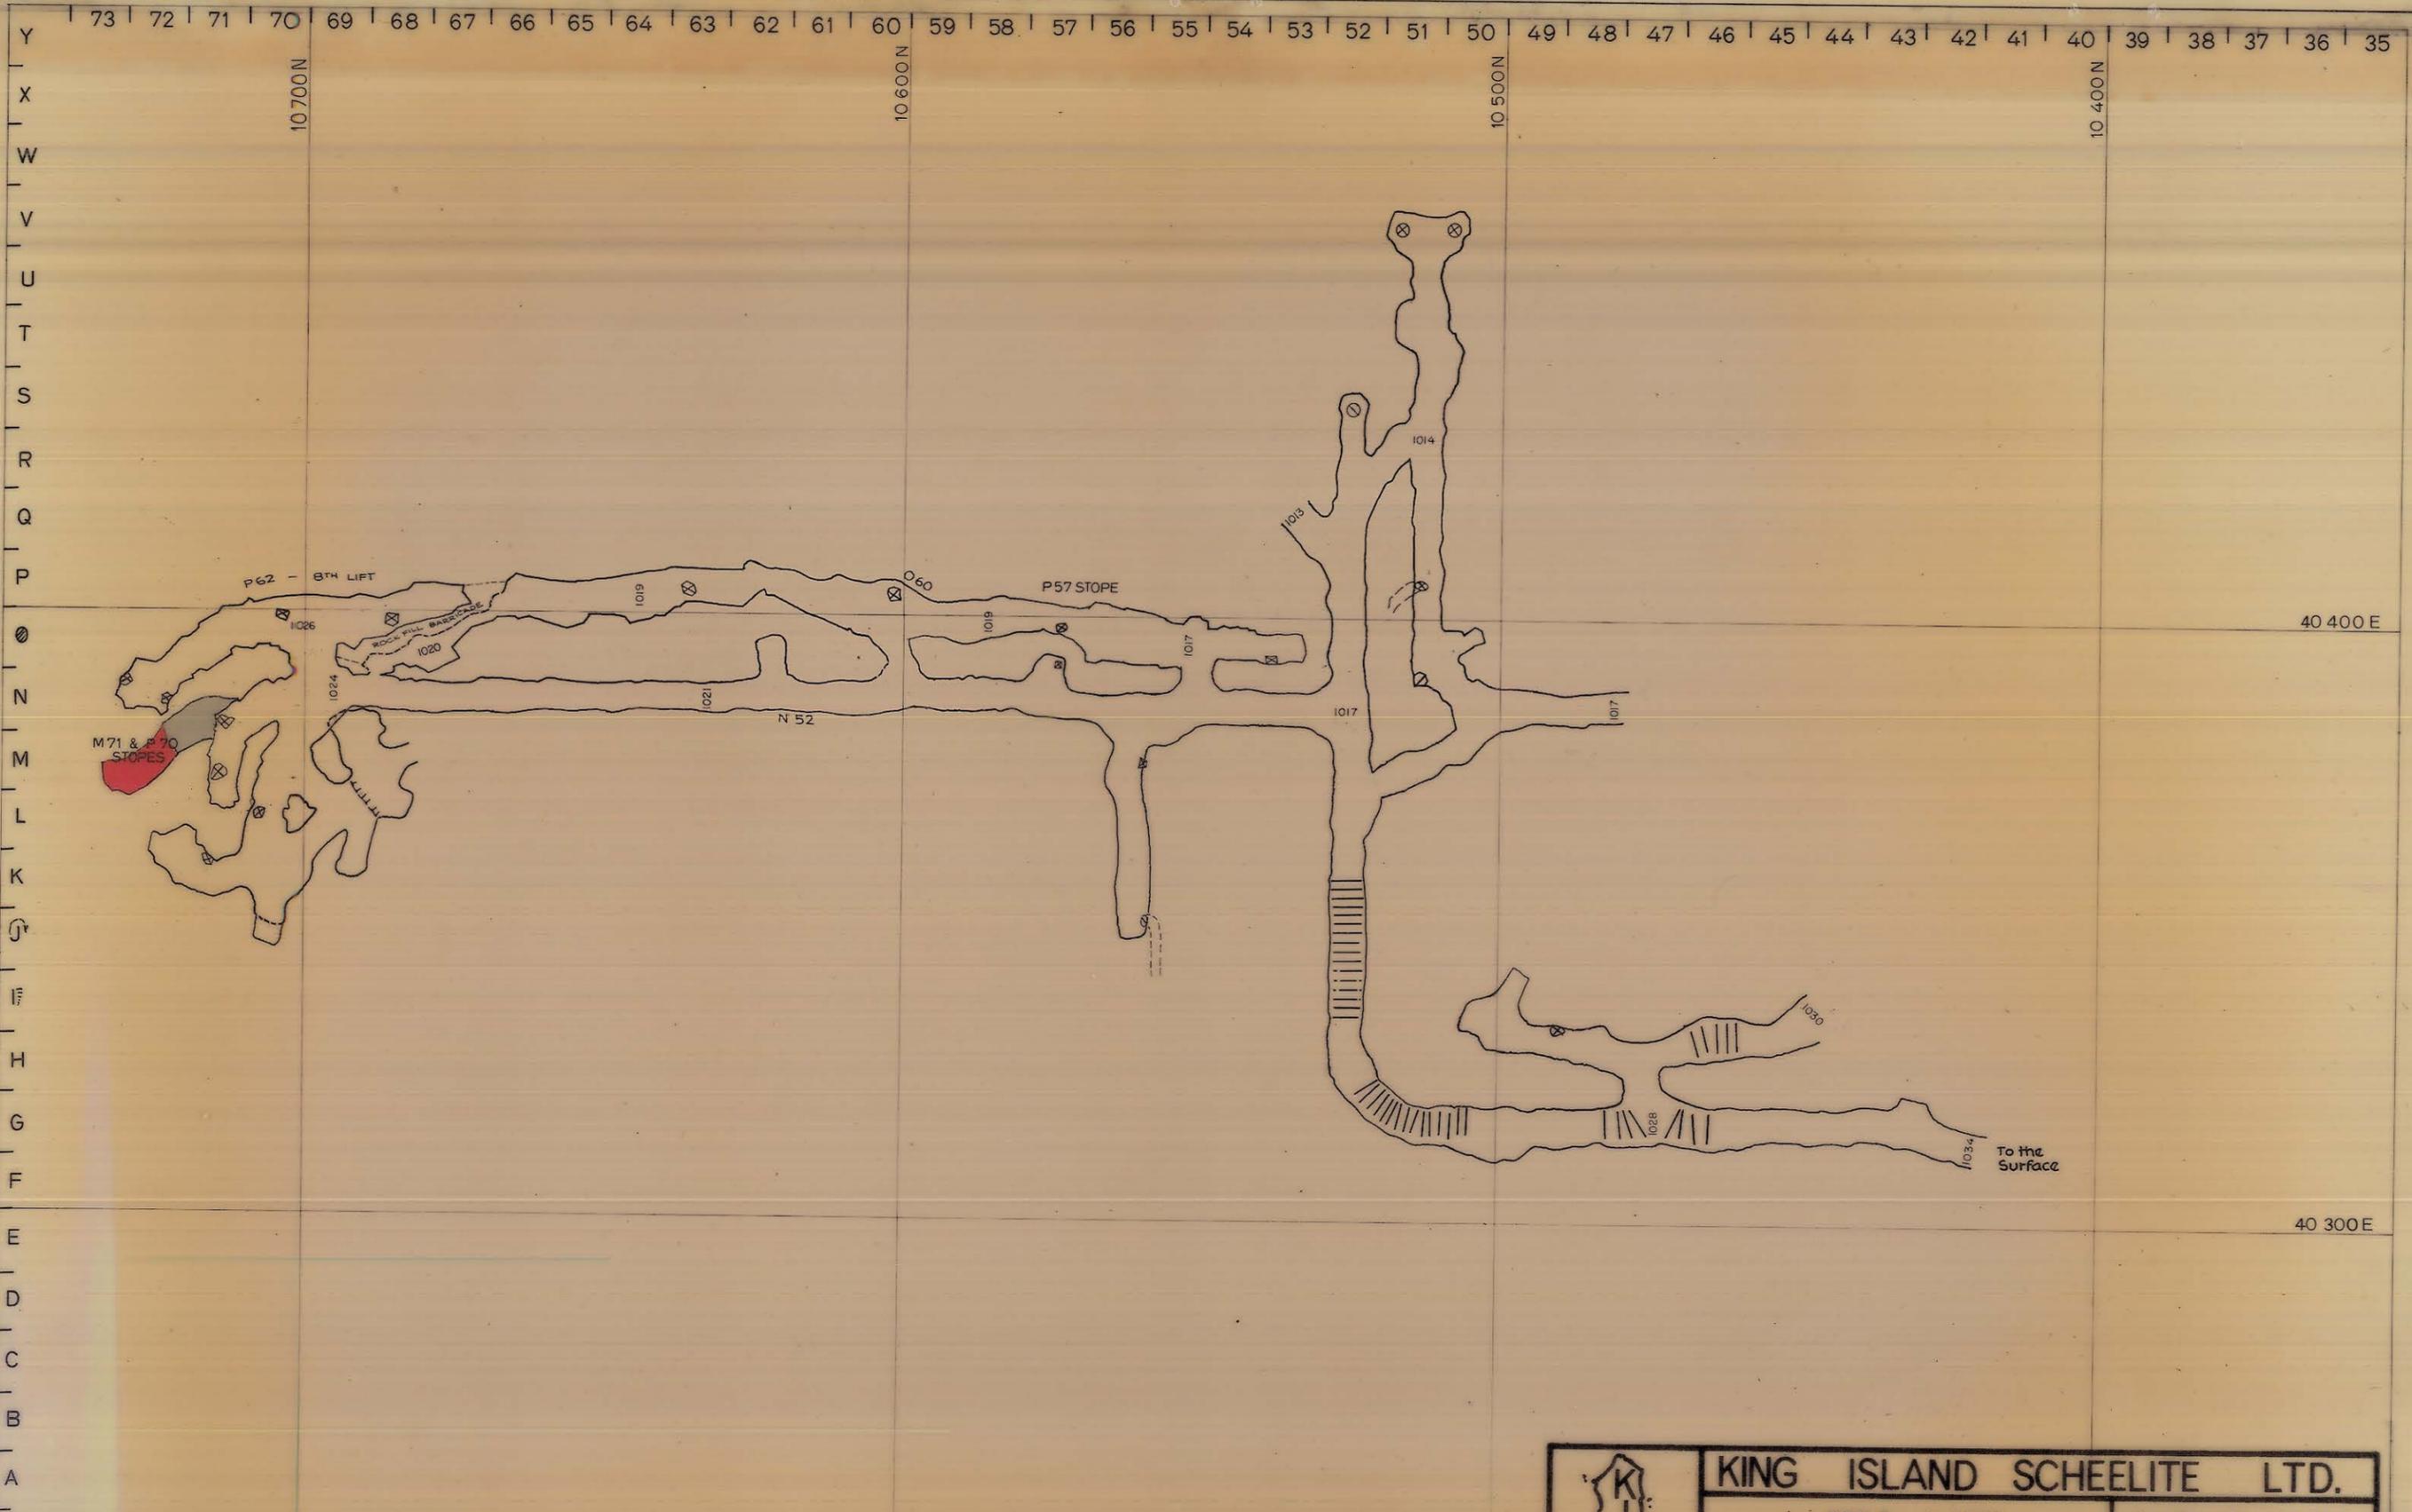

Y
X
W
V
U
T
S
R
Q
P
O
N
M
L
K
J
I
H
G
F
E
D
C
B
A

73 | 72 | 71 | 70 | 69 | 68 | 67 | 66 | 65 | 64 | 63 | 62 | 61 | 60 | 59 | 58 | 57 | 56 | 55 | 54 | 53 | 52 | 51 | 50 | 49 | 48 | 47 | 46 | 45 | 44 | 43 | 42 | 41 | 40 | 39 | 38 | 37 | 36 | 35

10700N


10600N

10500N

10400N

40 400 E

40 300 E

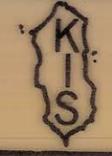	KING ISLAND SCHEELITE LTD.	
	SCALE 1:1000	O4BH17- 3003
BOLD HEAD MINE. UPPER B LENS		
.....PERIOD ending.....		
DATE		
SURVEYED		
DRAWN		
TRACED		
CHECKED		