
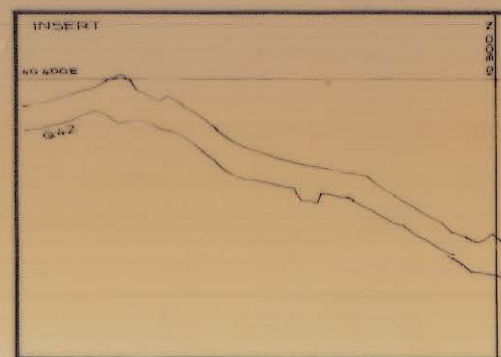


5 cm

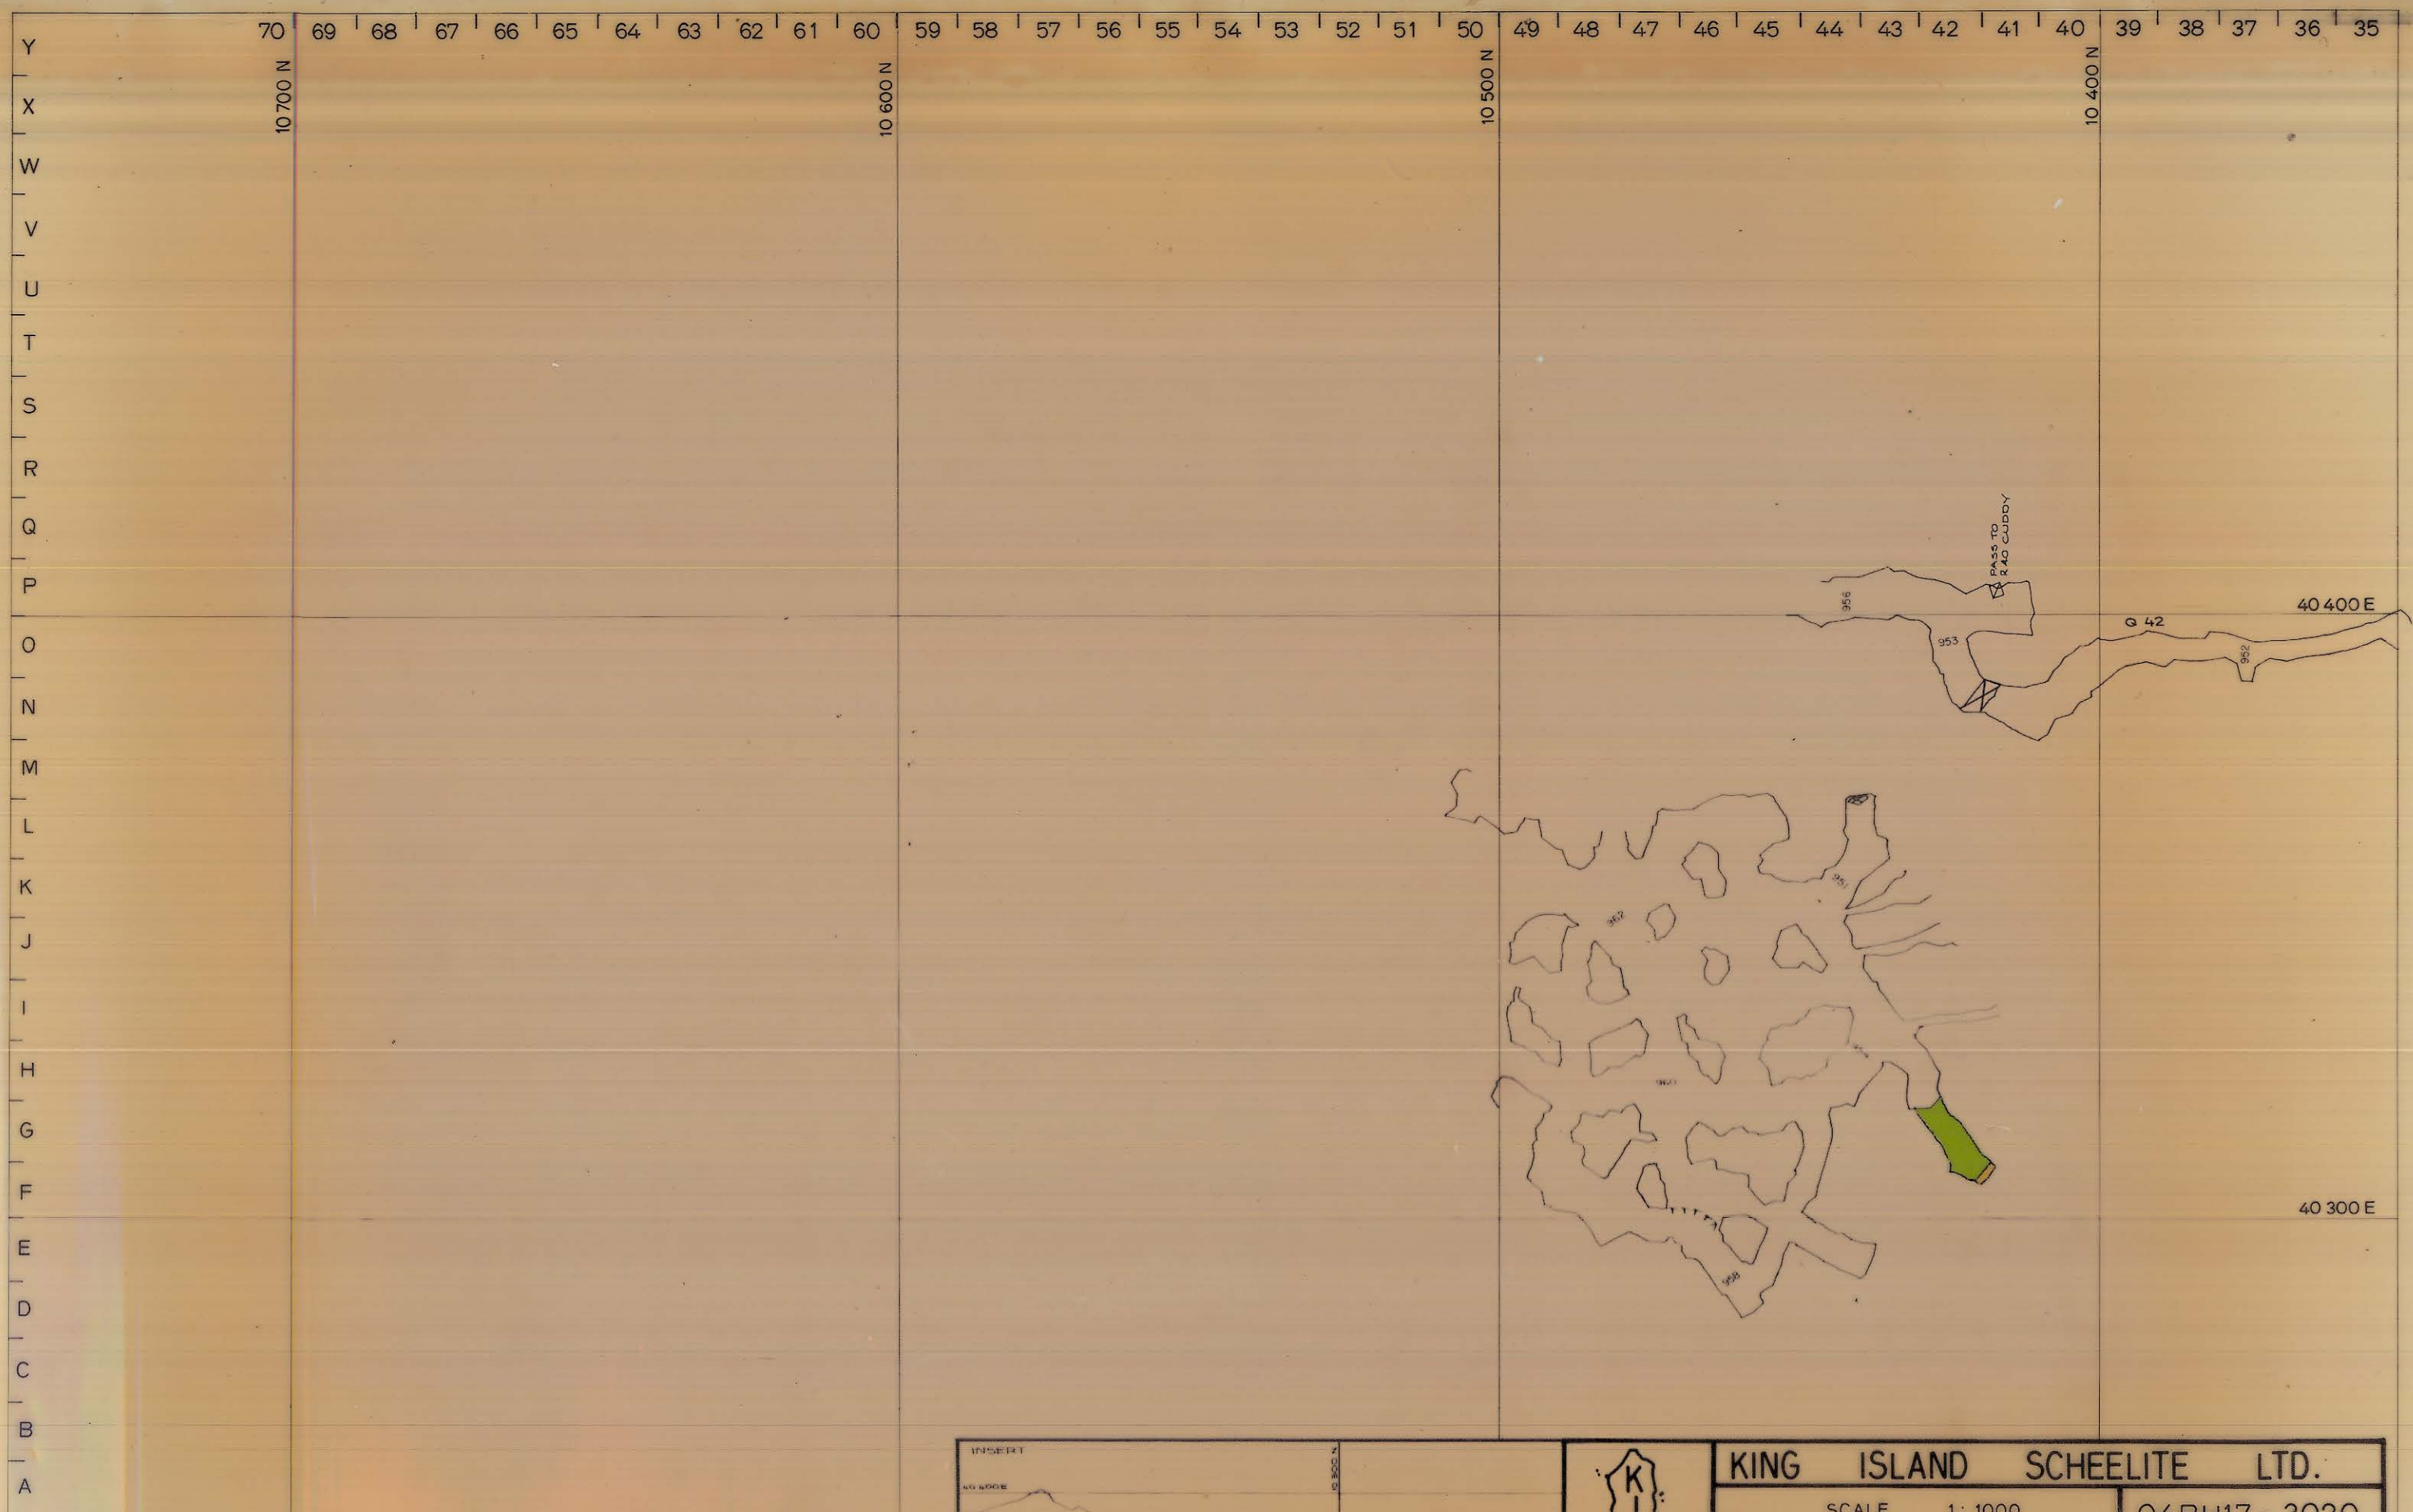

KING ISLAND SCHEELITE LTD.	
SCALE 1: 1000	04BH17 - 3020
BOLD HEAD MINE	
B' LENS MAIN SOUTH & FAULT BLOCK	
DATE	PERIOD ending
SURVEYED	
DRAWN EJC	
TRACED	
CHECKED	