


0374_4437

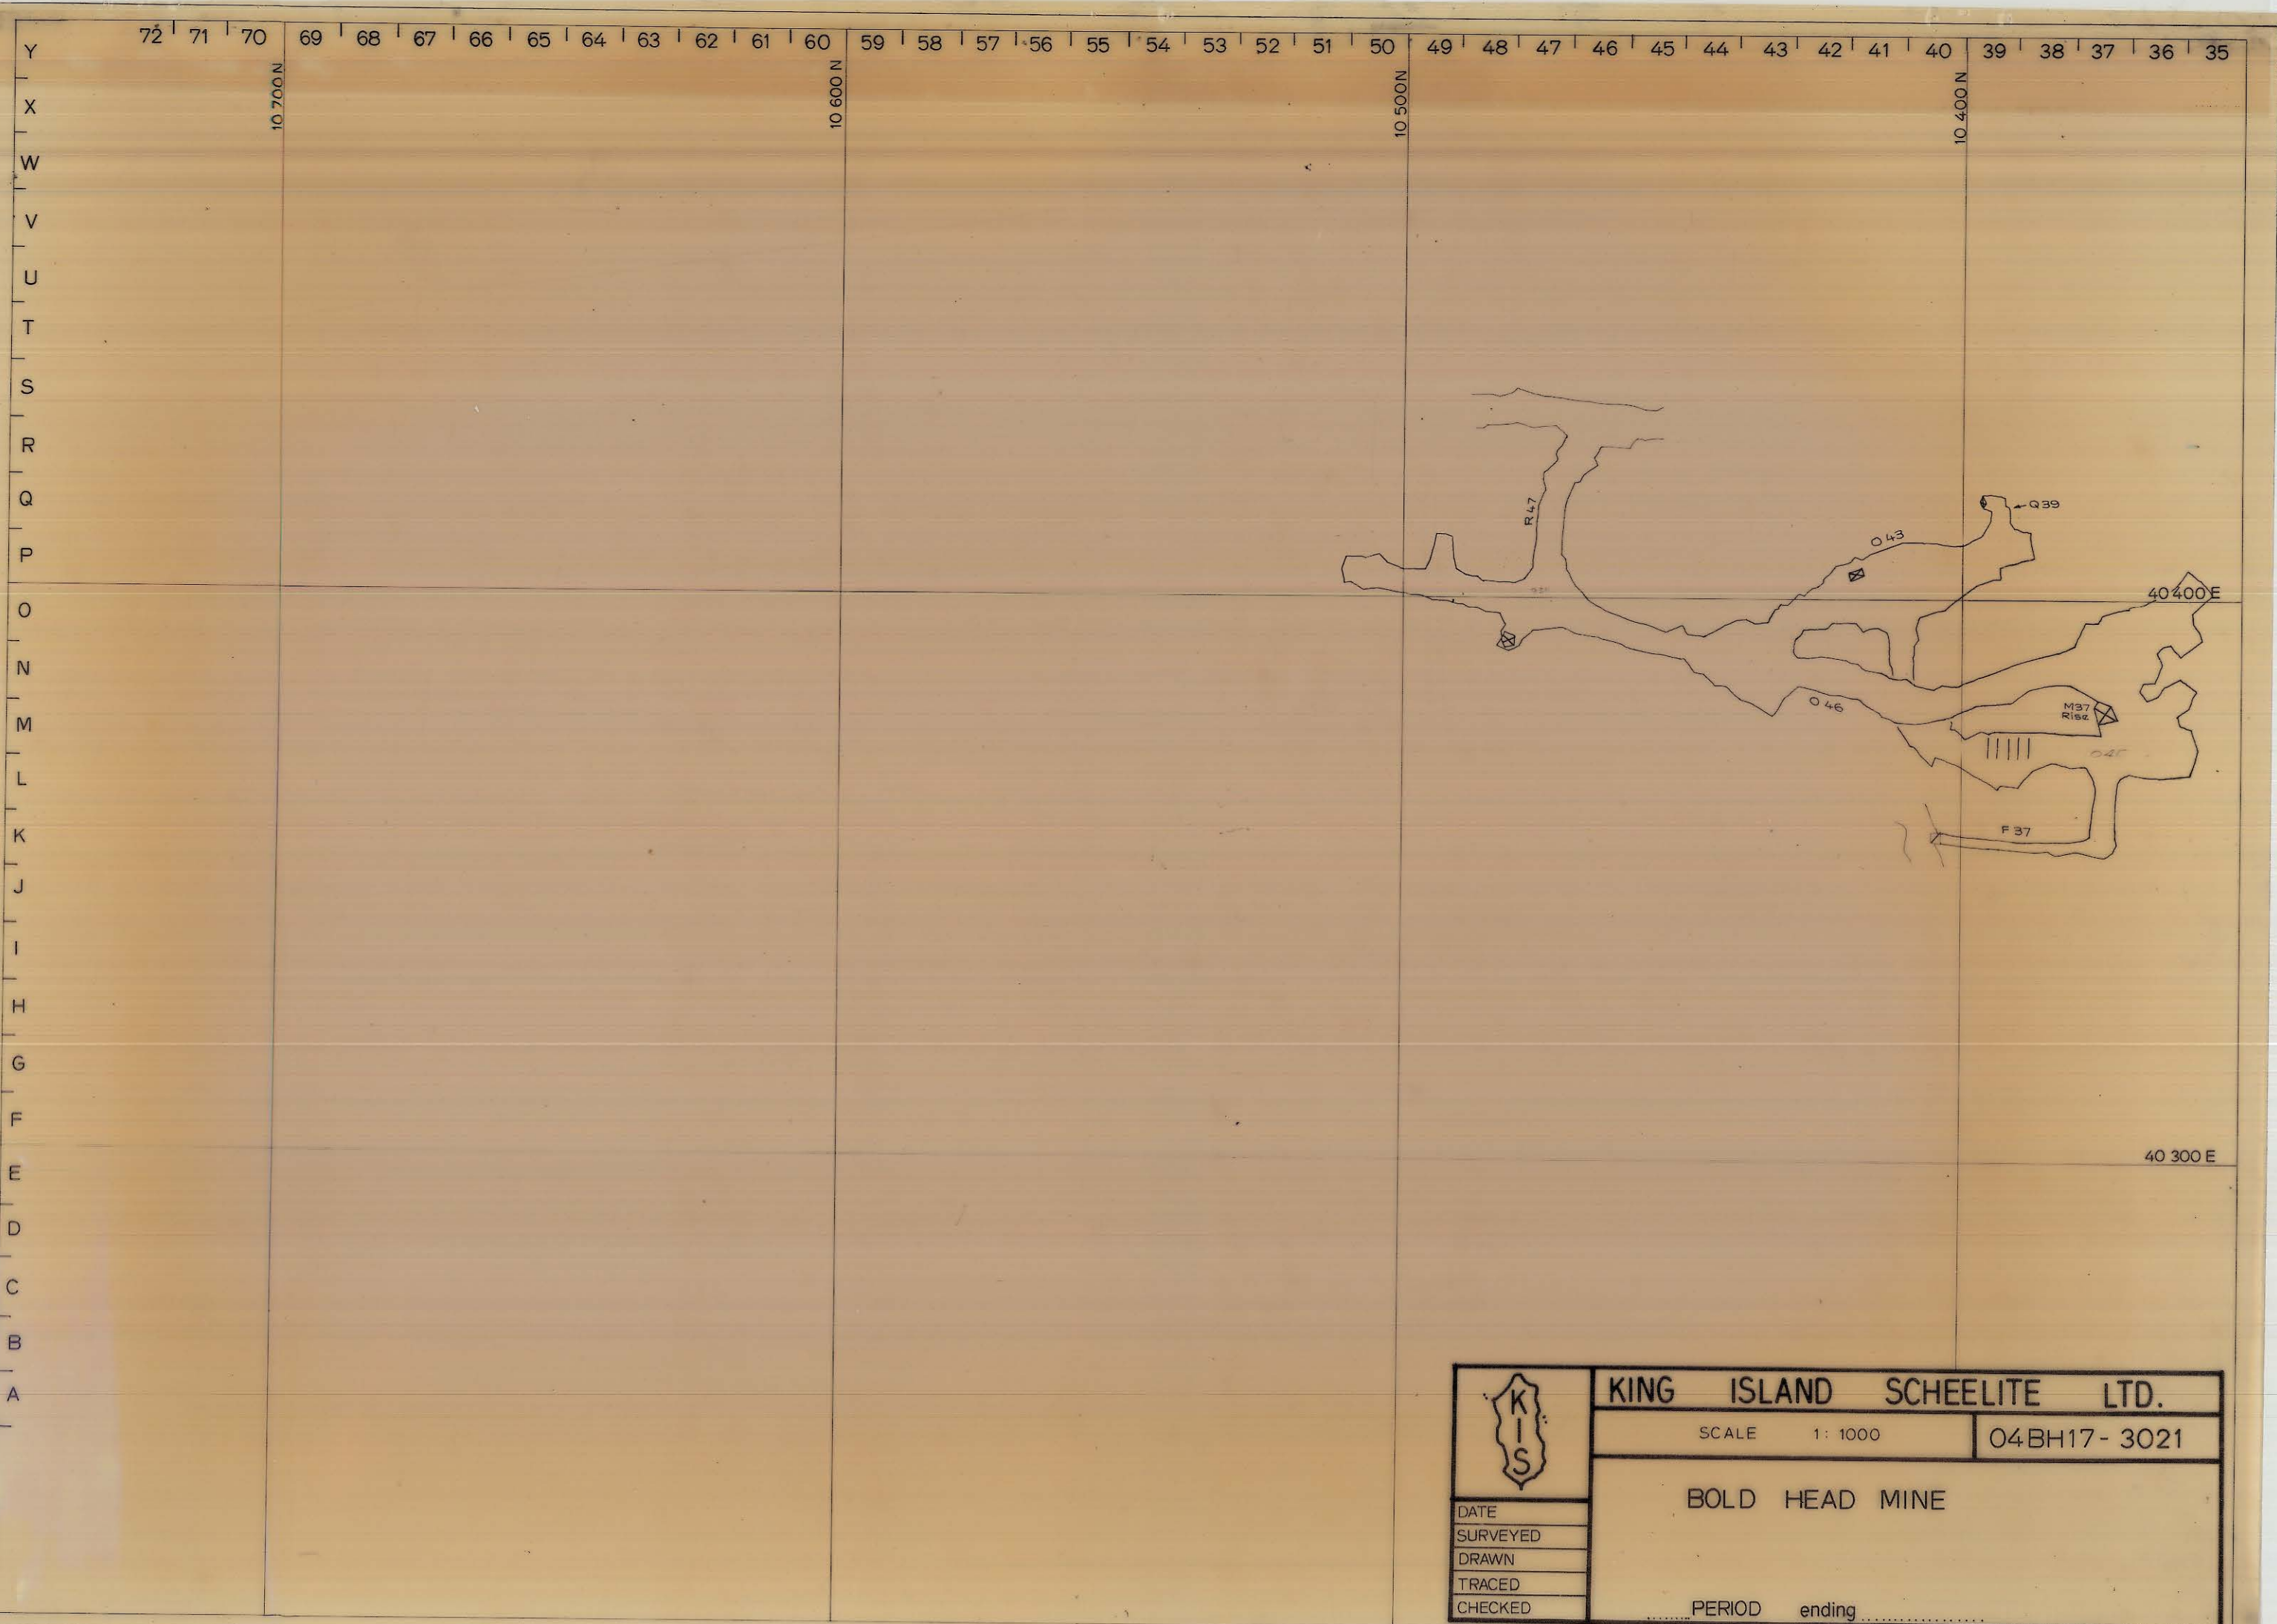

	KING ISLAND SCHEELITE LTD.	
	SCALE 1: 1000	04BH17- 3021
	BOLD HEAD MINE	
	PERIOD ending	
	DATE	
SURVEYED		
DRAWN		
TRACED		
CHECKED		