


5 cm

73 72 71 70 69 68 67 66 65 64 63 62 61 60 59 58 57 56 55 54 53 52 51 50 49 48 47 46 45 44 43 42 41 40

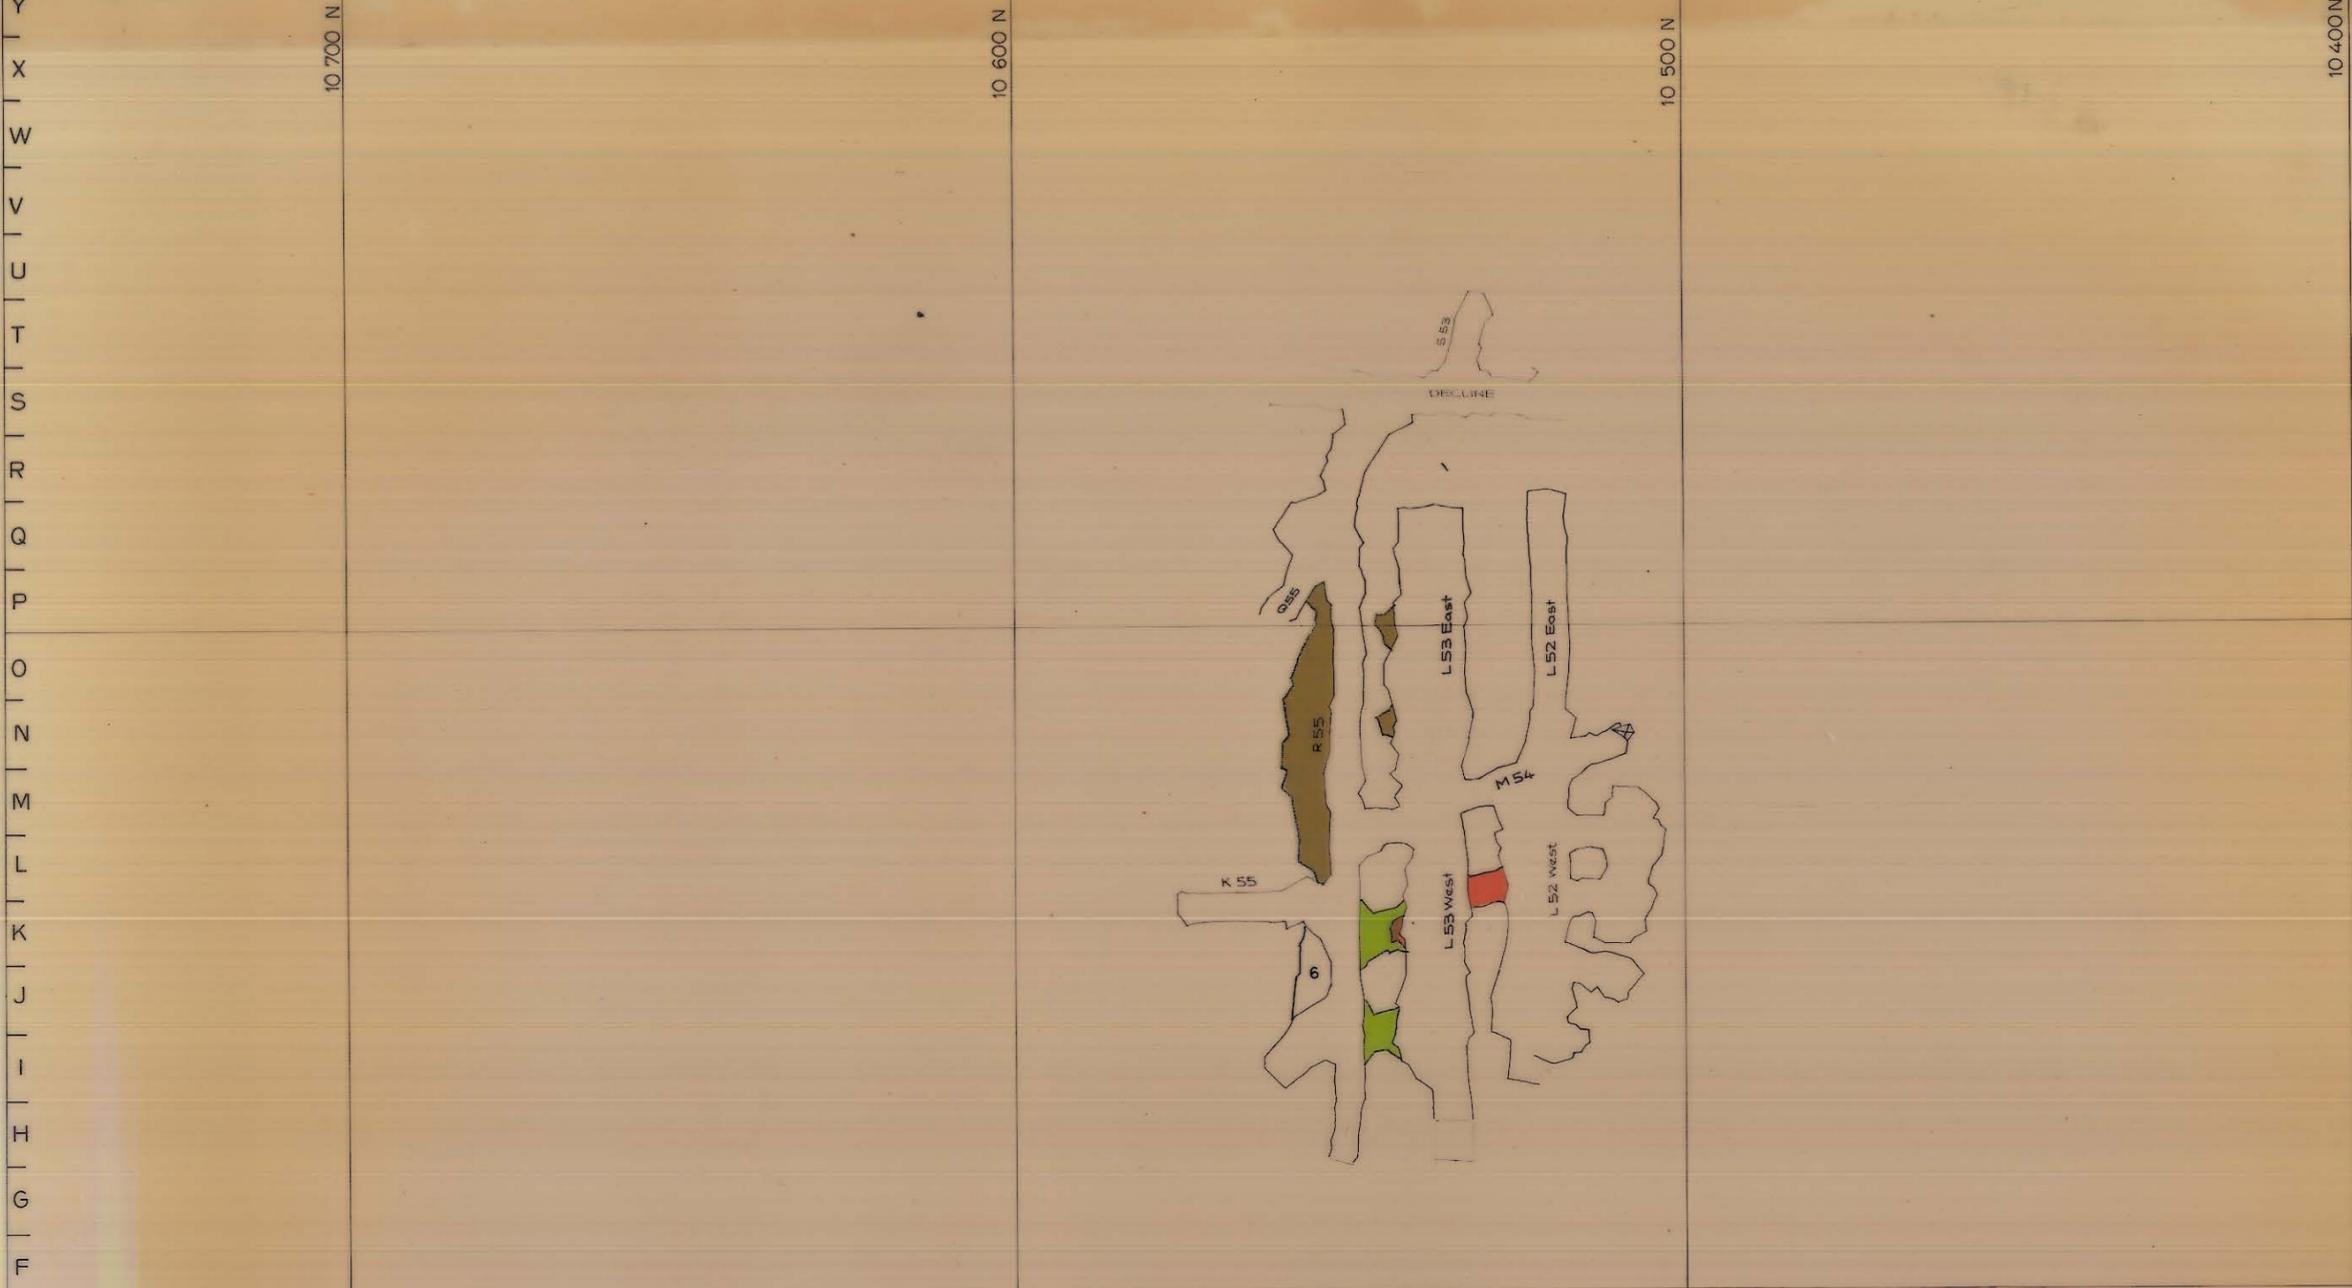

40 400E

40 300E

Y
X
W
V
U
T
S
R
Q
P
O
N
M
L
K
J
I
H
G
F

10 700 N

10 600 N

10 500 N

10 400 N

	KING ISLAND SCHEELITE LTD.	
	SCALE 1: 1000	04BH17 - 3022
BOLD HEAD MINE		