



0374-444

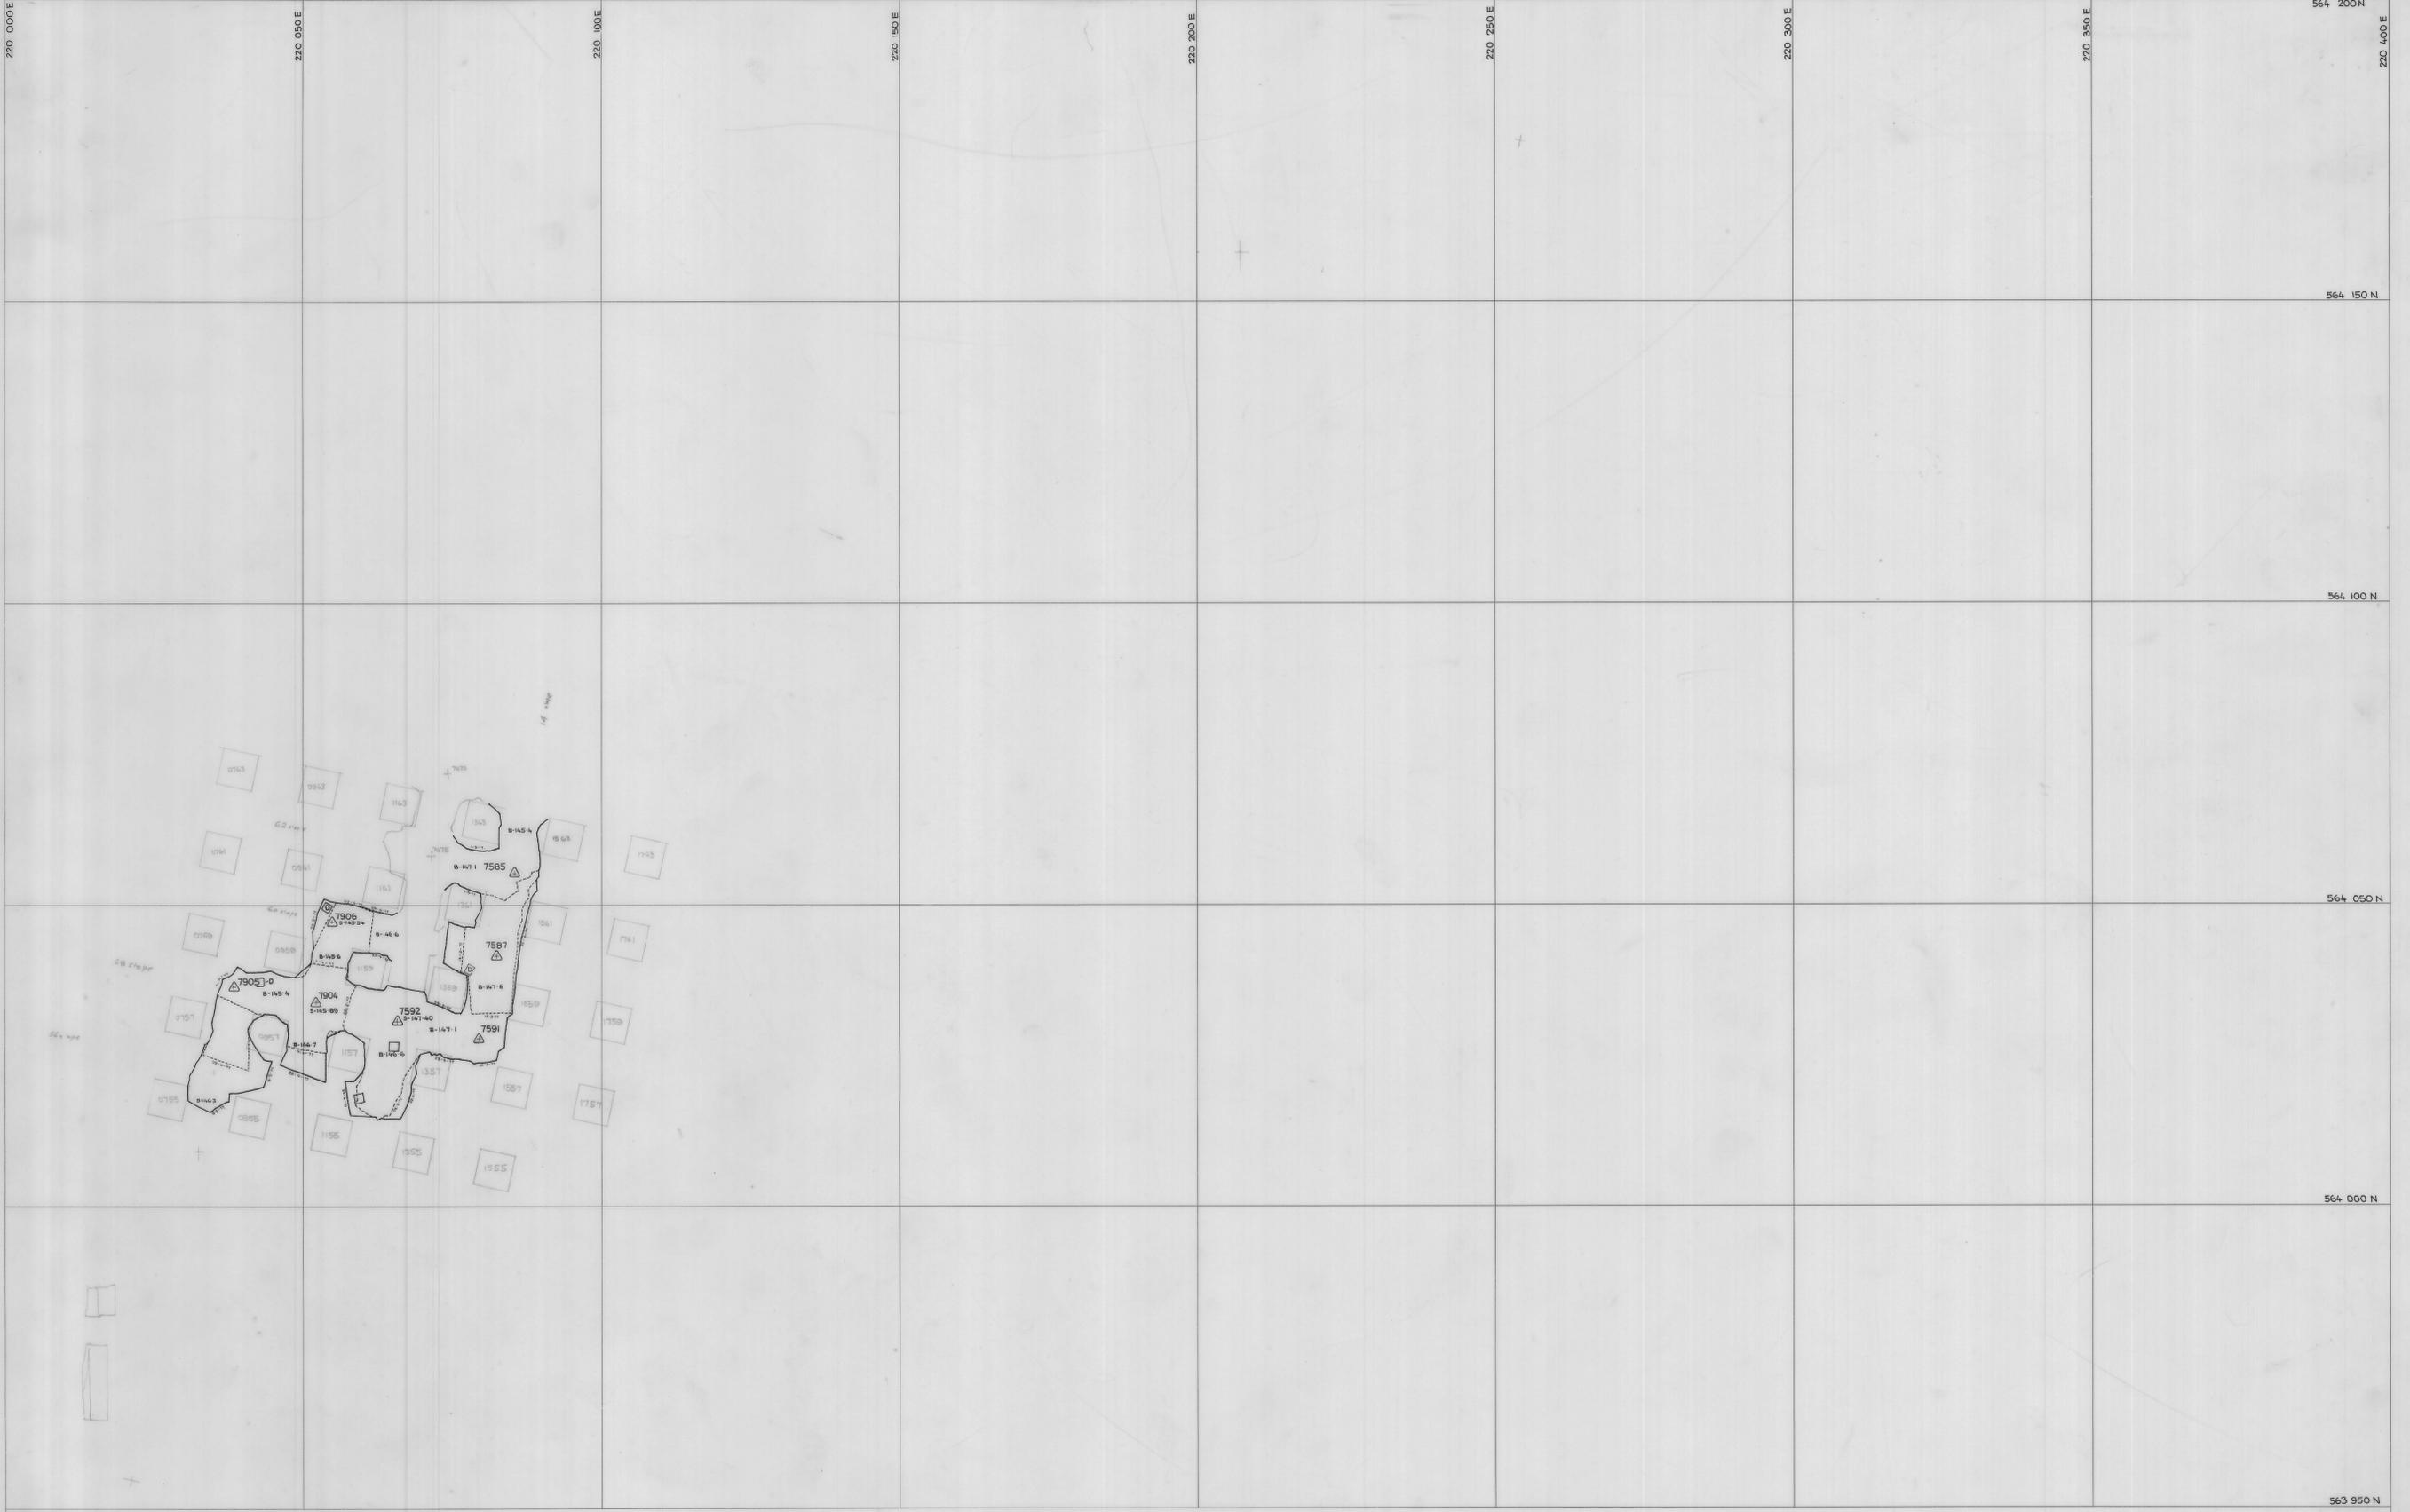

SCALE 1:500

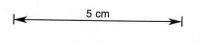

north

LOCATION

DOLPHIN MINE

SUBJECT

C PIT

- 150.5m CONTOUR

**KIS** KING ISLAND SCHEELITE  
A DIVISION OF KENNEDY INTERNATIONAL

GRASSY KING ISLAND

PLAN NUMBER

04DM15 - 1031