


0374_4444

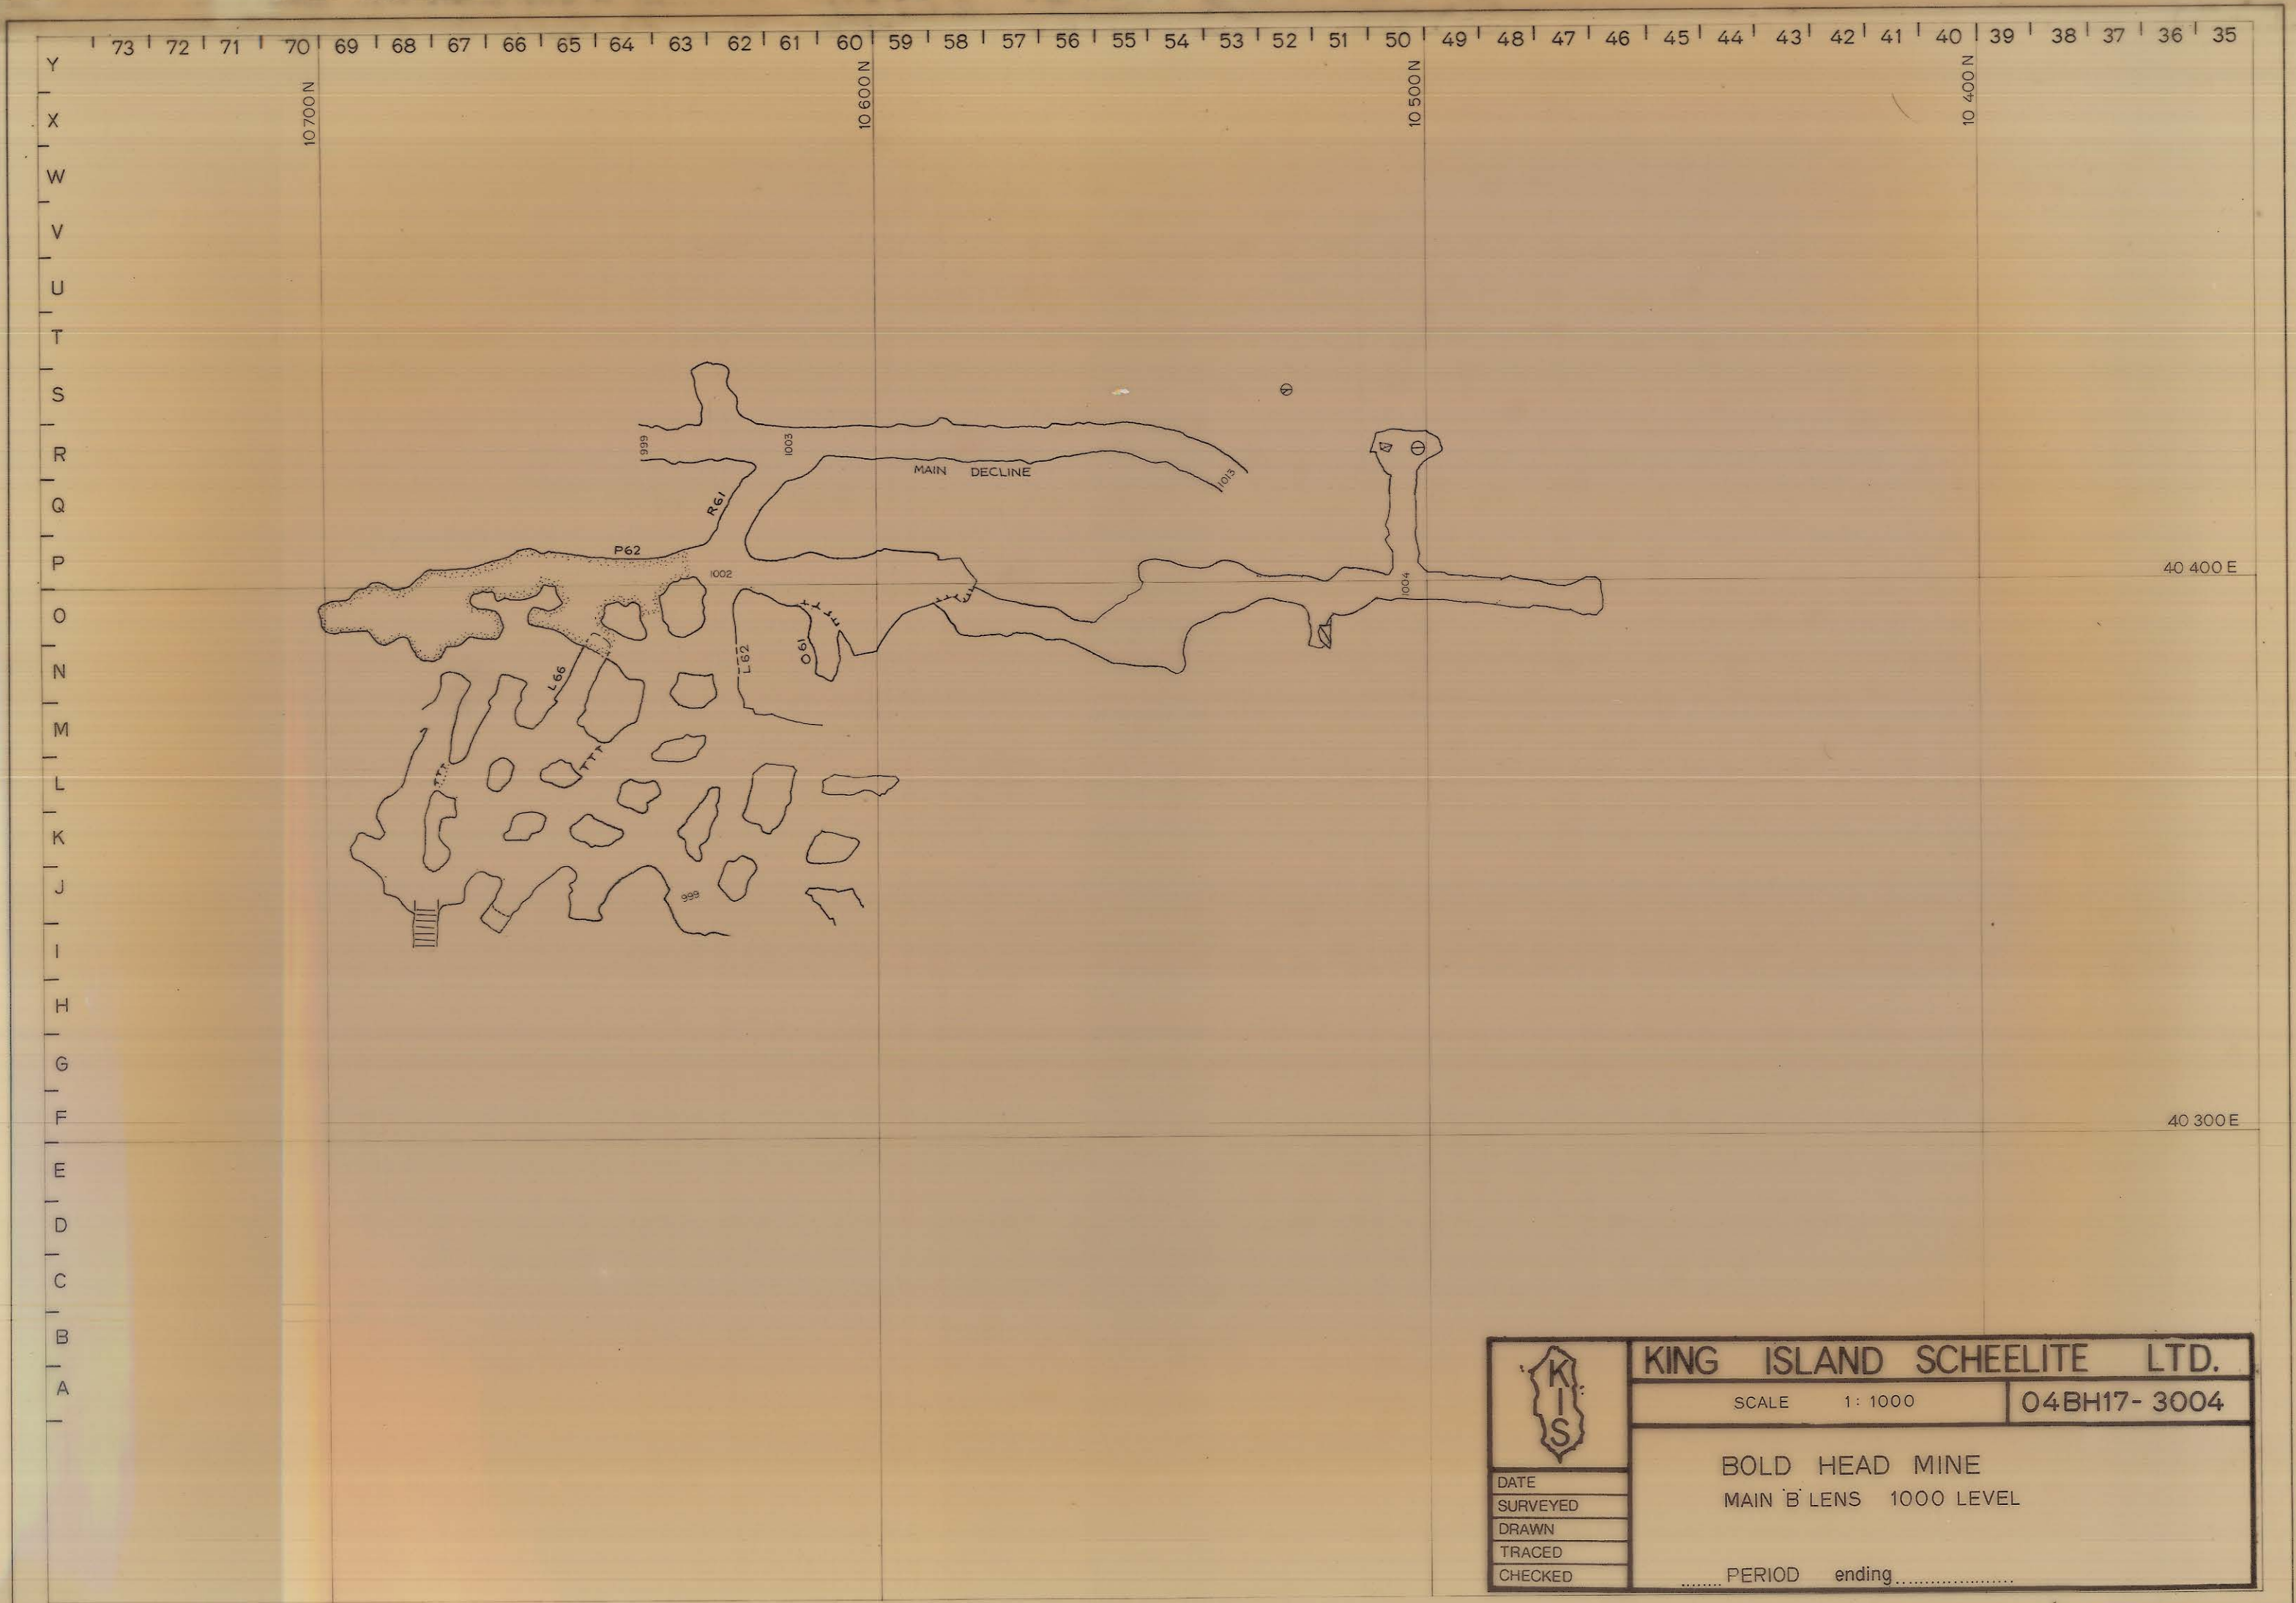

	KING ISLAND SCHEELITE LTD.	
	SCALE 1: 1000	04BH17- 3004
	BOLD HEAD MINE	
	MAIN 'B' LENS 1000 LEVEL	
	 PERIOD ending	
DATE		
SURVEYED		
DRAWN		
TRACED		
CHECKED		