


5 cm

0374_4446

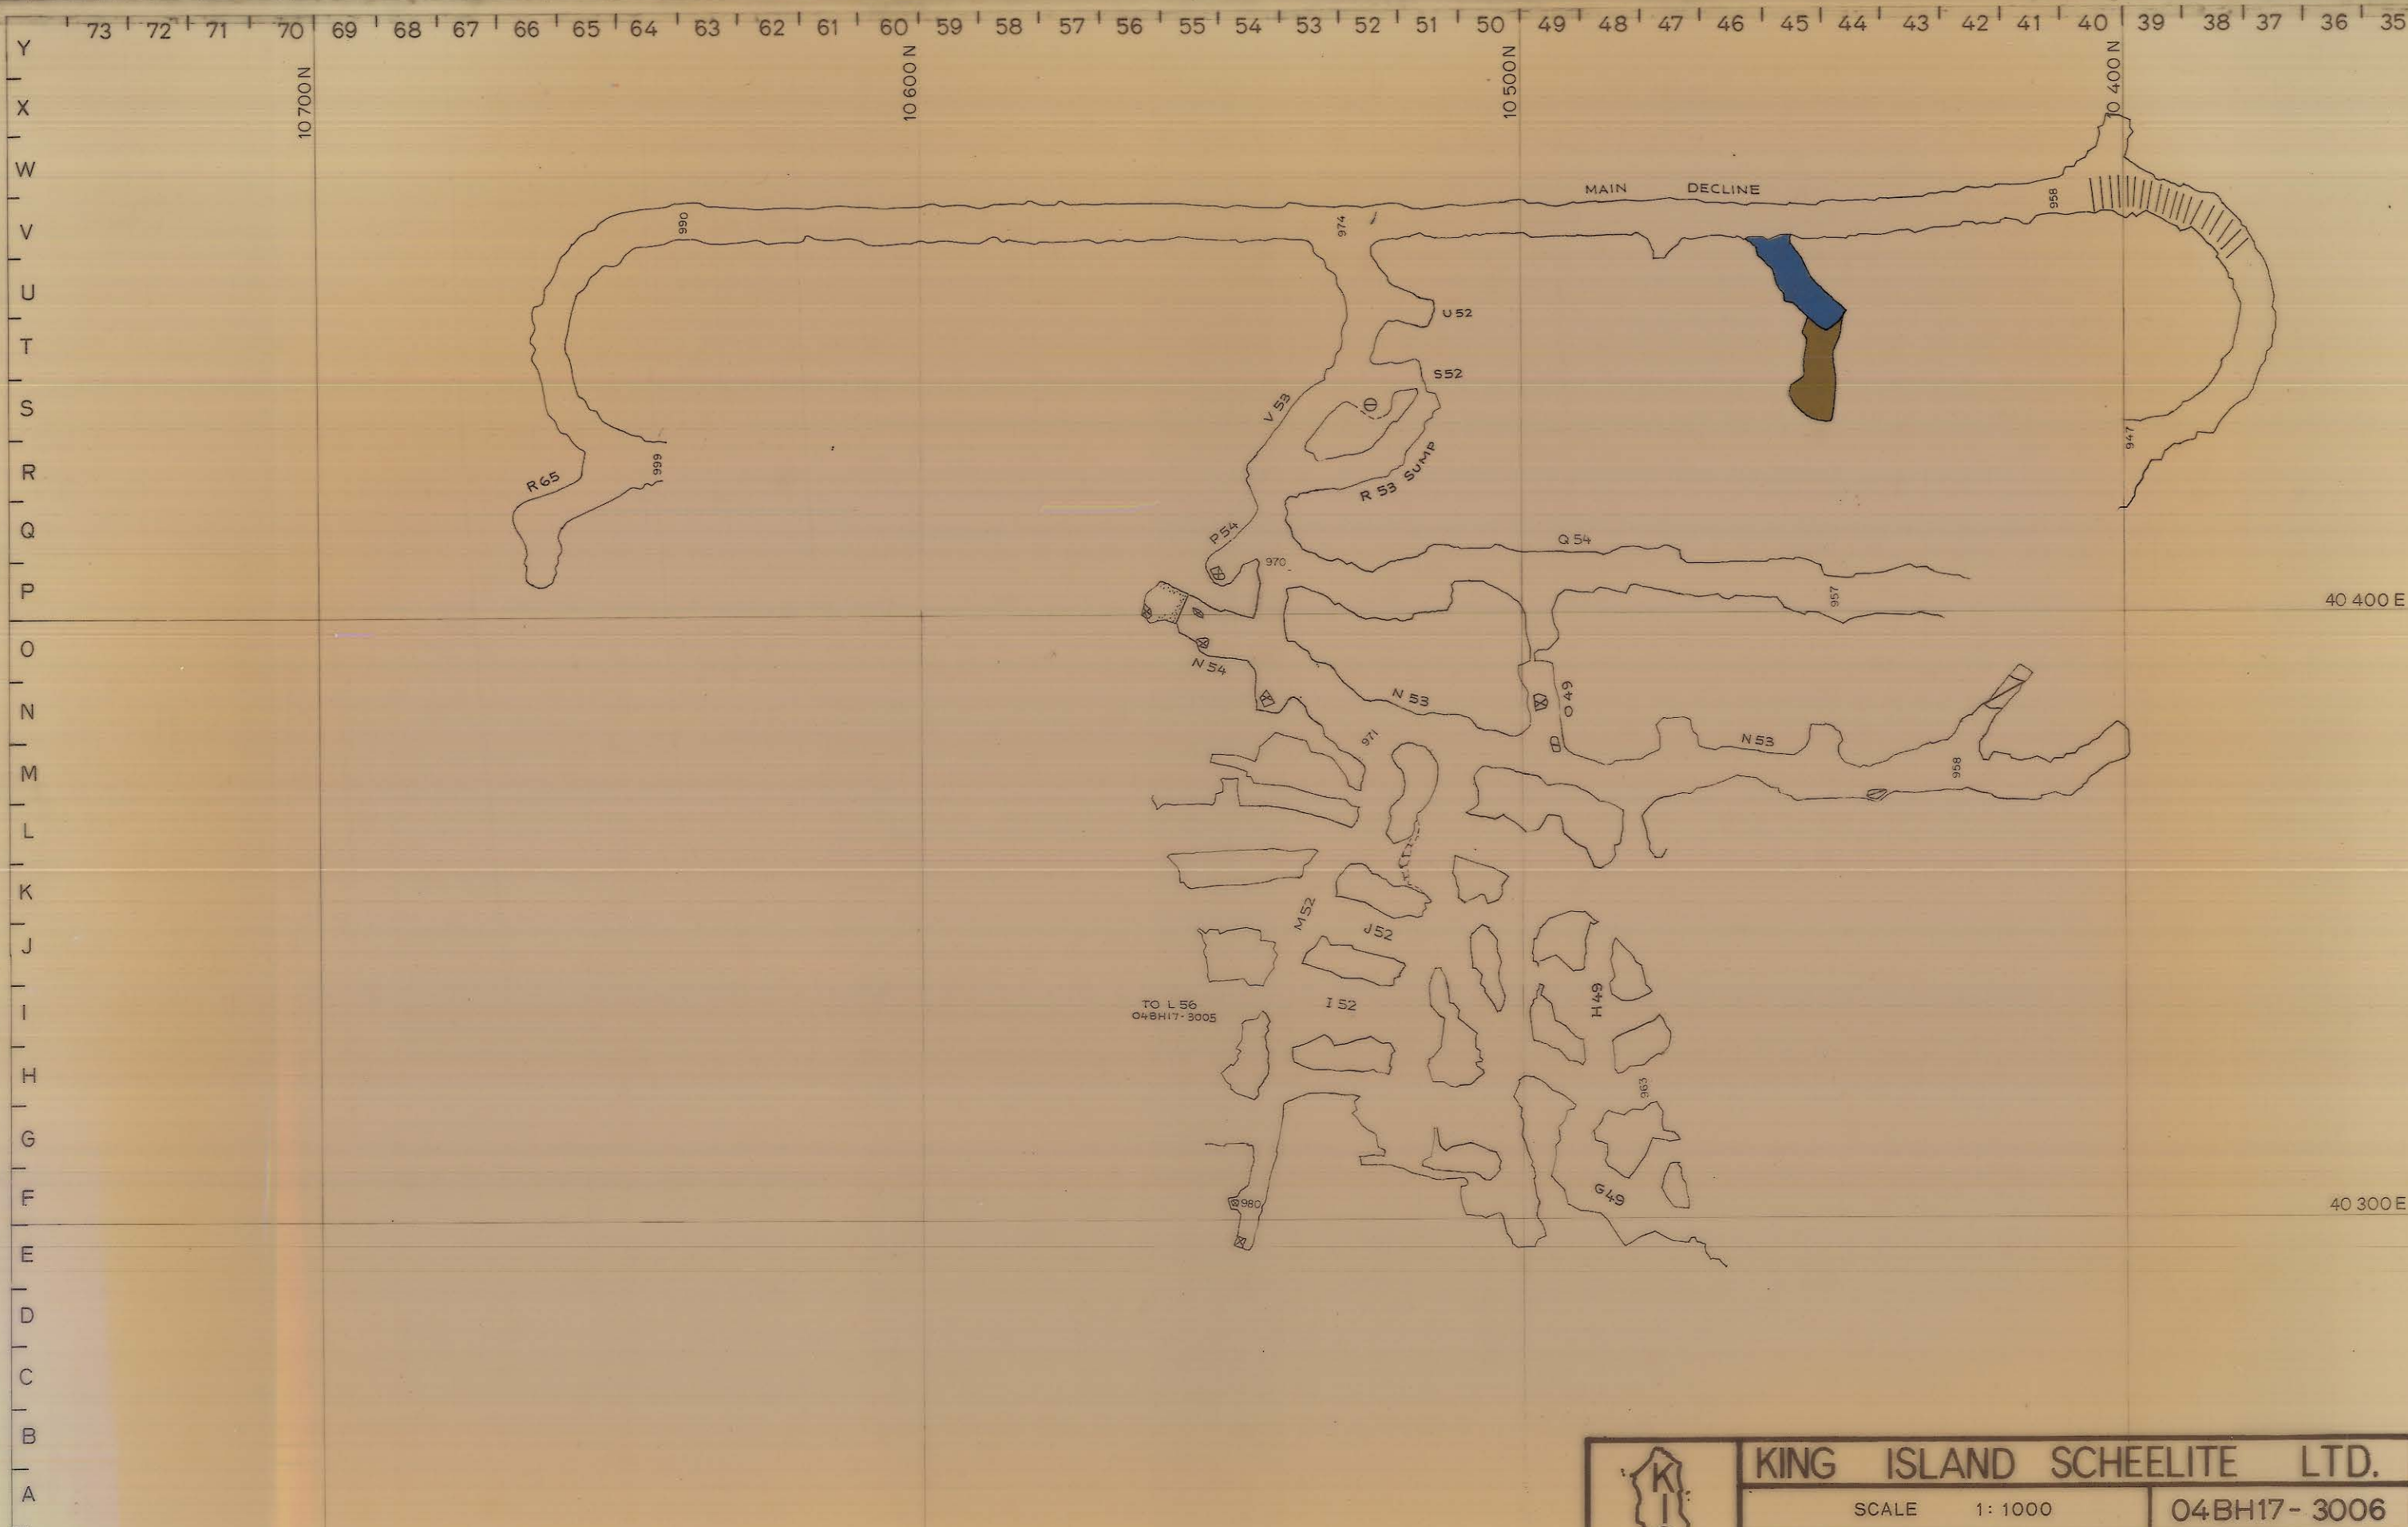

	KING ISLAND SCHEELITE LTD.	
	SCALE 1: 1000	04BH17- 3006
	BOLD HEAD MINE	
	B LENS FAULT BLOCK	
	 PERIOD ending	
DATE		
SURVEYED		
DRAWN 		
TRACED		
CHECKED		