
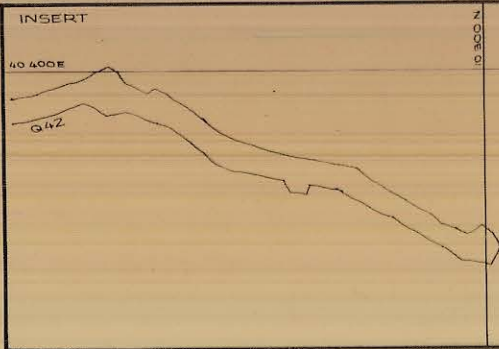


0374_4447

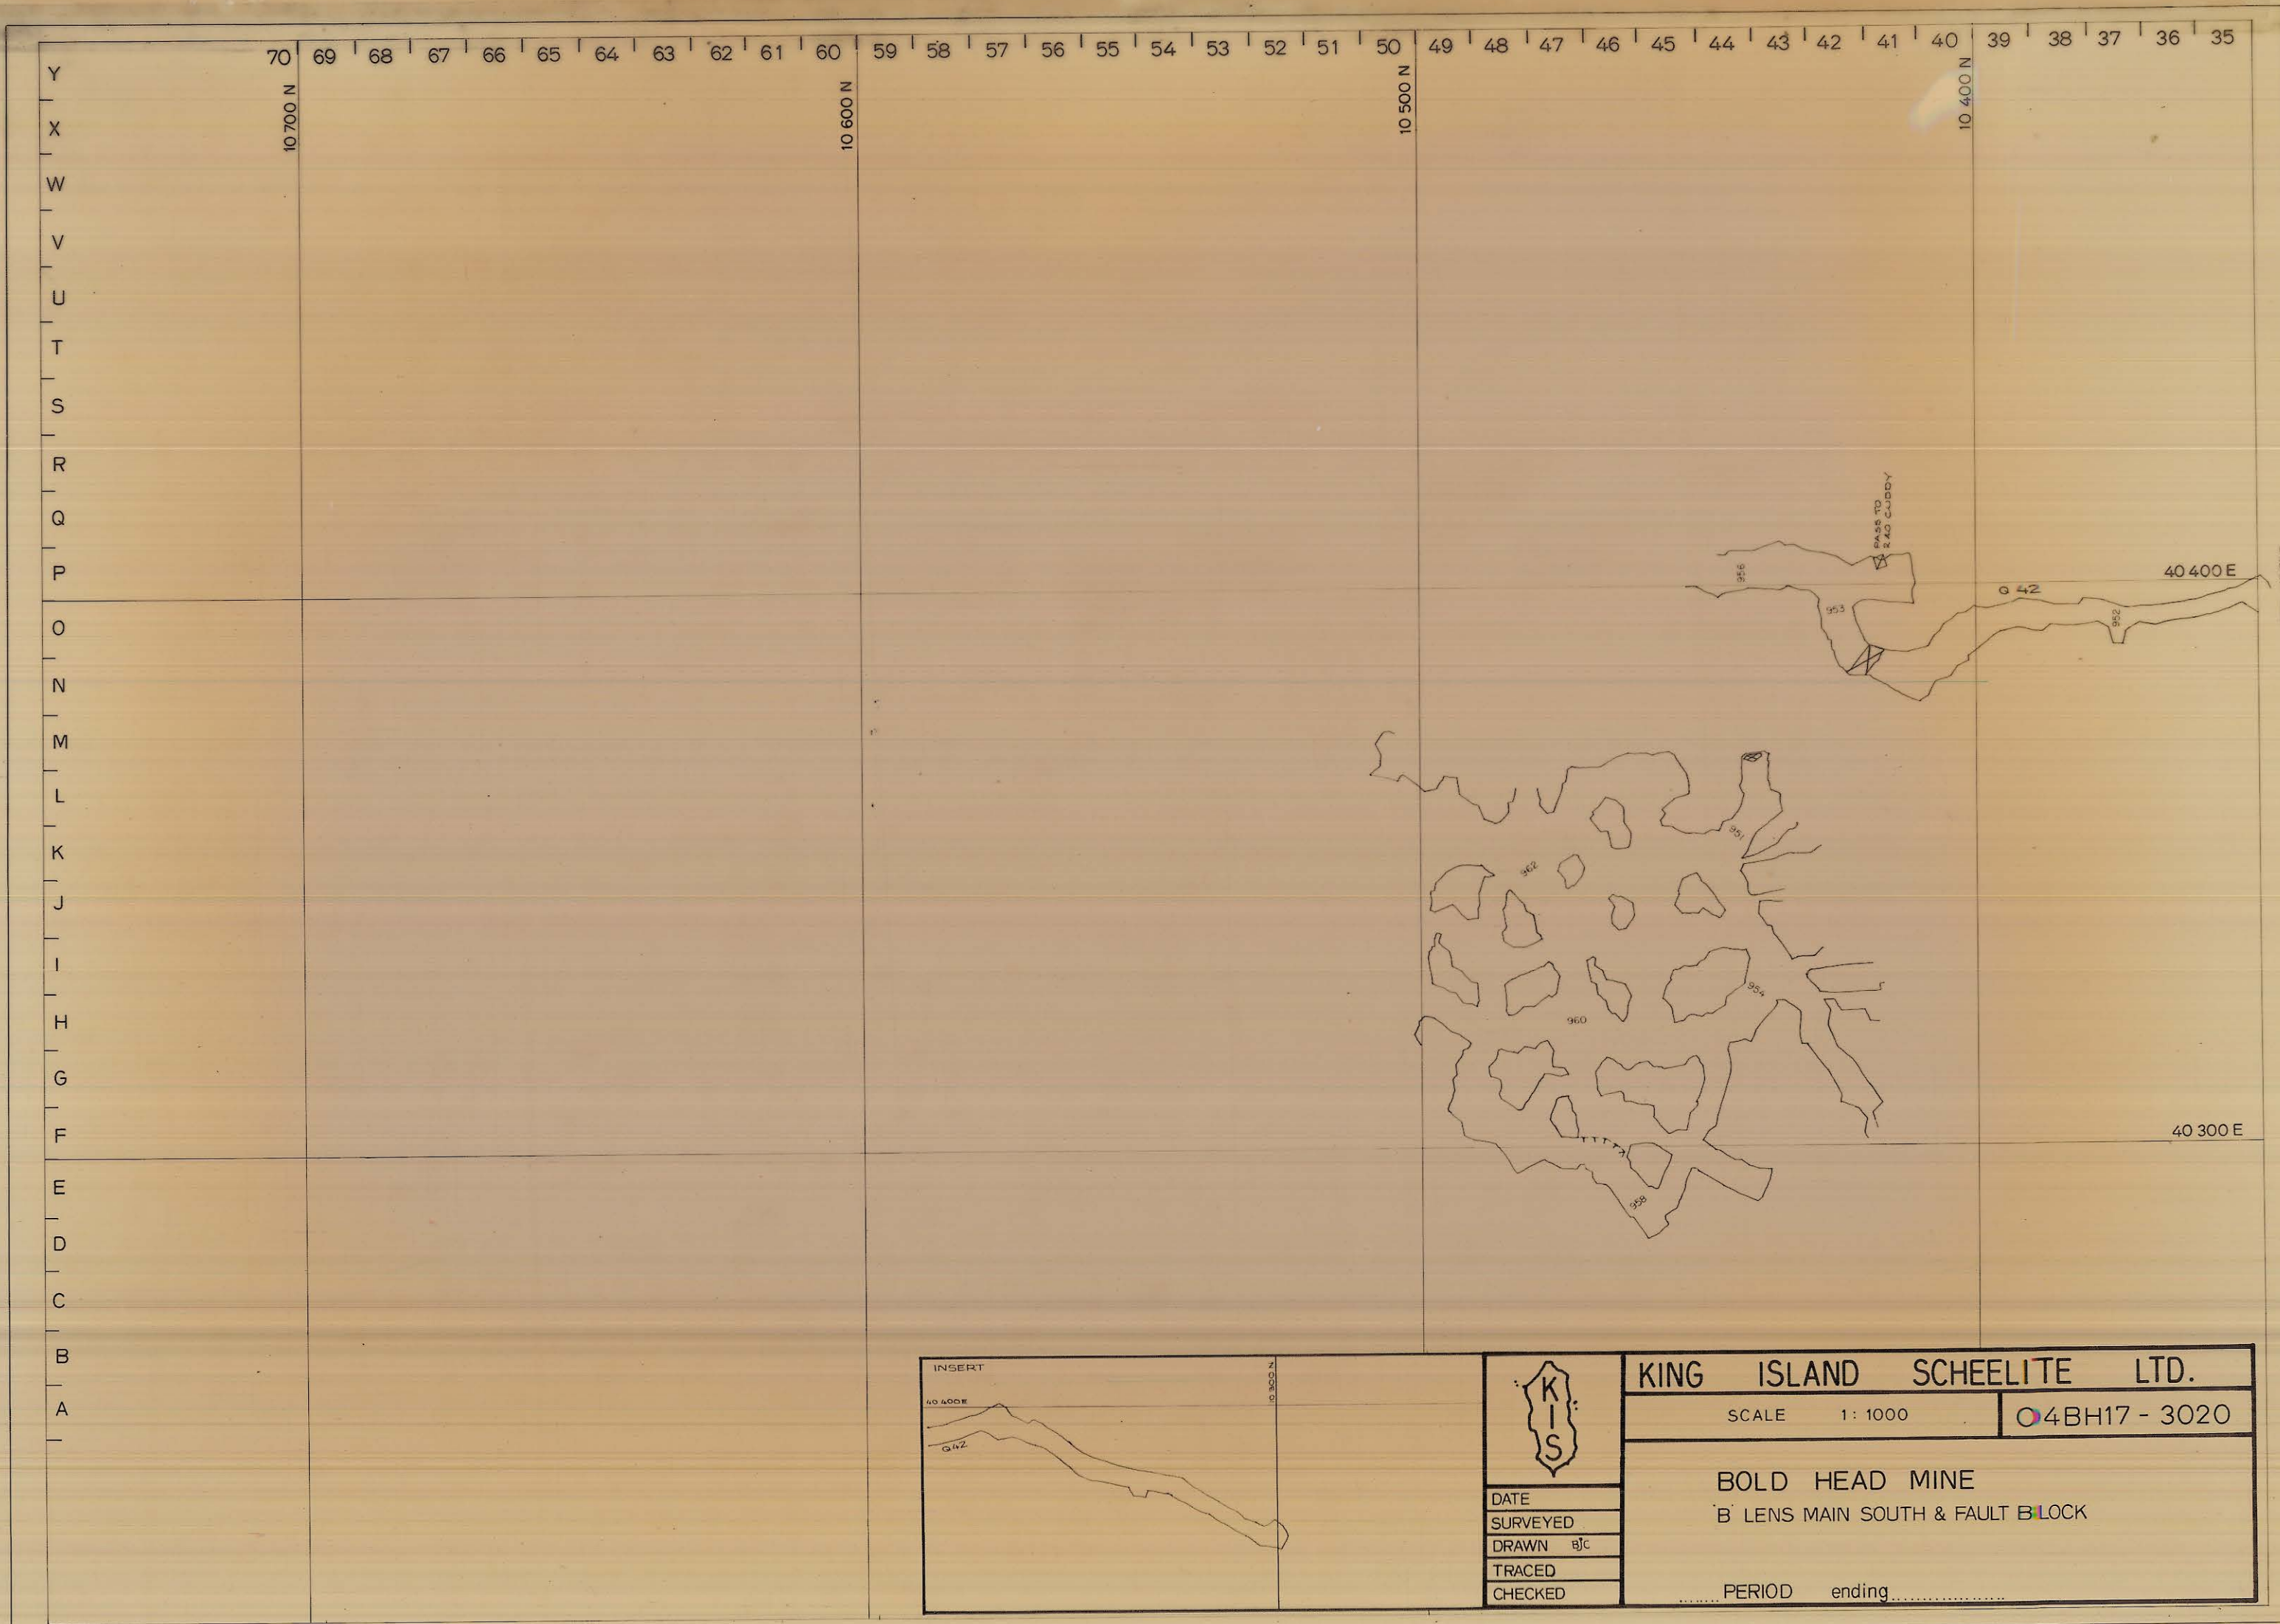

	DATE
	SURVEYED
	DRAWN BJC
	TRACED
CHECKED	

KING ISLAND SCHEELITE LTD.	
SCALE 1: 1000	04BH17 - 3020
BOLD HEAD MINE	
B LENS MAIN SOUTH & FAULT BLOCK	
..... PERIOD ending	