
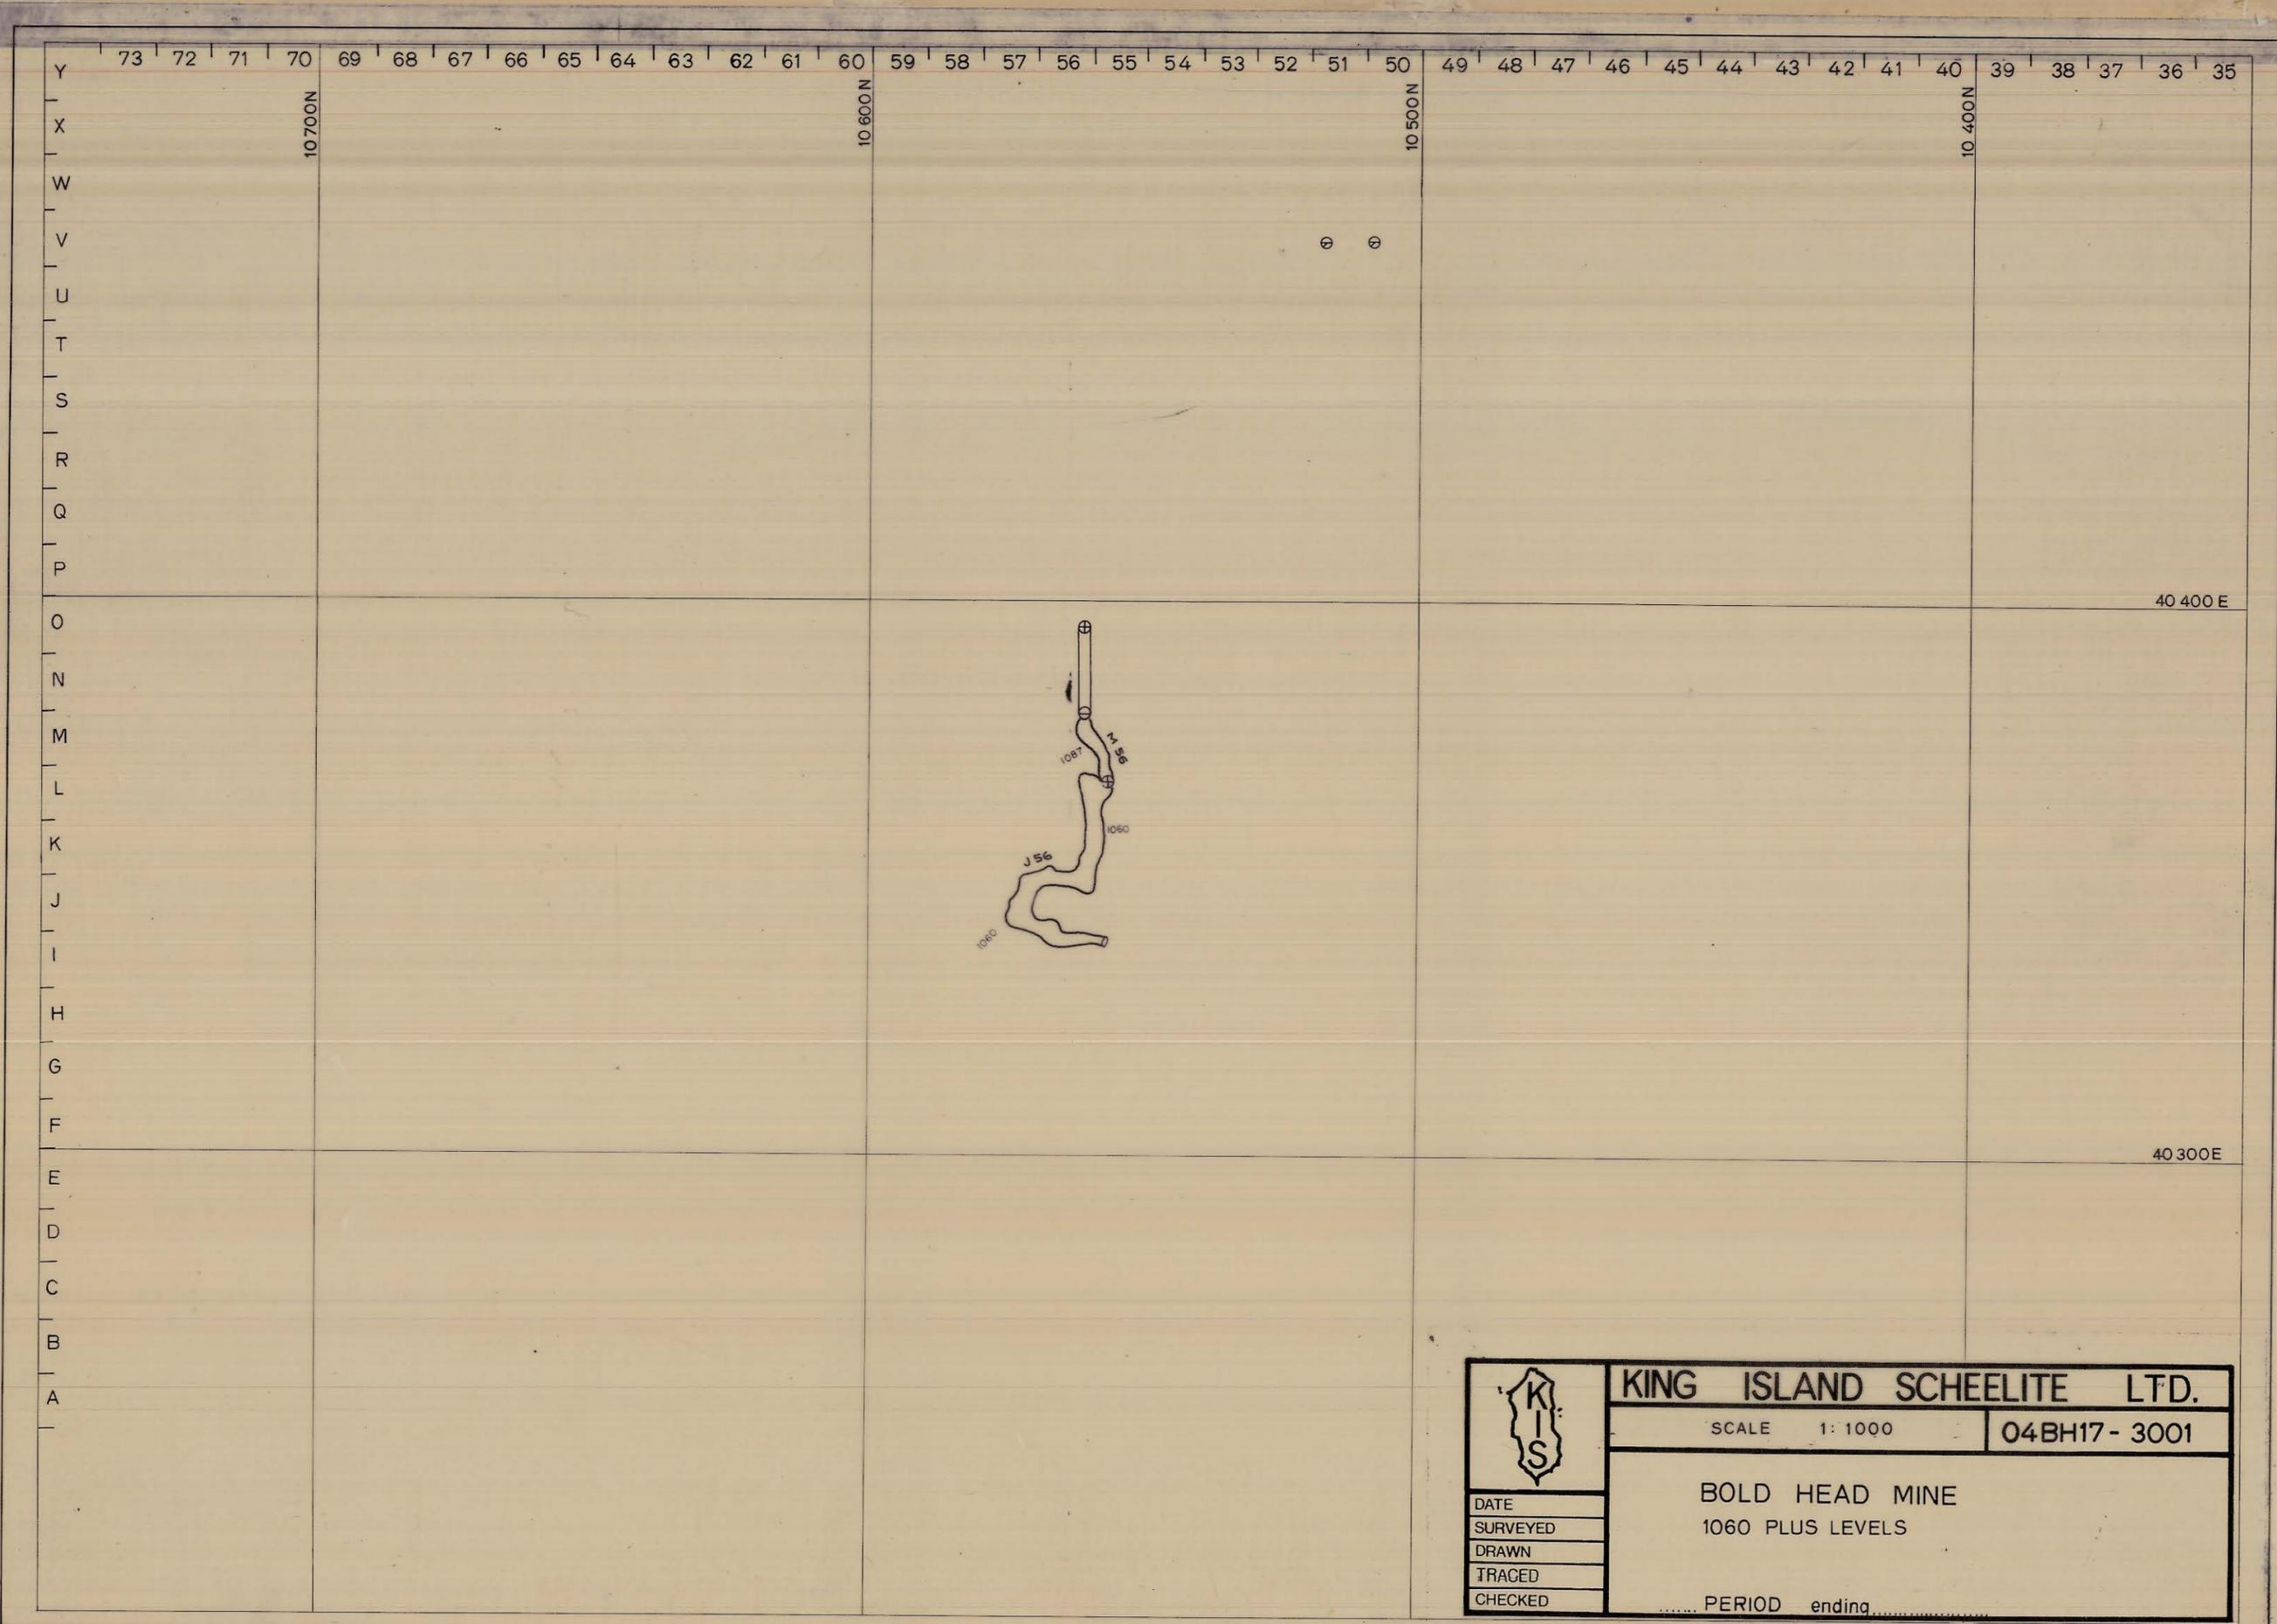
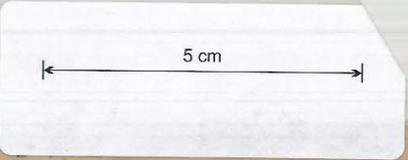


0374\_4453

04BH17-3025

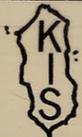

	<b>KING ISLAND SCHEELITE LTD.</b>	
	SCALE 1: 1000	04BH17- 3001
<b>BOLD HEAD MINE</b> 1060 PLUS LEVELS ..... PERIOD ending .....		
DATE		
SURVEYED		
DRAWN		
TRACED		
CHECKED		