
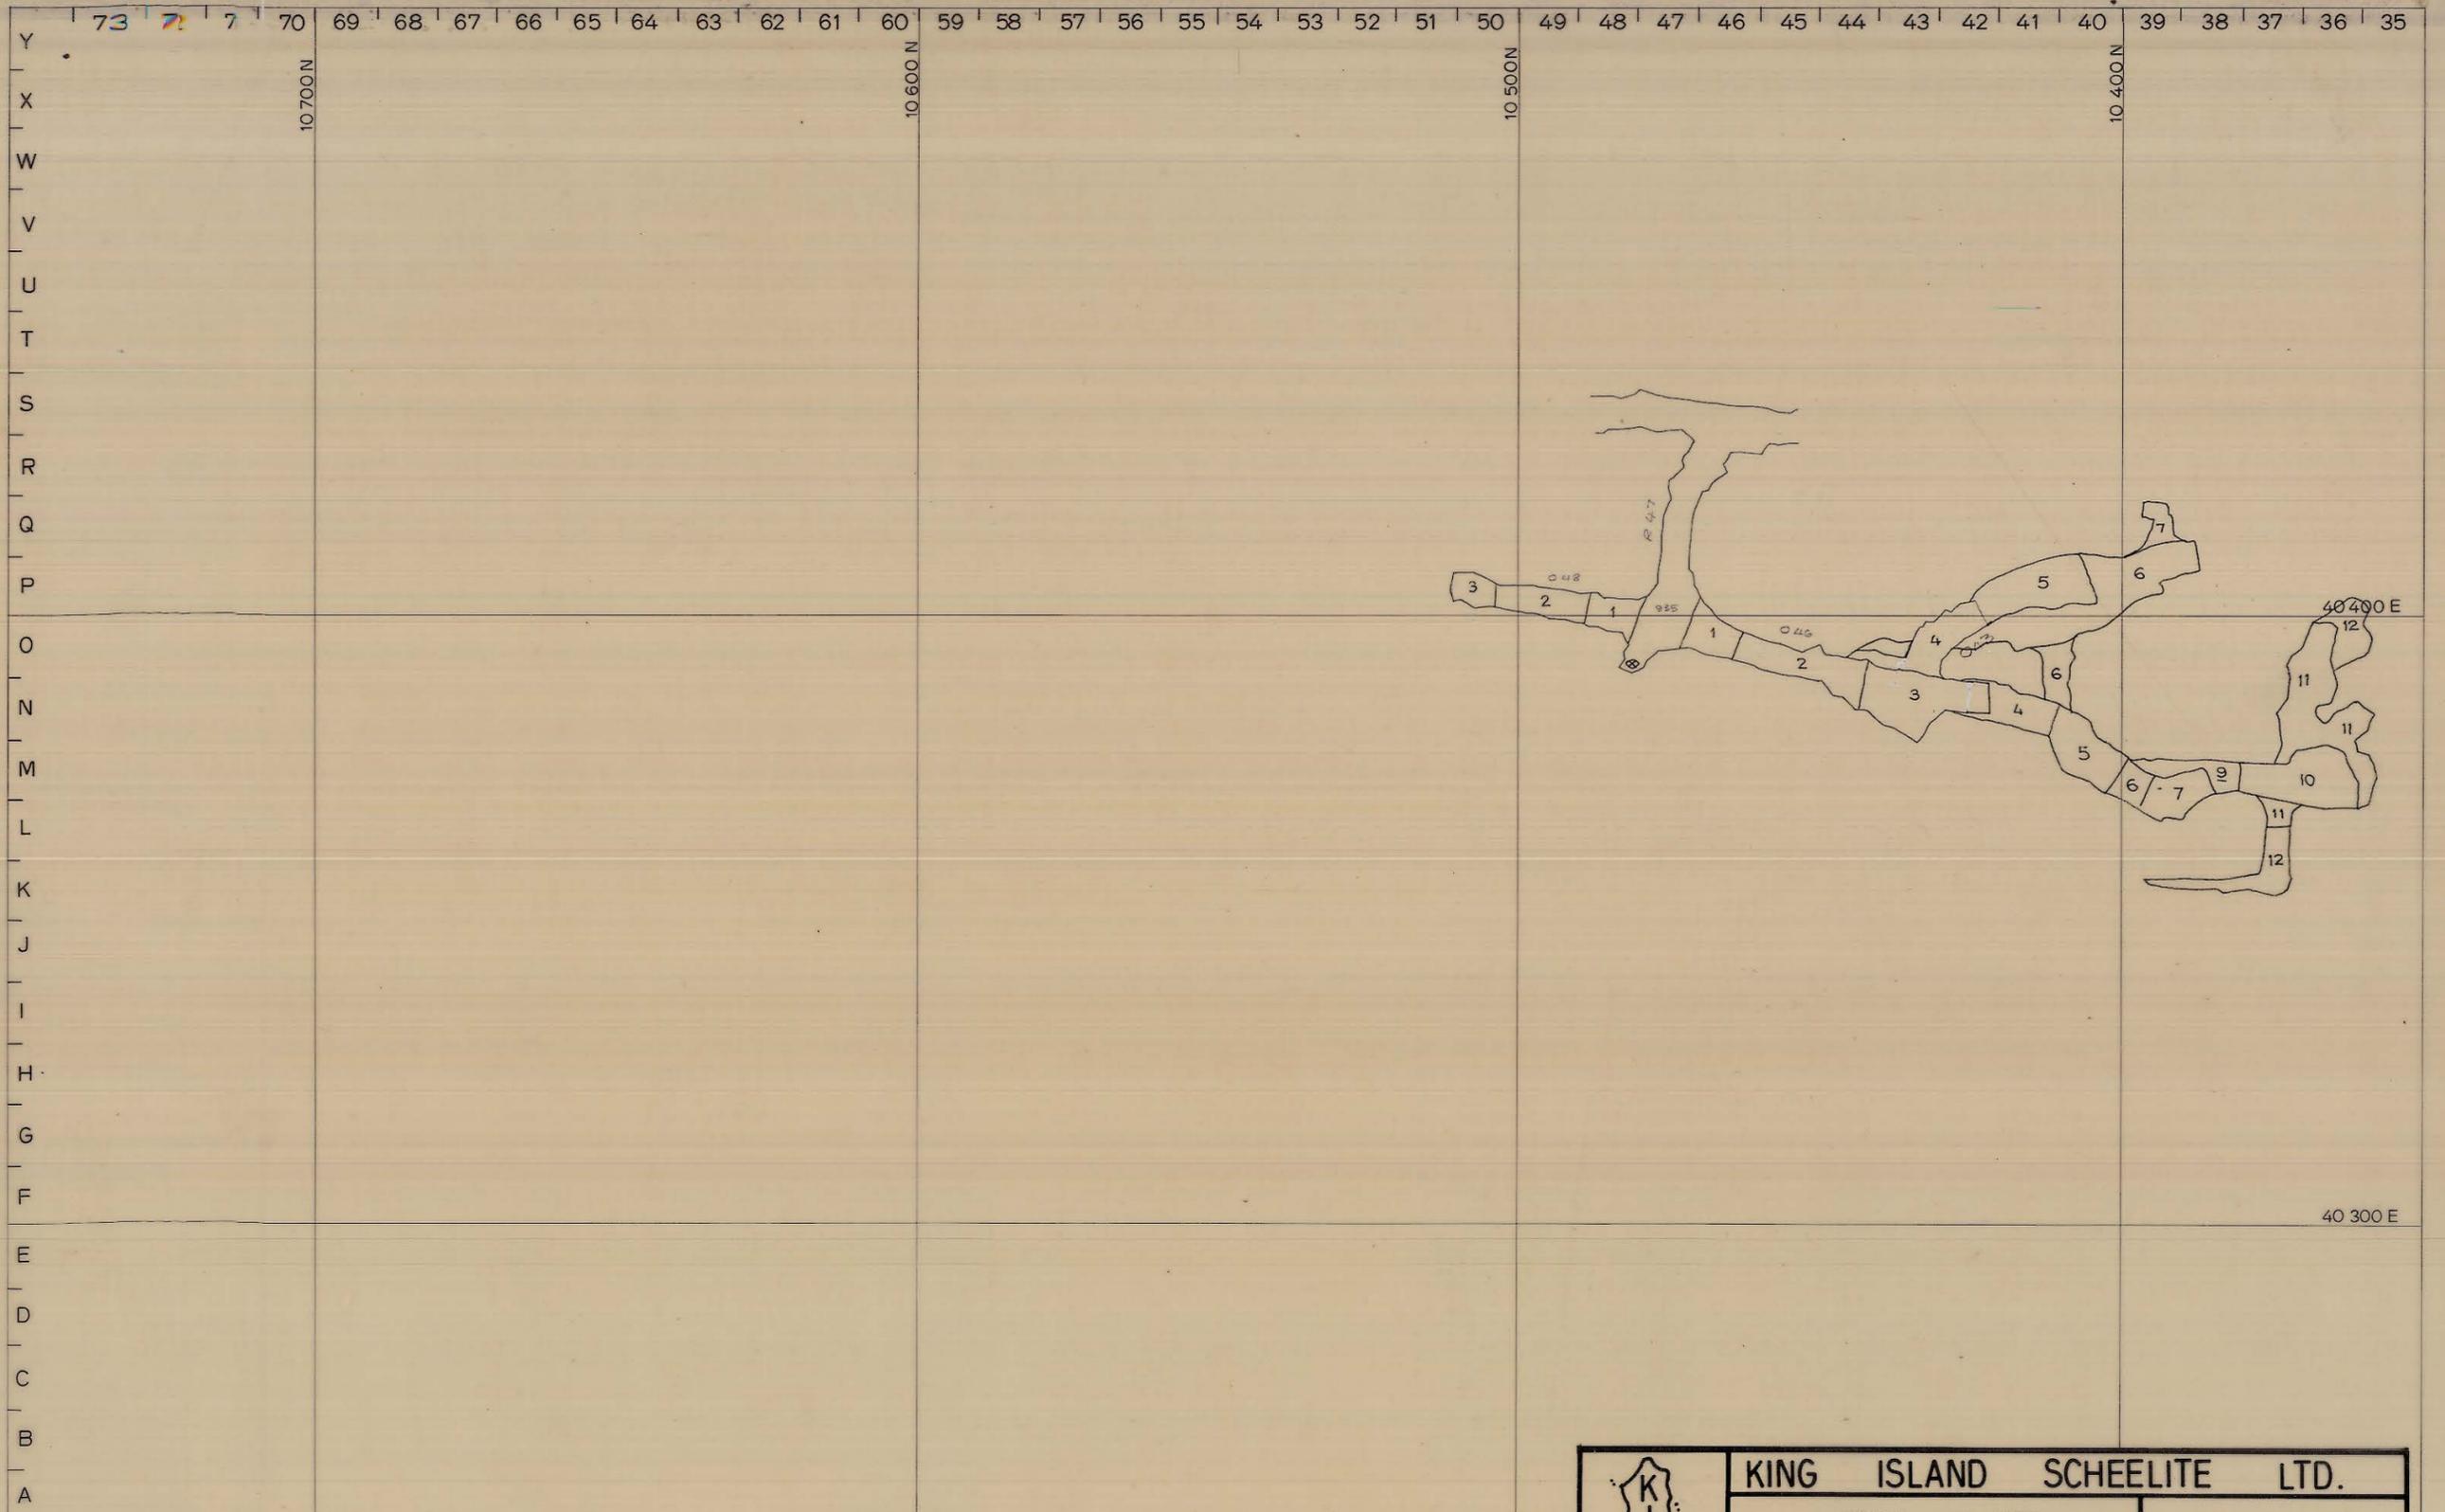
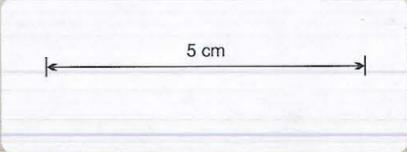


0374_4454

PERIOD
ADVANCE
1978-79

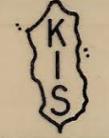

	KING ISLAND SCHEELITE LTD.	
	SCALE	1: 1000
	BOLD HEAD MINE	
	DATE	PERIOD ending
	SURVEYED	
DRAWN		
TRACED		
CHECKED		