
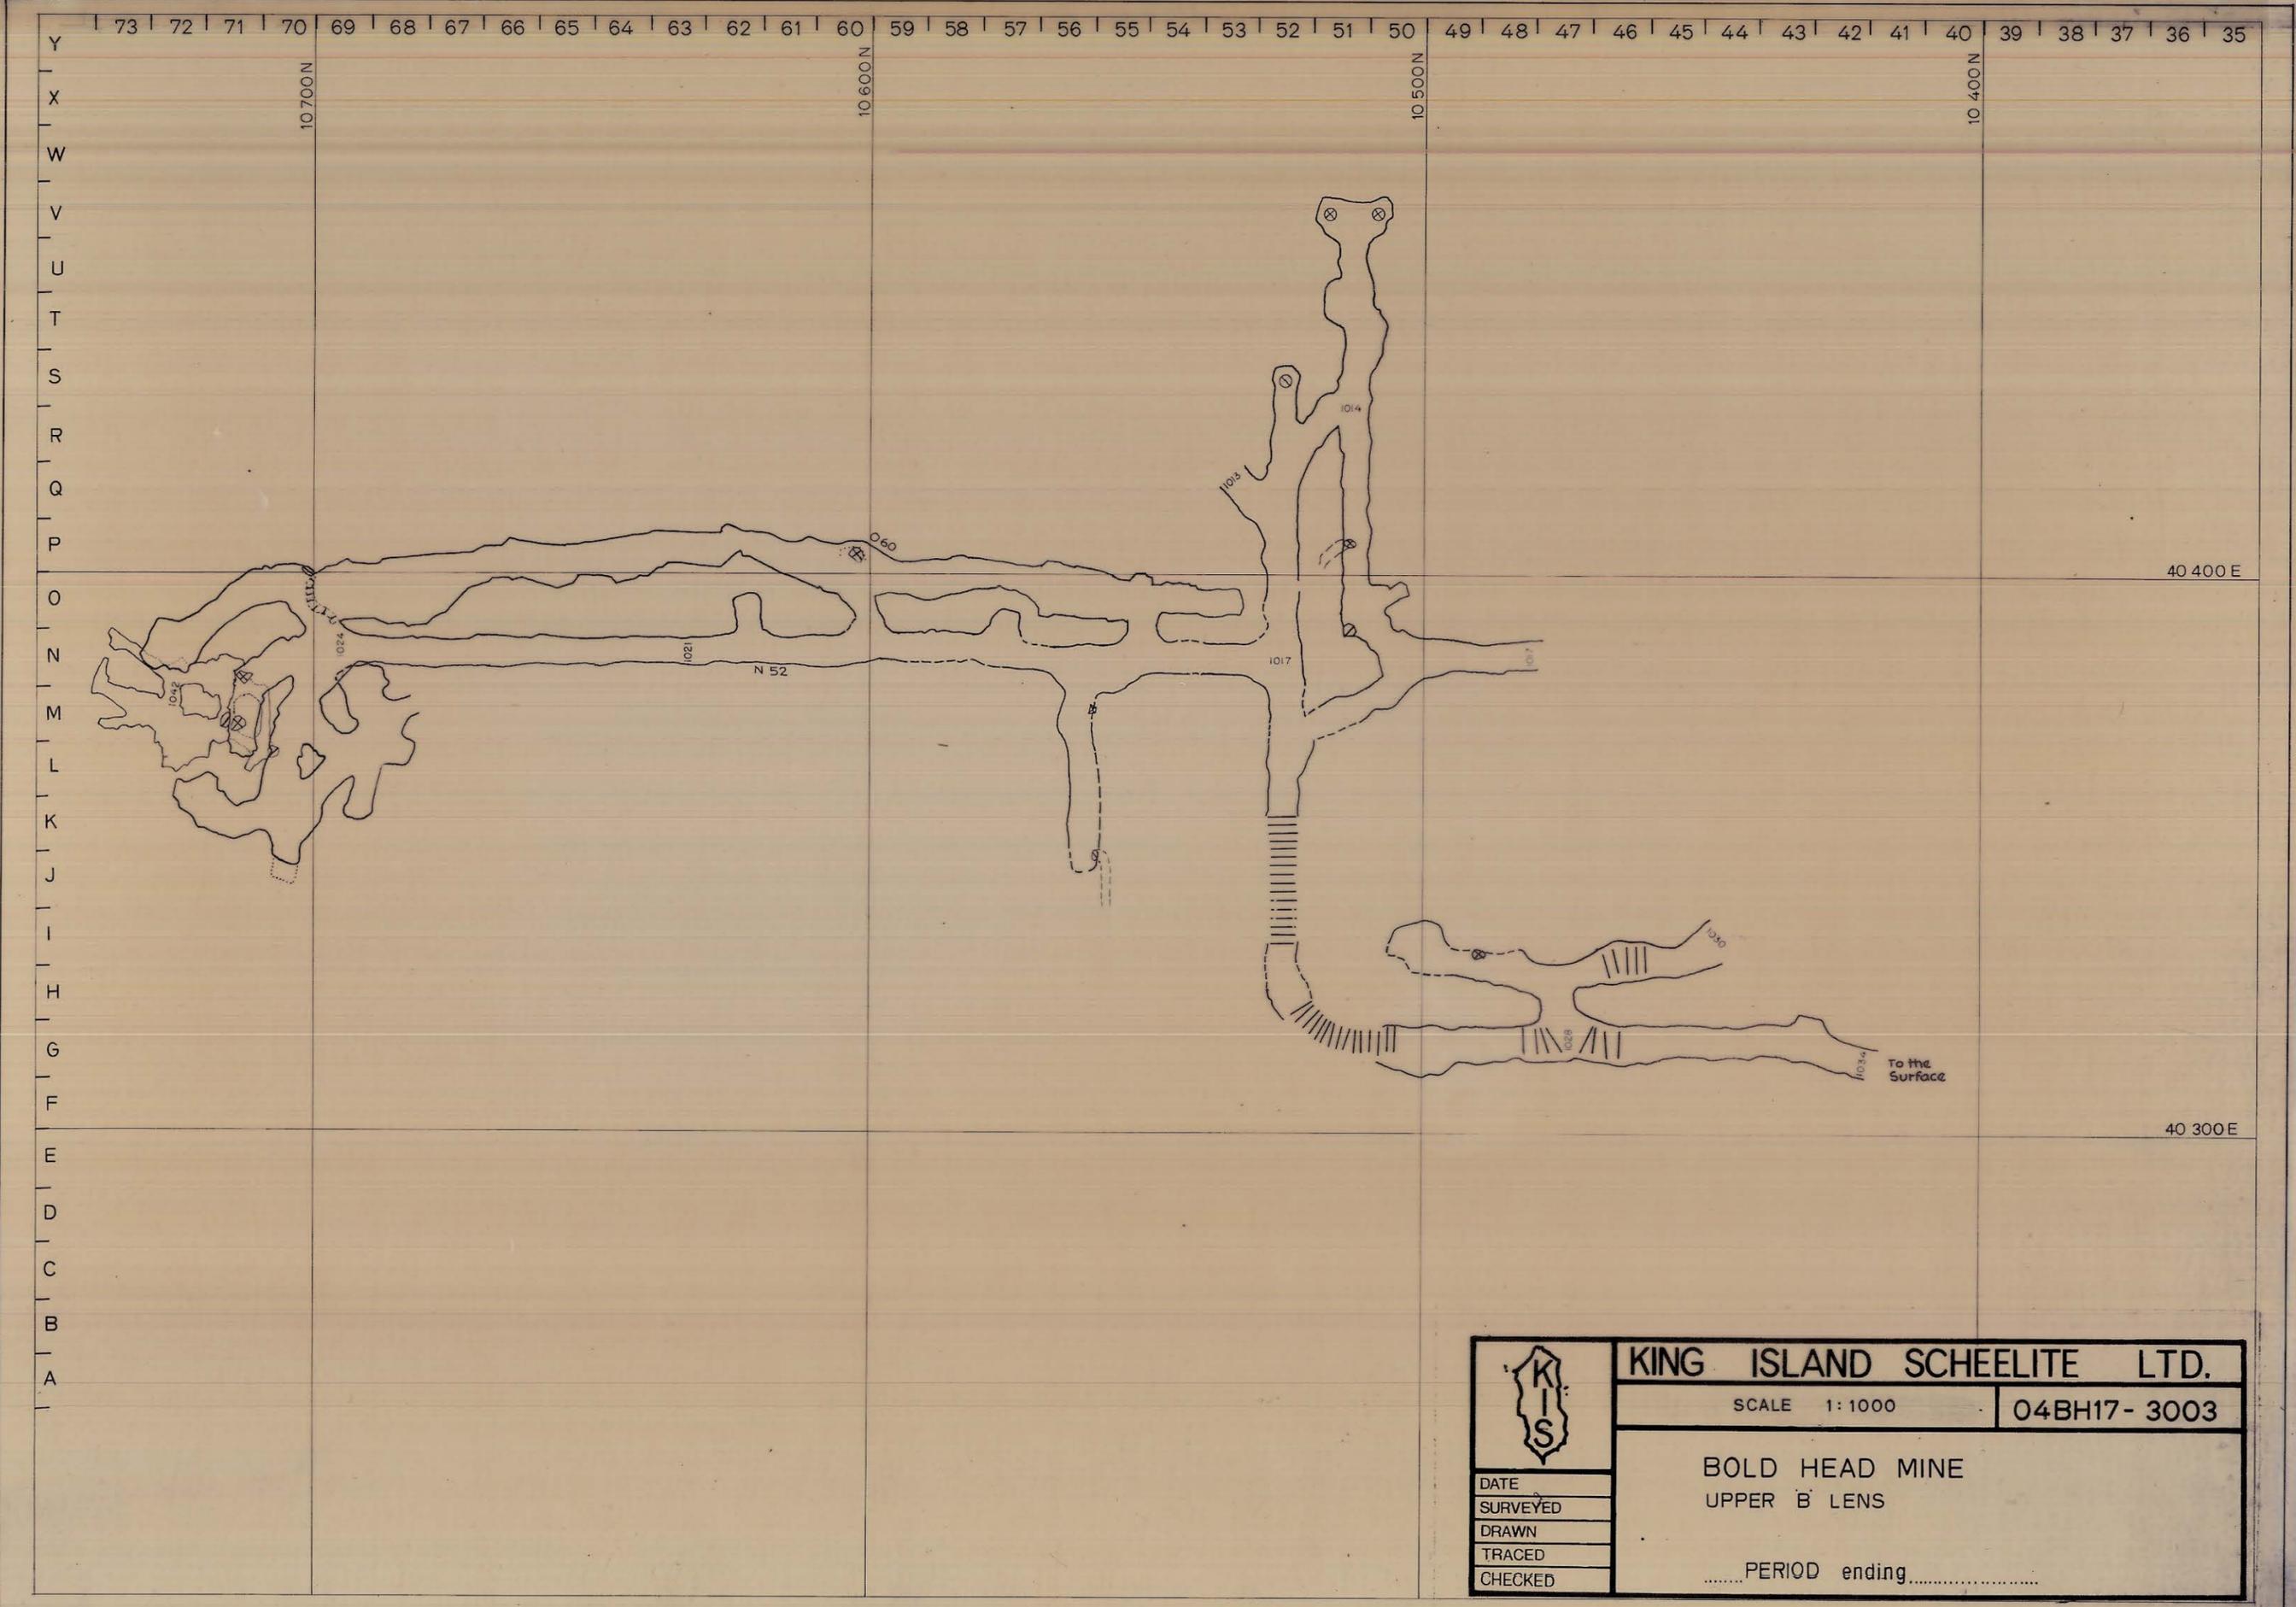


0374_4456

5 cm

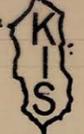

	KING ISLAND SCHEELITE LTD.	
	SCALE 1:1000	04BH17- 3003
BOLD HEAD MINE UPPER B LENS		
..... PERIOD ending		
DATE		
SURVEYED		
DRAWN		
TRACED		
CHECKED		