
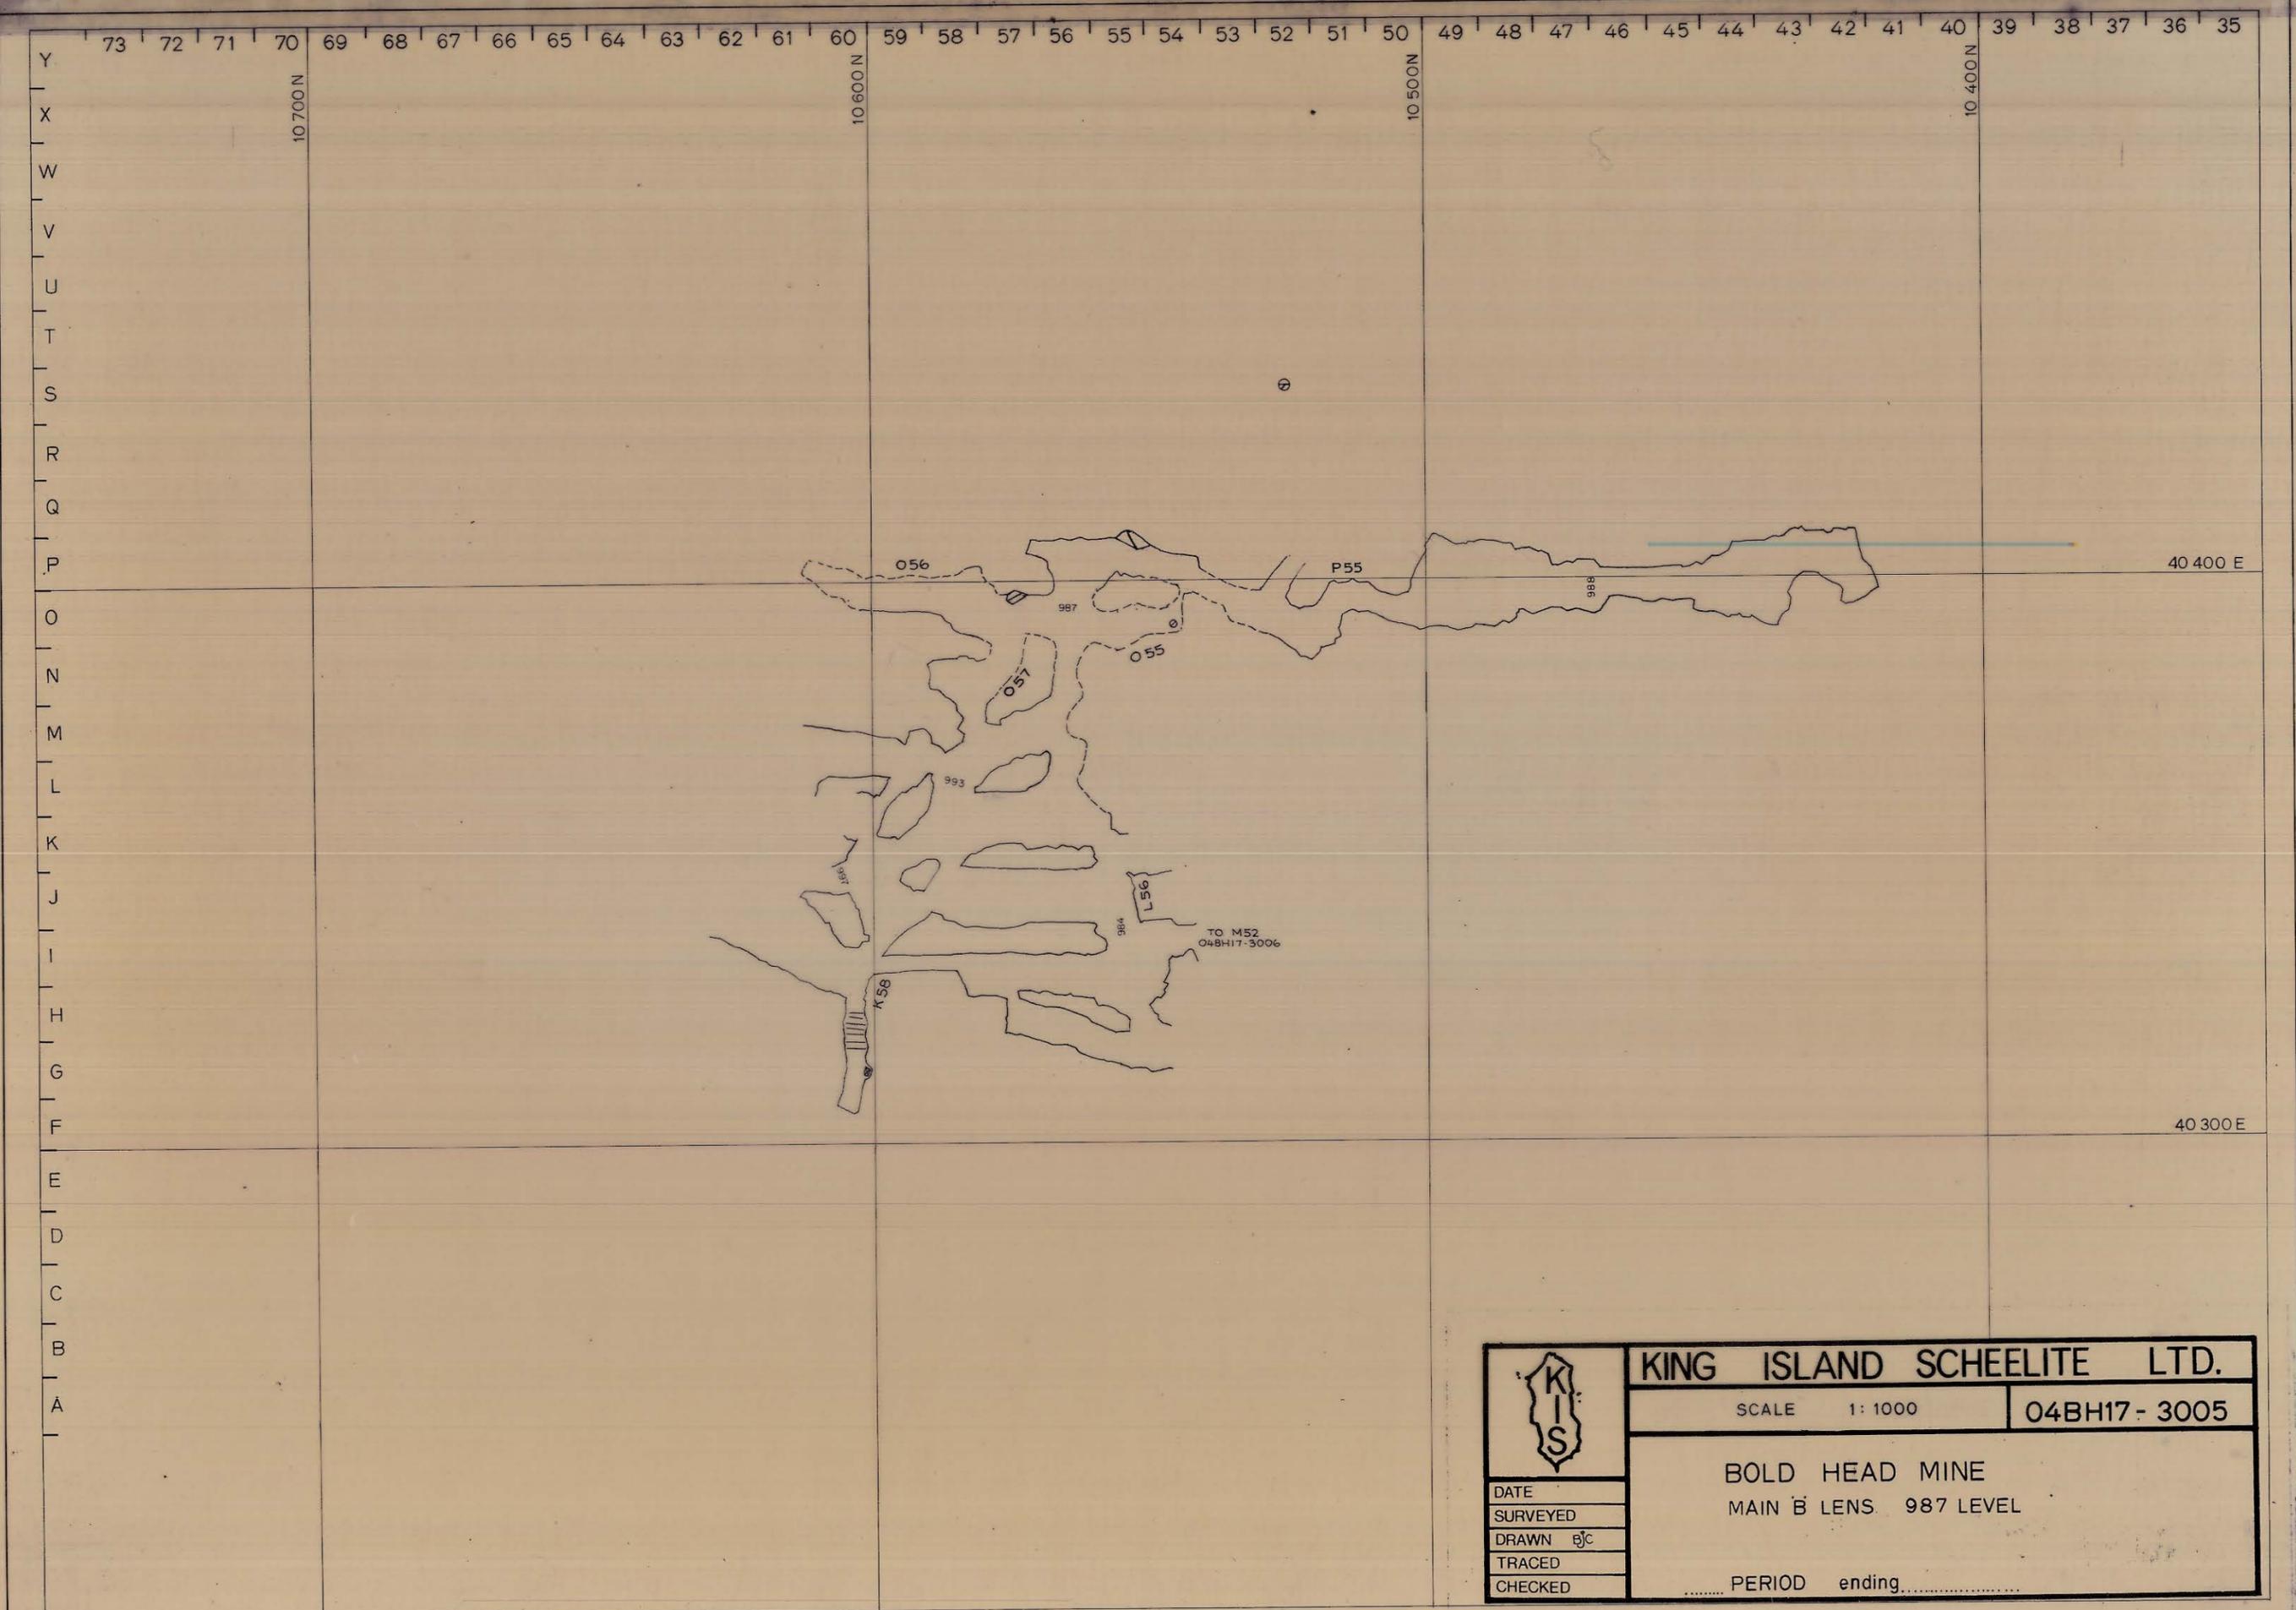
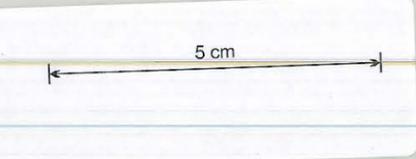


0374_4458

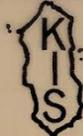

	KING ISLAND SCHEELITE LTD.	
	SCALE 1:1000	04BH17-3005
	BOLD HEAD MINE	
	MAIN B LENS. 987 LEVEL	
 PERIOD ending.....	
DATE		
SURVEYED		
DRAWN EJC		
TRACED		
CHECKED		