
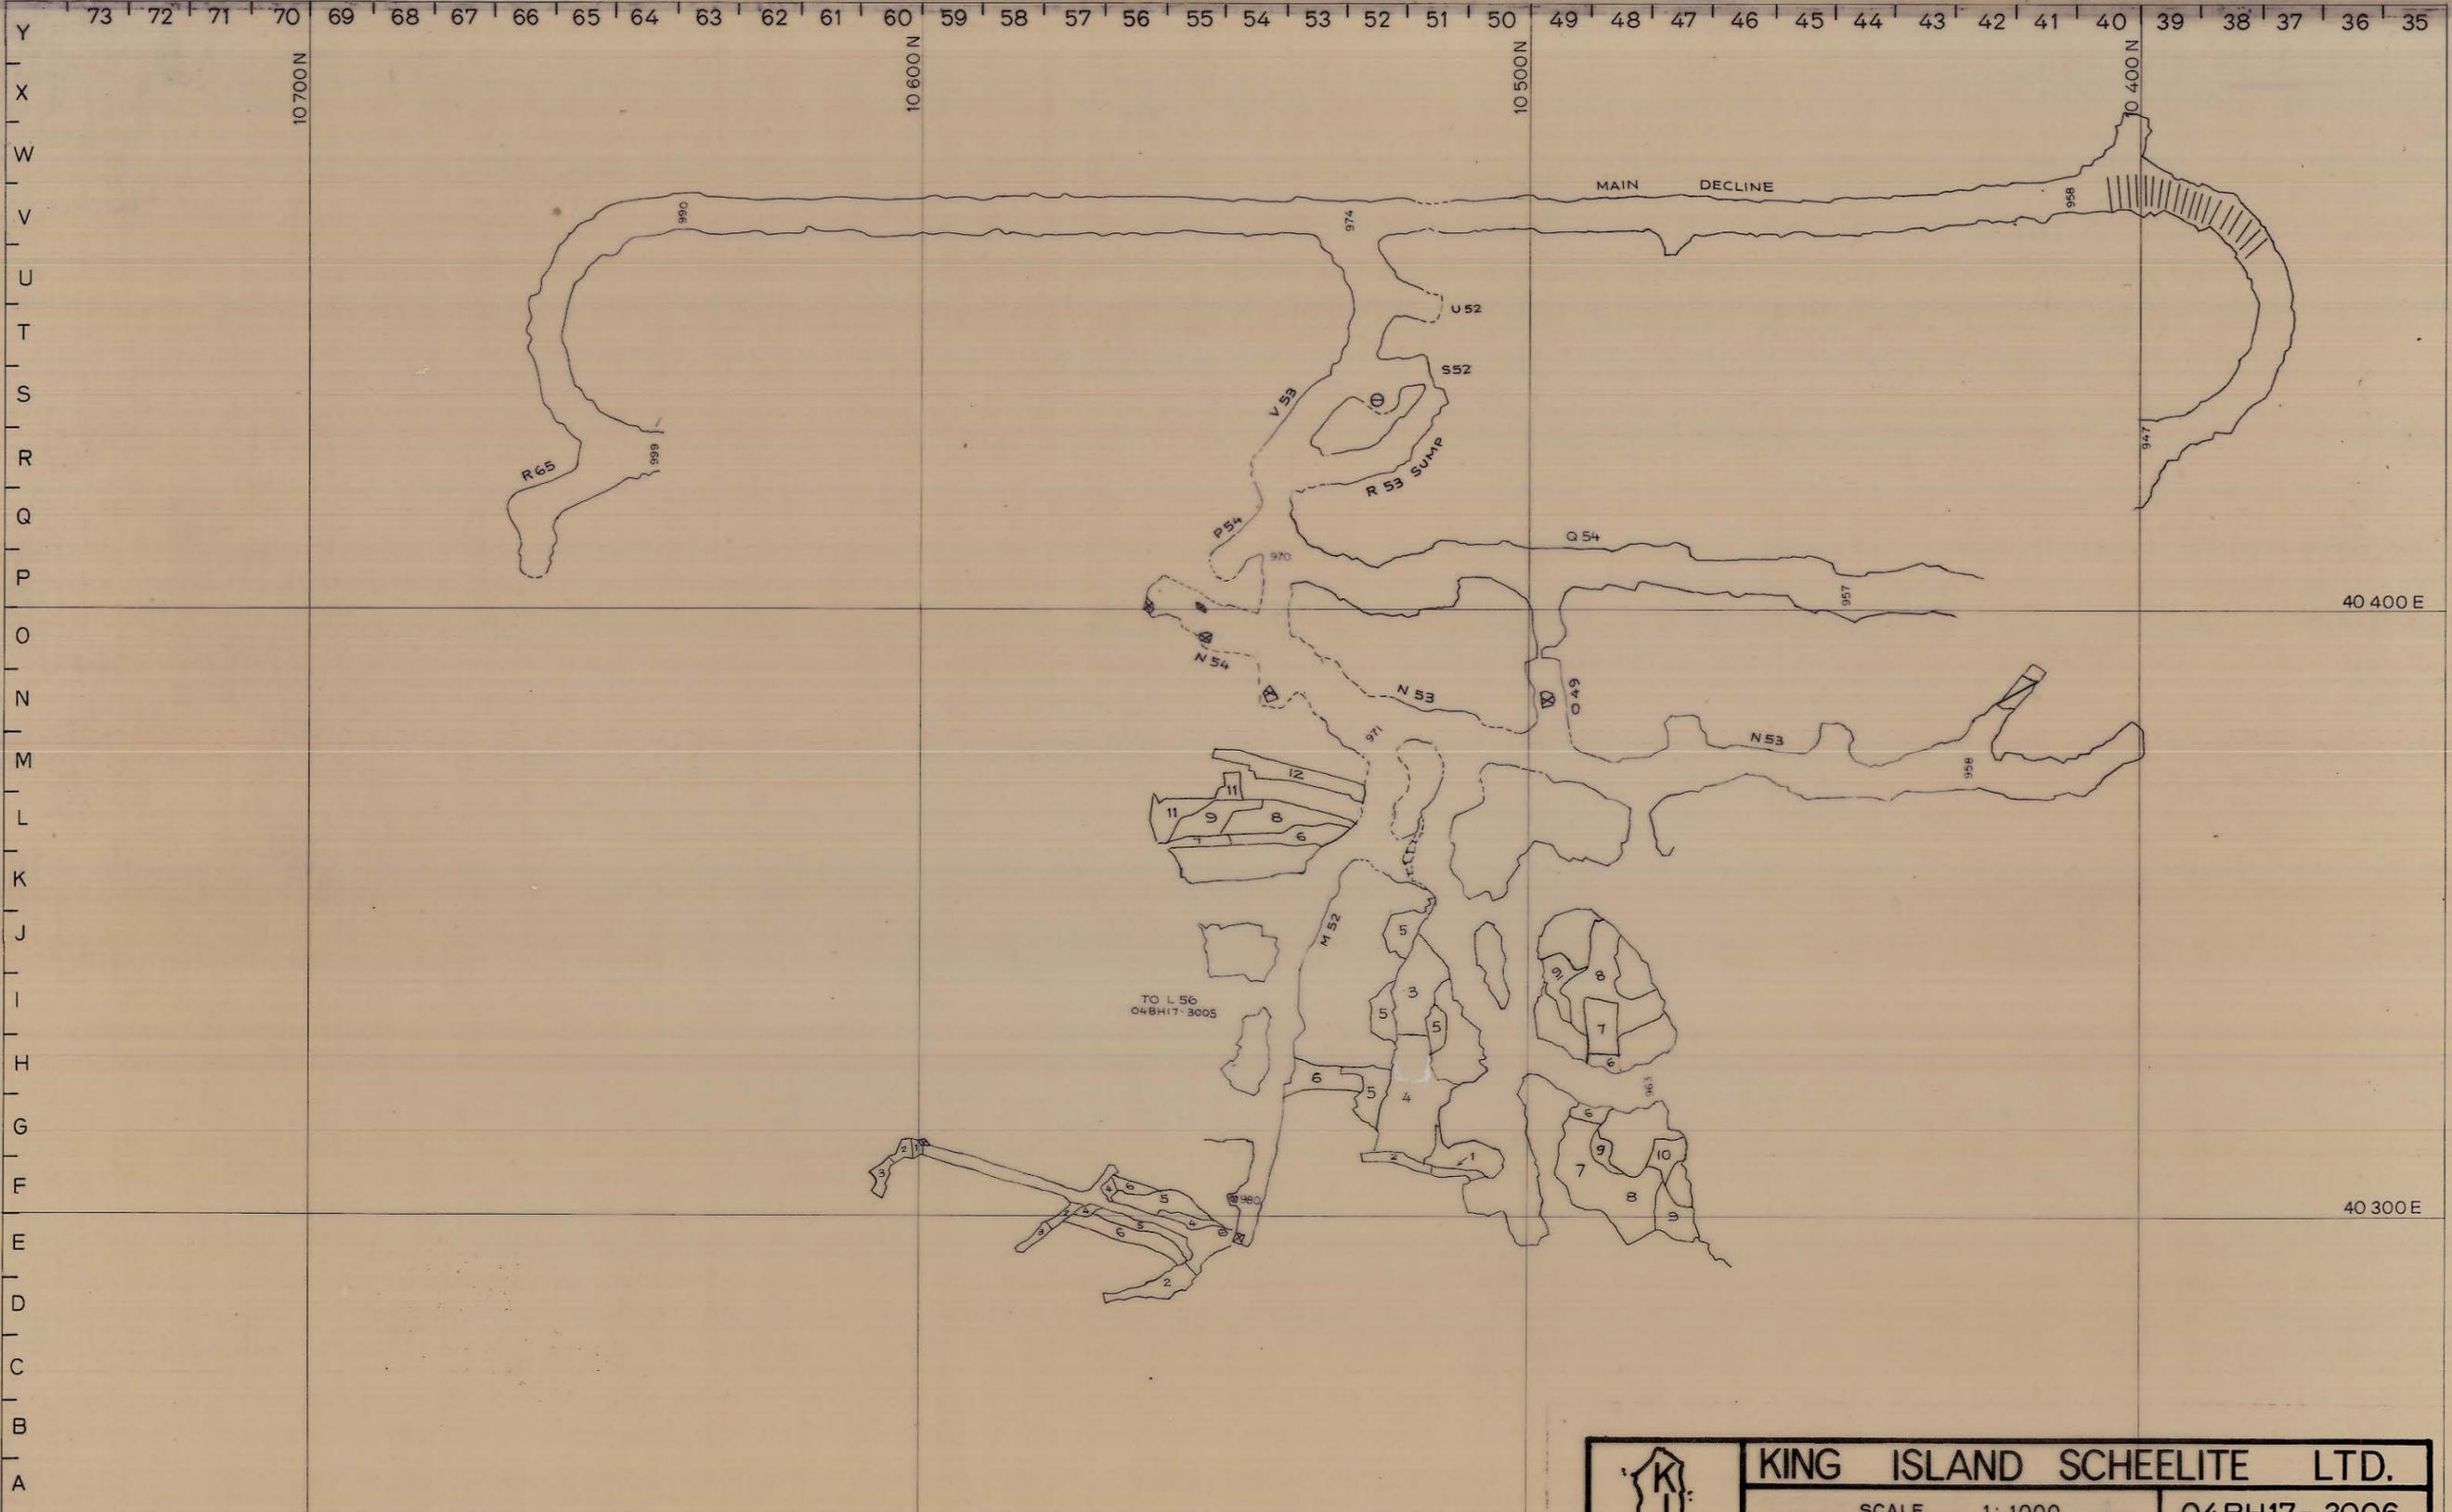


5 cm

0374_4459

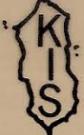

	KING ISLAND SCHEELITE LTD.	
	SCALE 1:1000	04BH17-3006
BOLD HEAD MINE B LENS FAULT BLOCK		
DATE PERIOD ending	
SURVEYED		
DRAWN 		
TRACED		
CHECKED		