
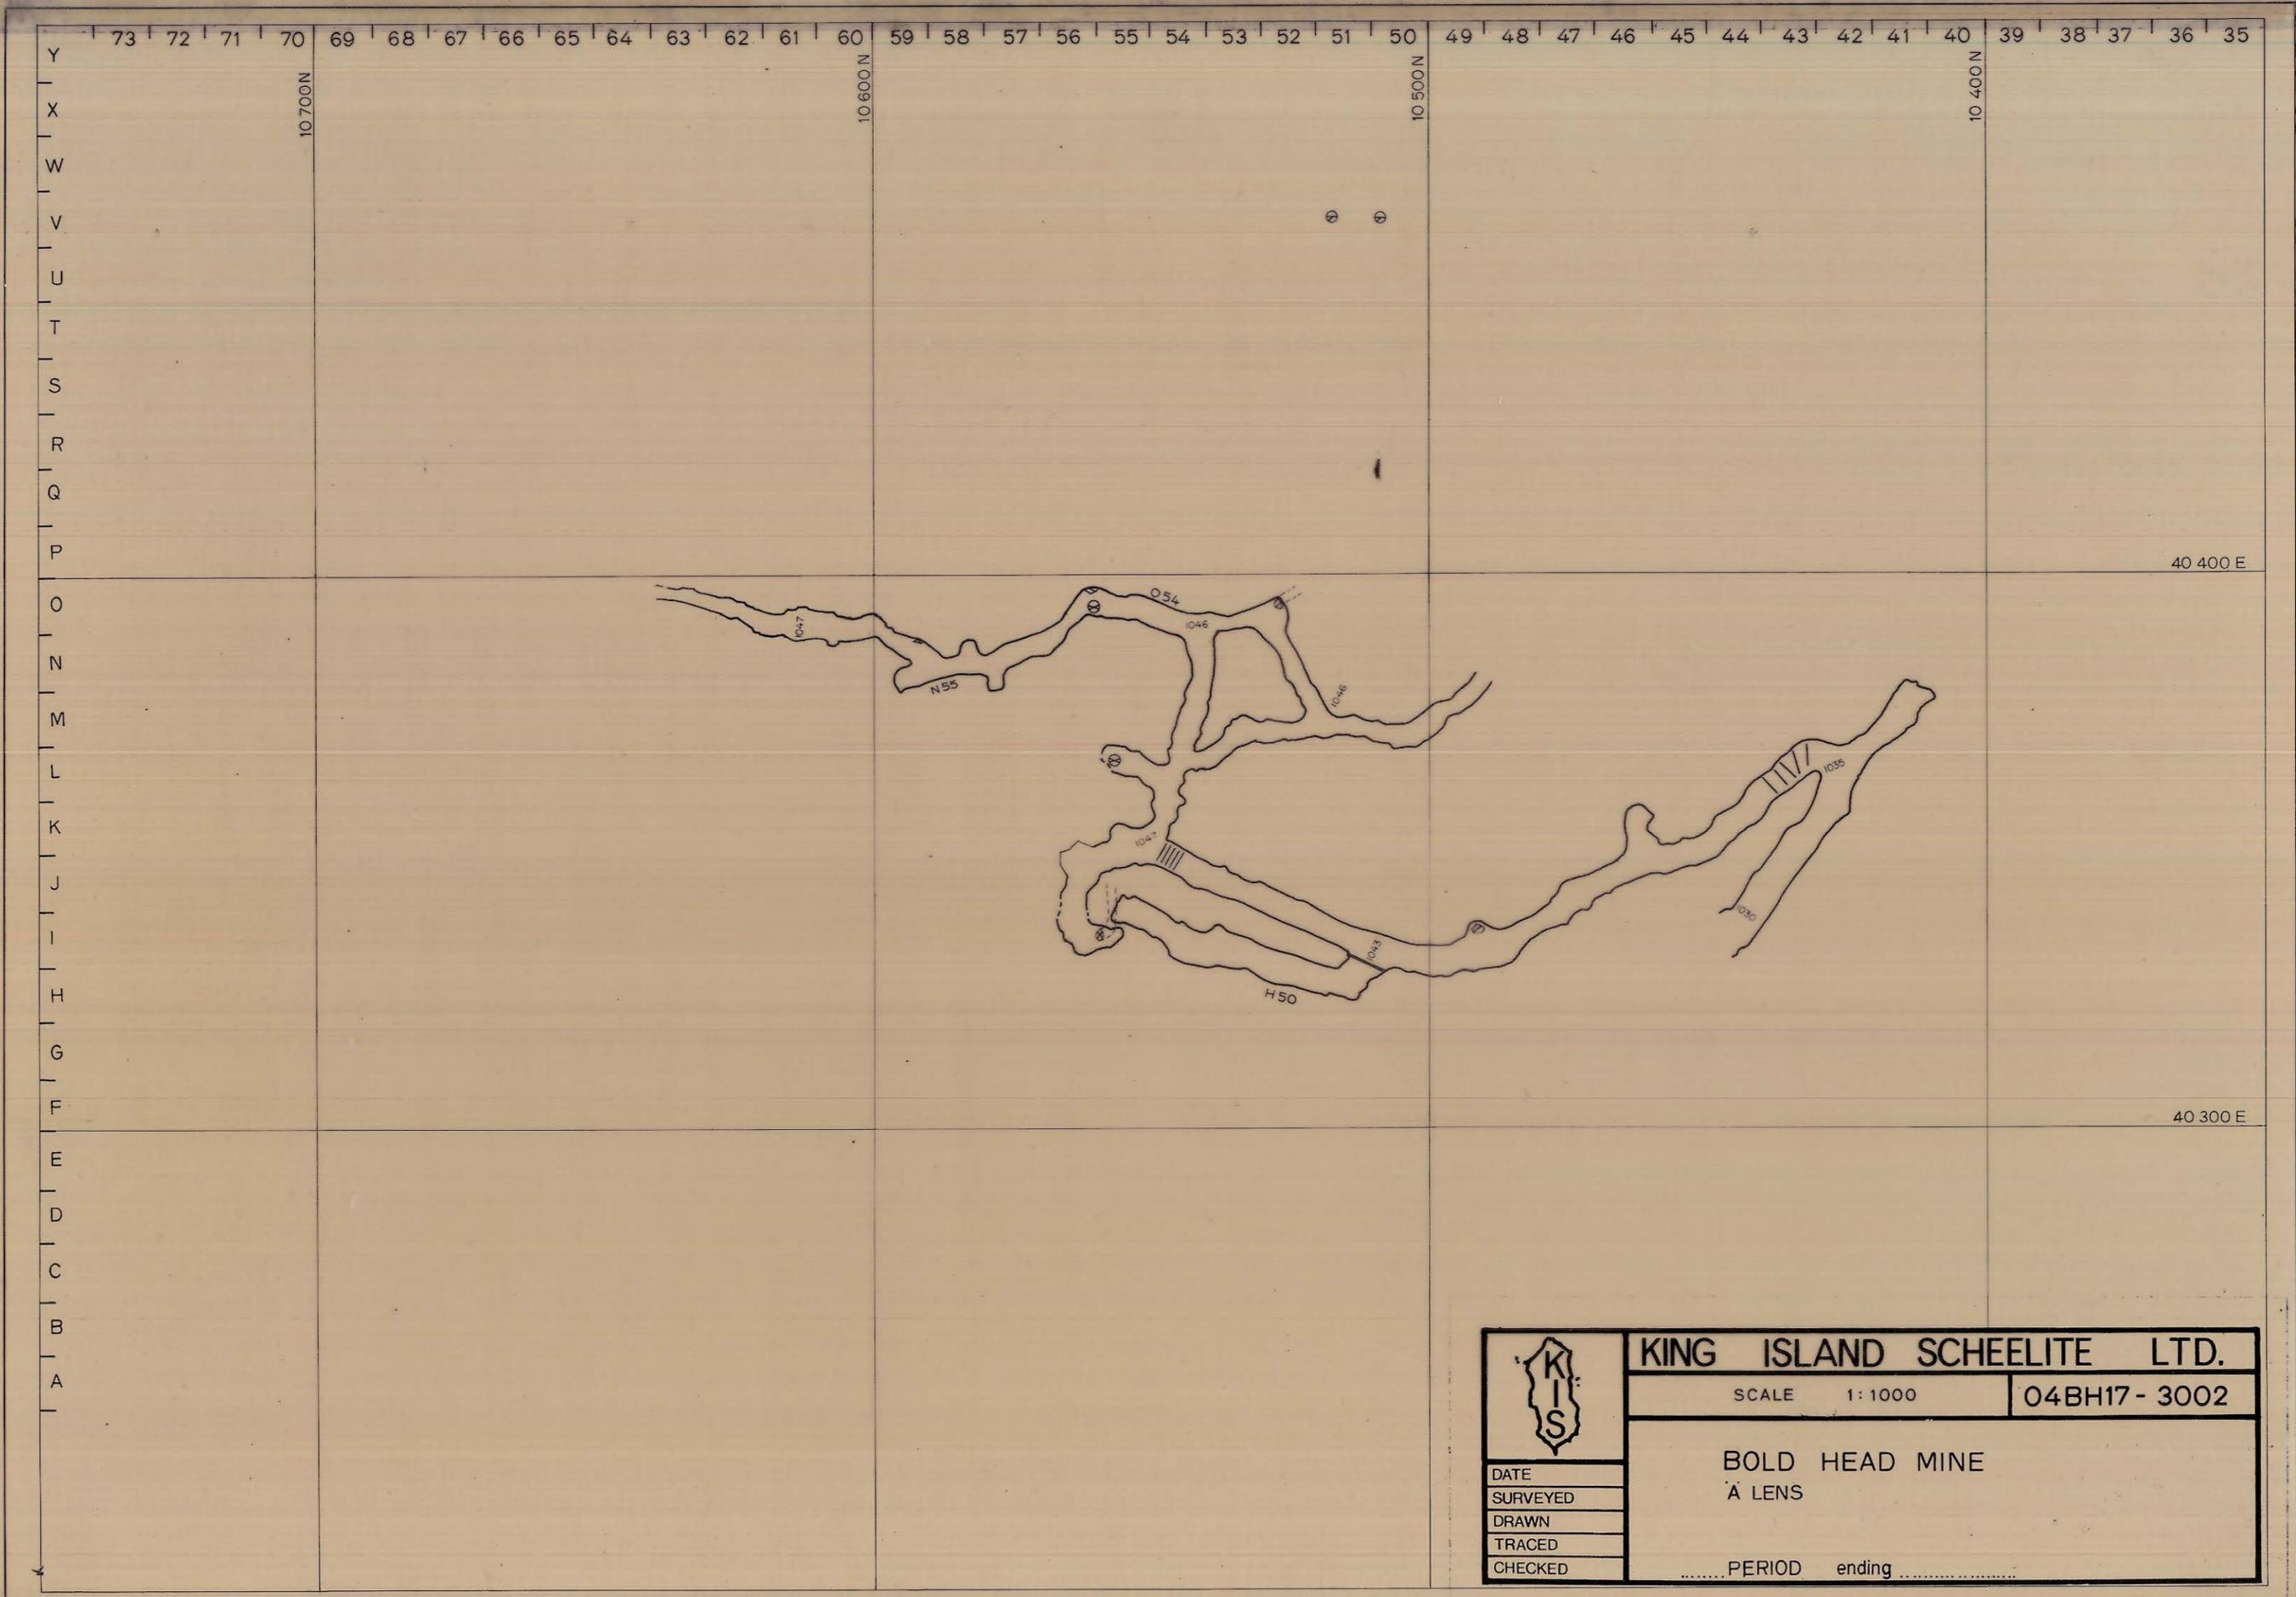


0374_4460

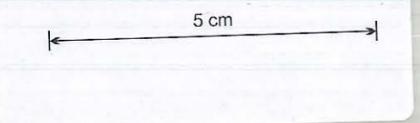

	KING ISLAND SCHEELITE LTD.	
	SCALE 1:1000	04BH17-3002
BOLD HEAD MINE A LENS		
DATE PERIOD ending	
SURVEYED		
DRAWN		
TRACED		
CHECKED		