



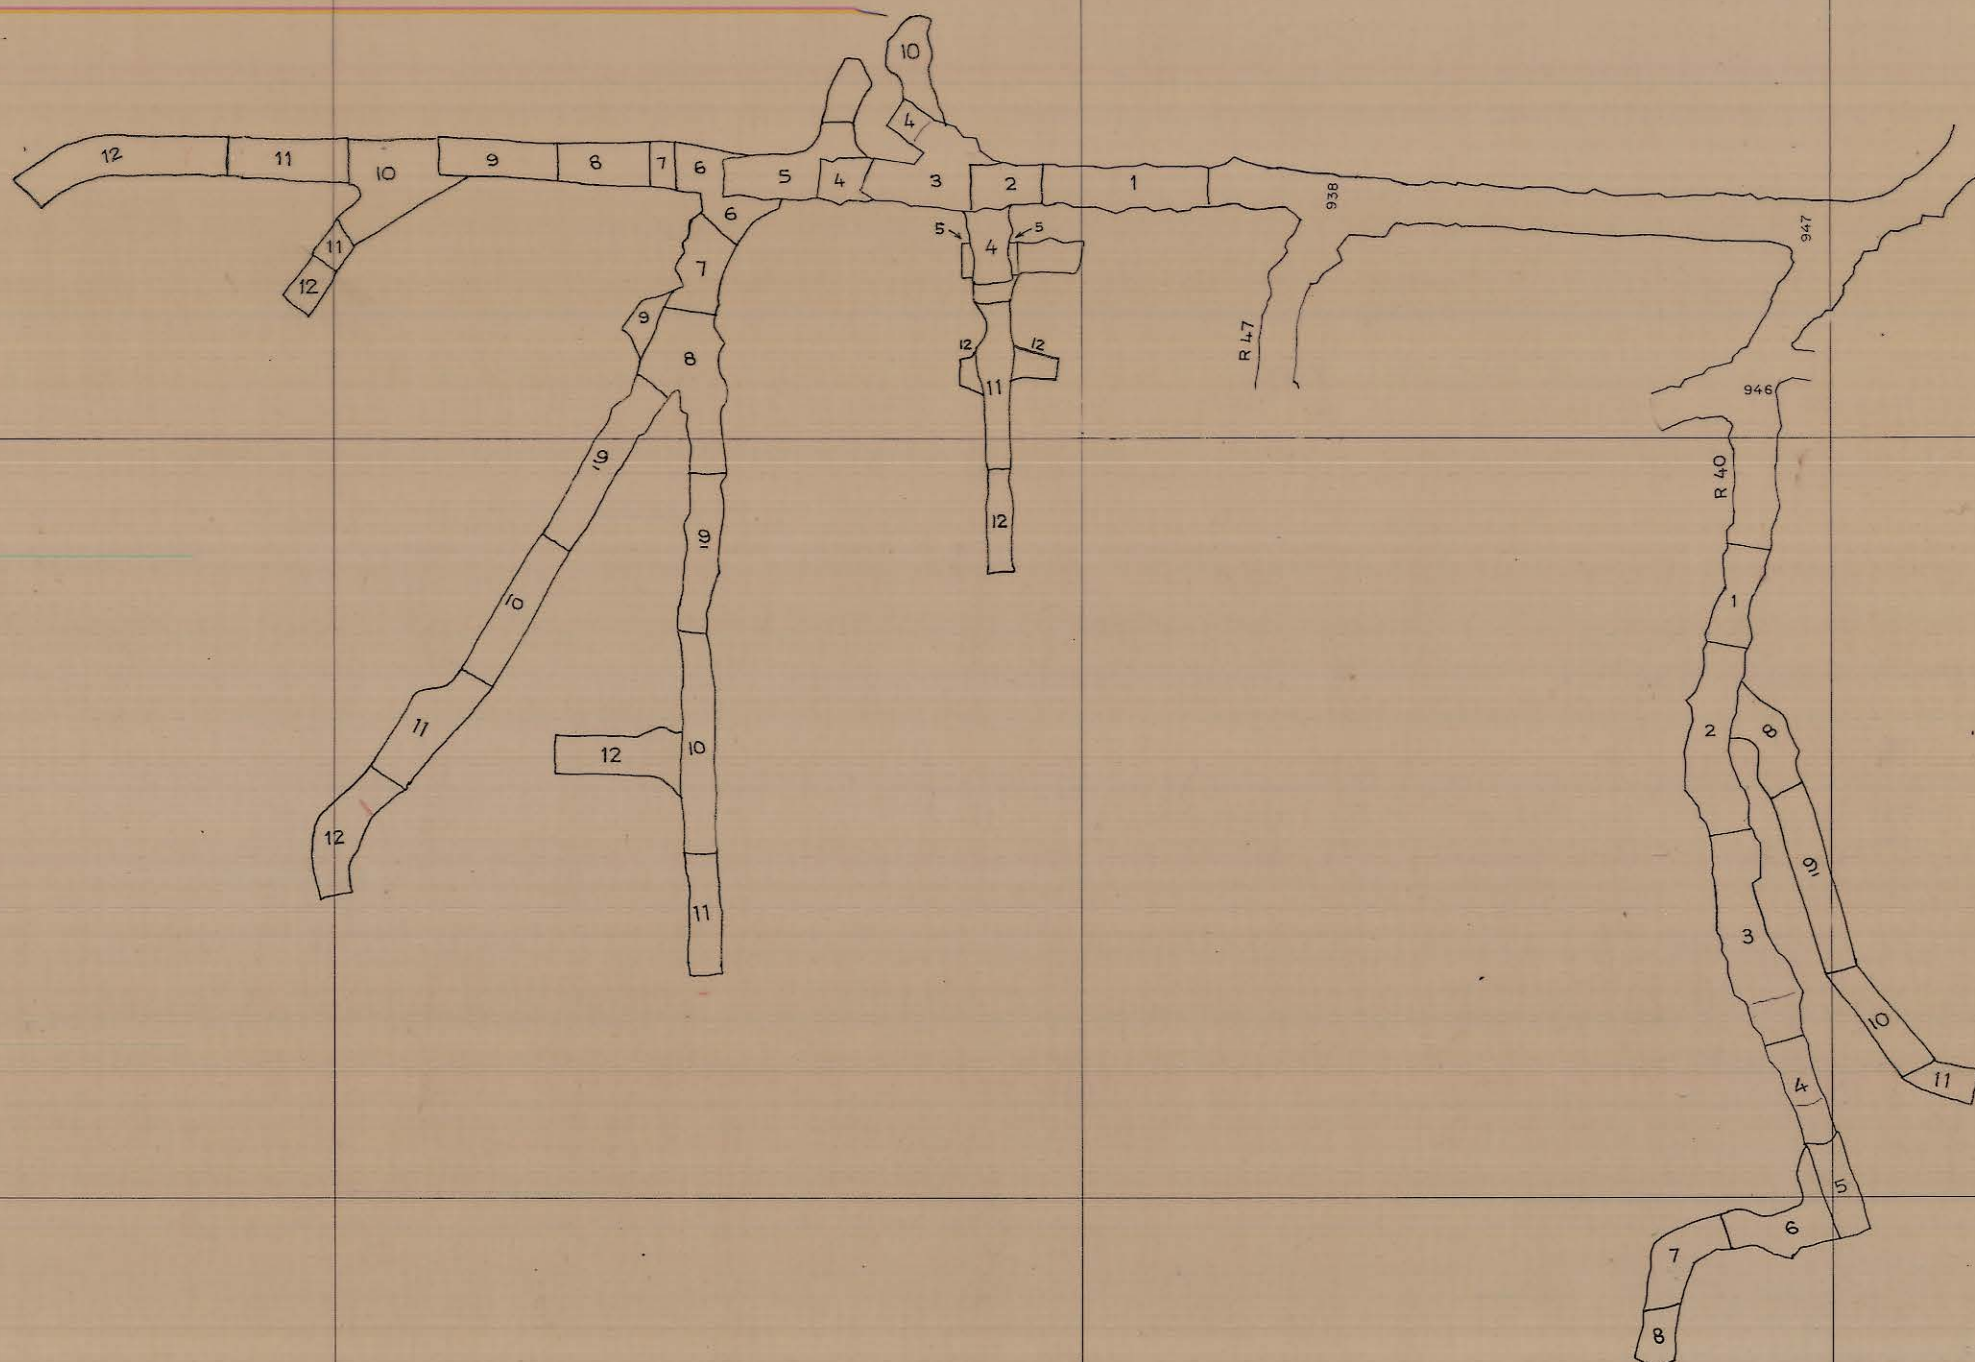

40 400 E

40 300 E

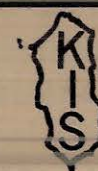

SCALE 1: 1000

04BH17 - 3019

BOLD HEAD MINE

DATE
SURVEYED
DRAWN &
TRACED
CHECKED