


5 cm

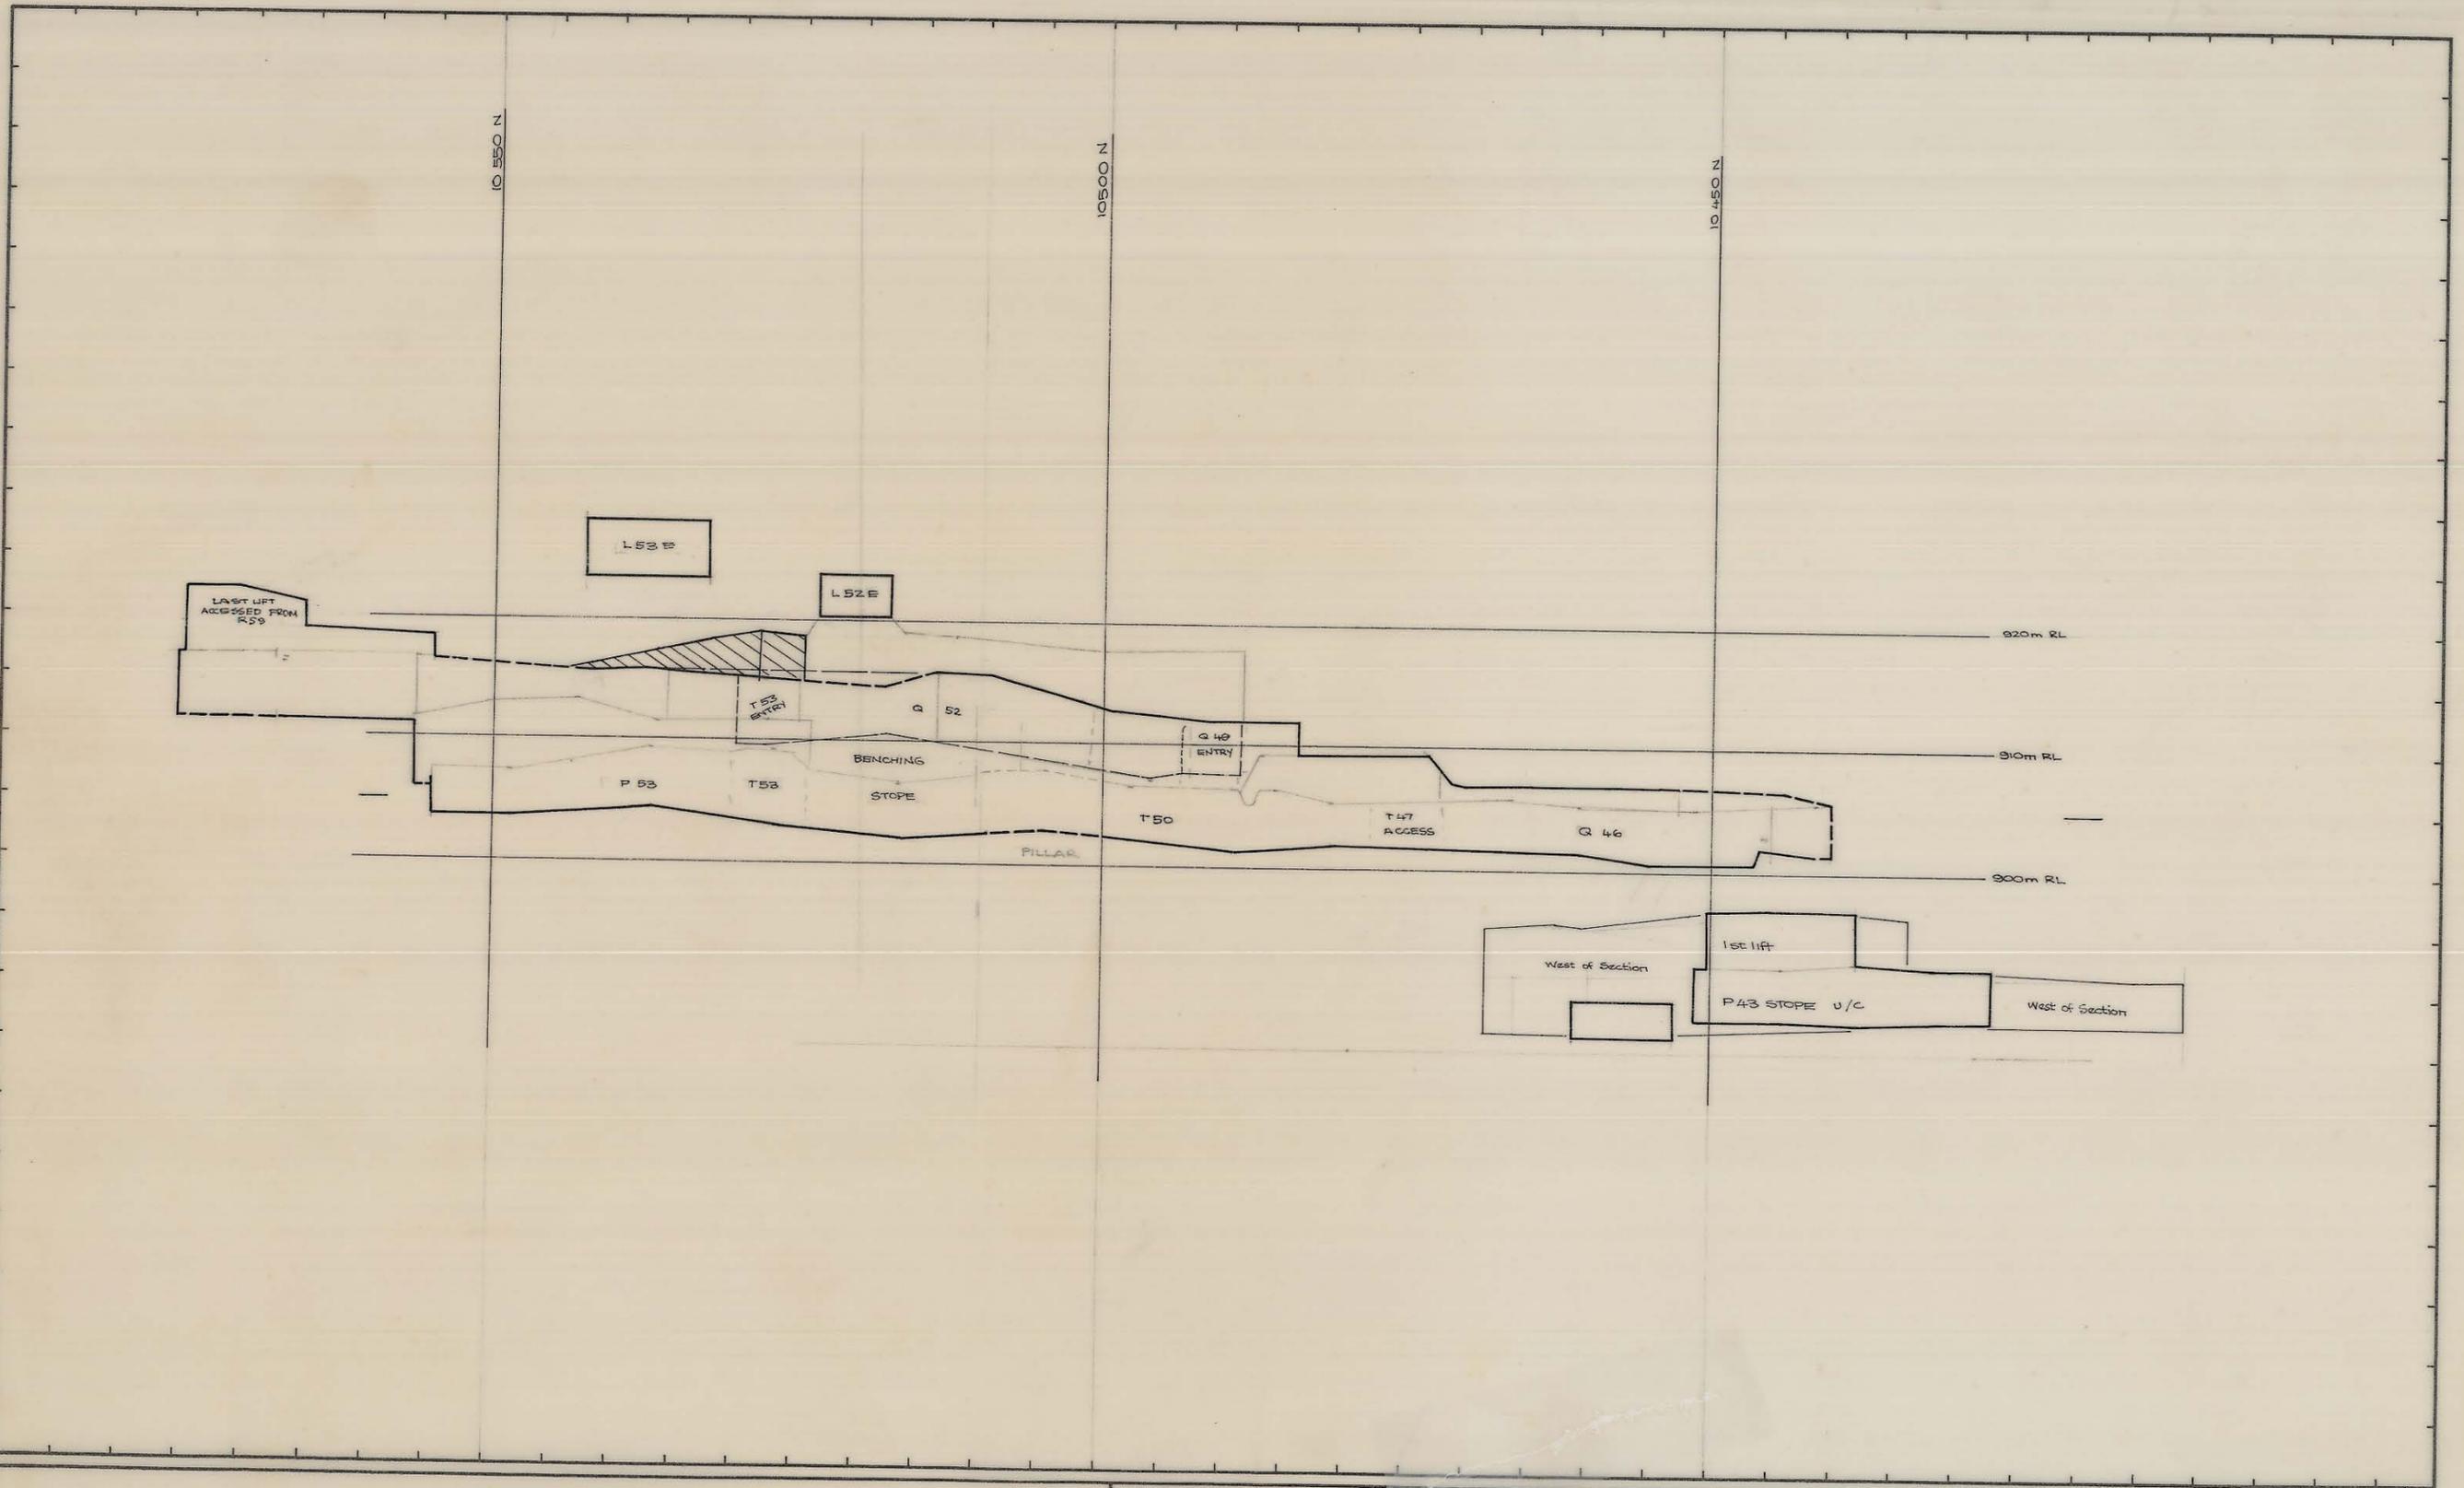

REF PLAN	GEOLOGY			SCALE 1: 500	
	SURVEY				
	PLANNING				
	ROCK MEC.				
	GRADE CON.				
DRAFTING				BOLD HEAD MINE LONG SECTION 40 415 E	
T.S.S.			DRAWING NUMBER 04BH22 - 3003		