


5 cm

04BH22 - 3006

0374\_4467

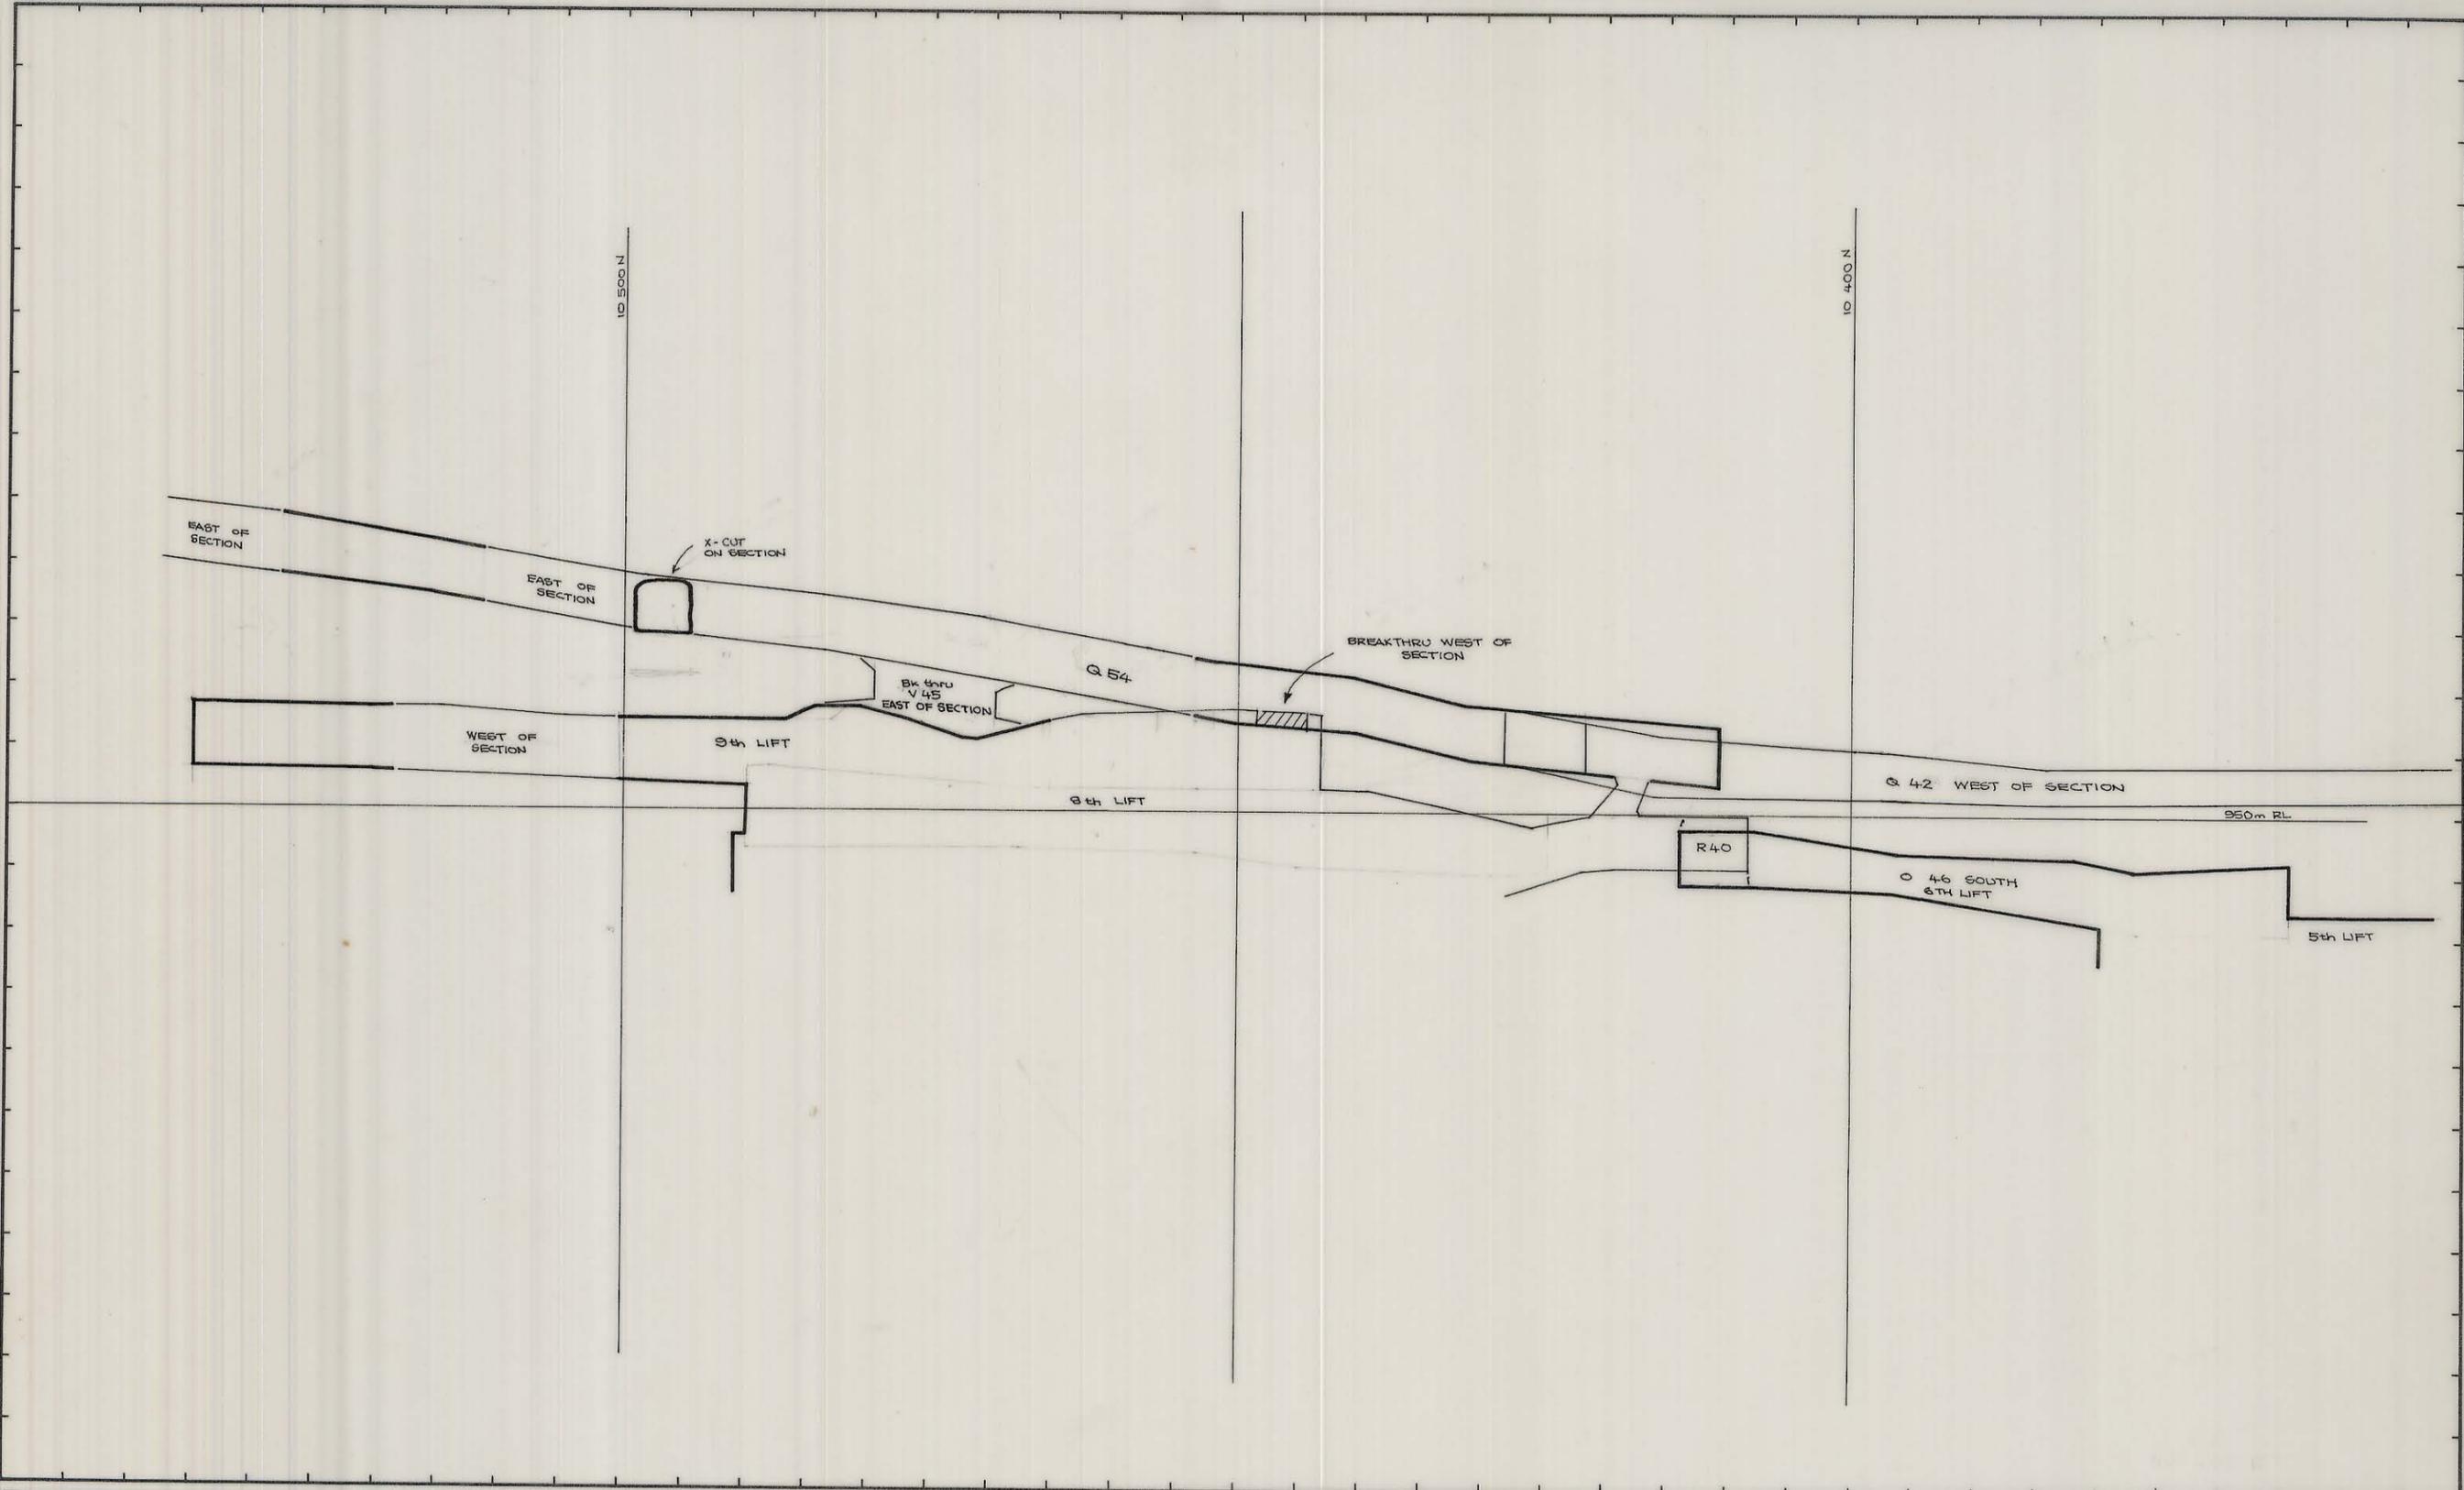

REF. PLAN	GEOLOGY		SCALE 1: 500 
	SURVEY		
	PLANNING		
	ROCK MEC.		
	GRADE CON.		
	DRAFTING		
T.S.S.		LONGSECTION - 046 SLOPE 40 400 E DRAWING NUMBER 04BH22 - 3006	