


04BH18 - 3002

0374\_4470

5 cm

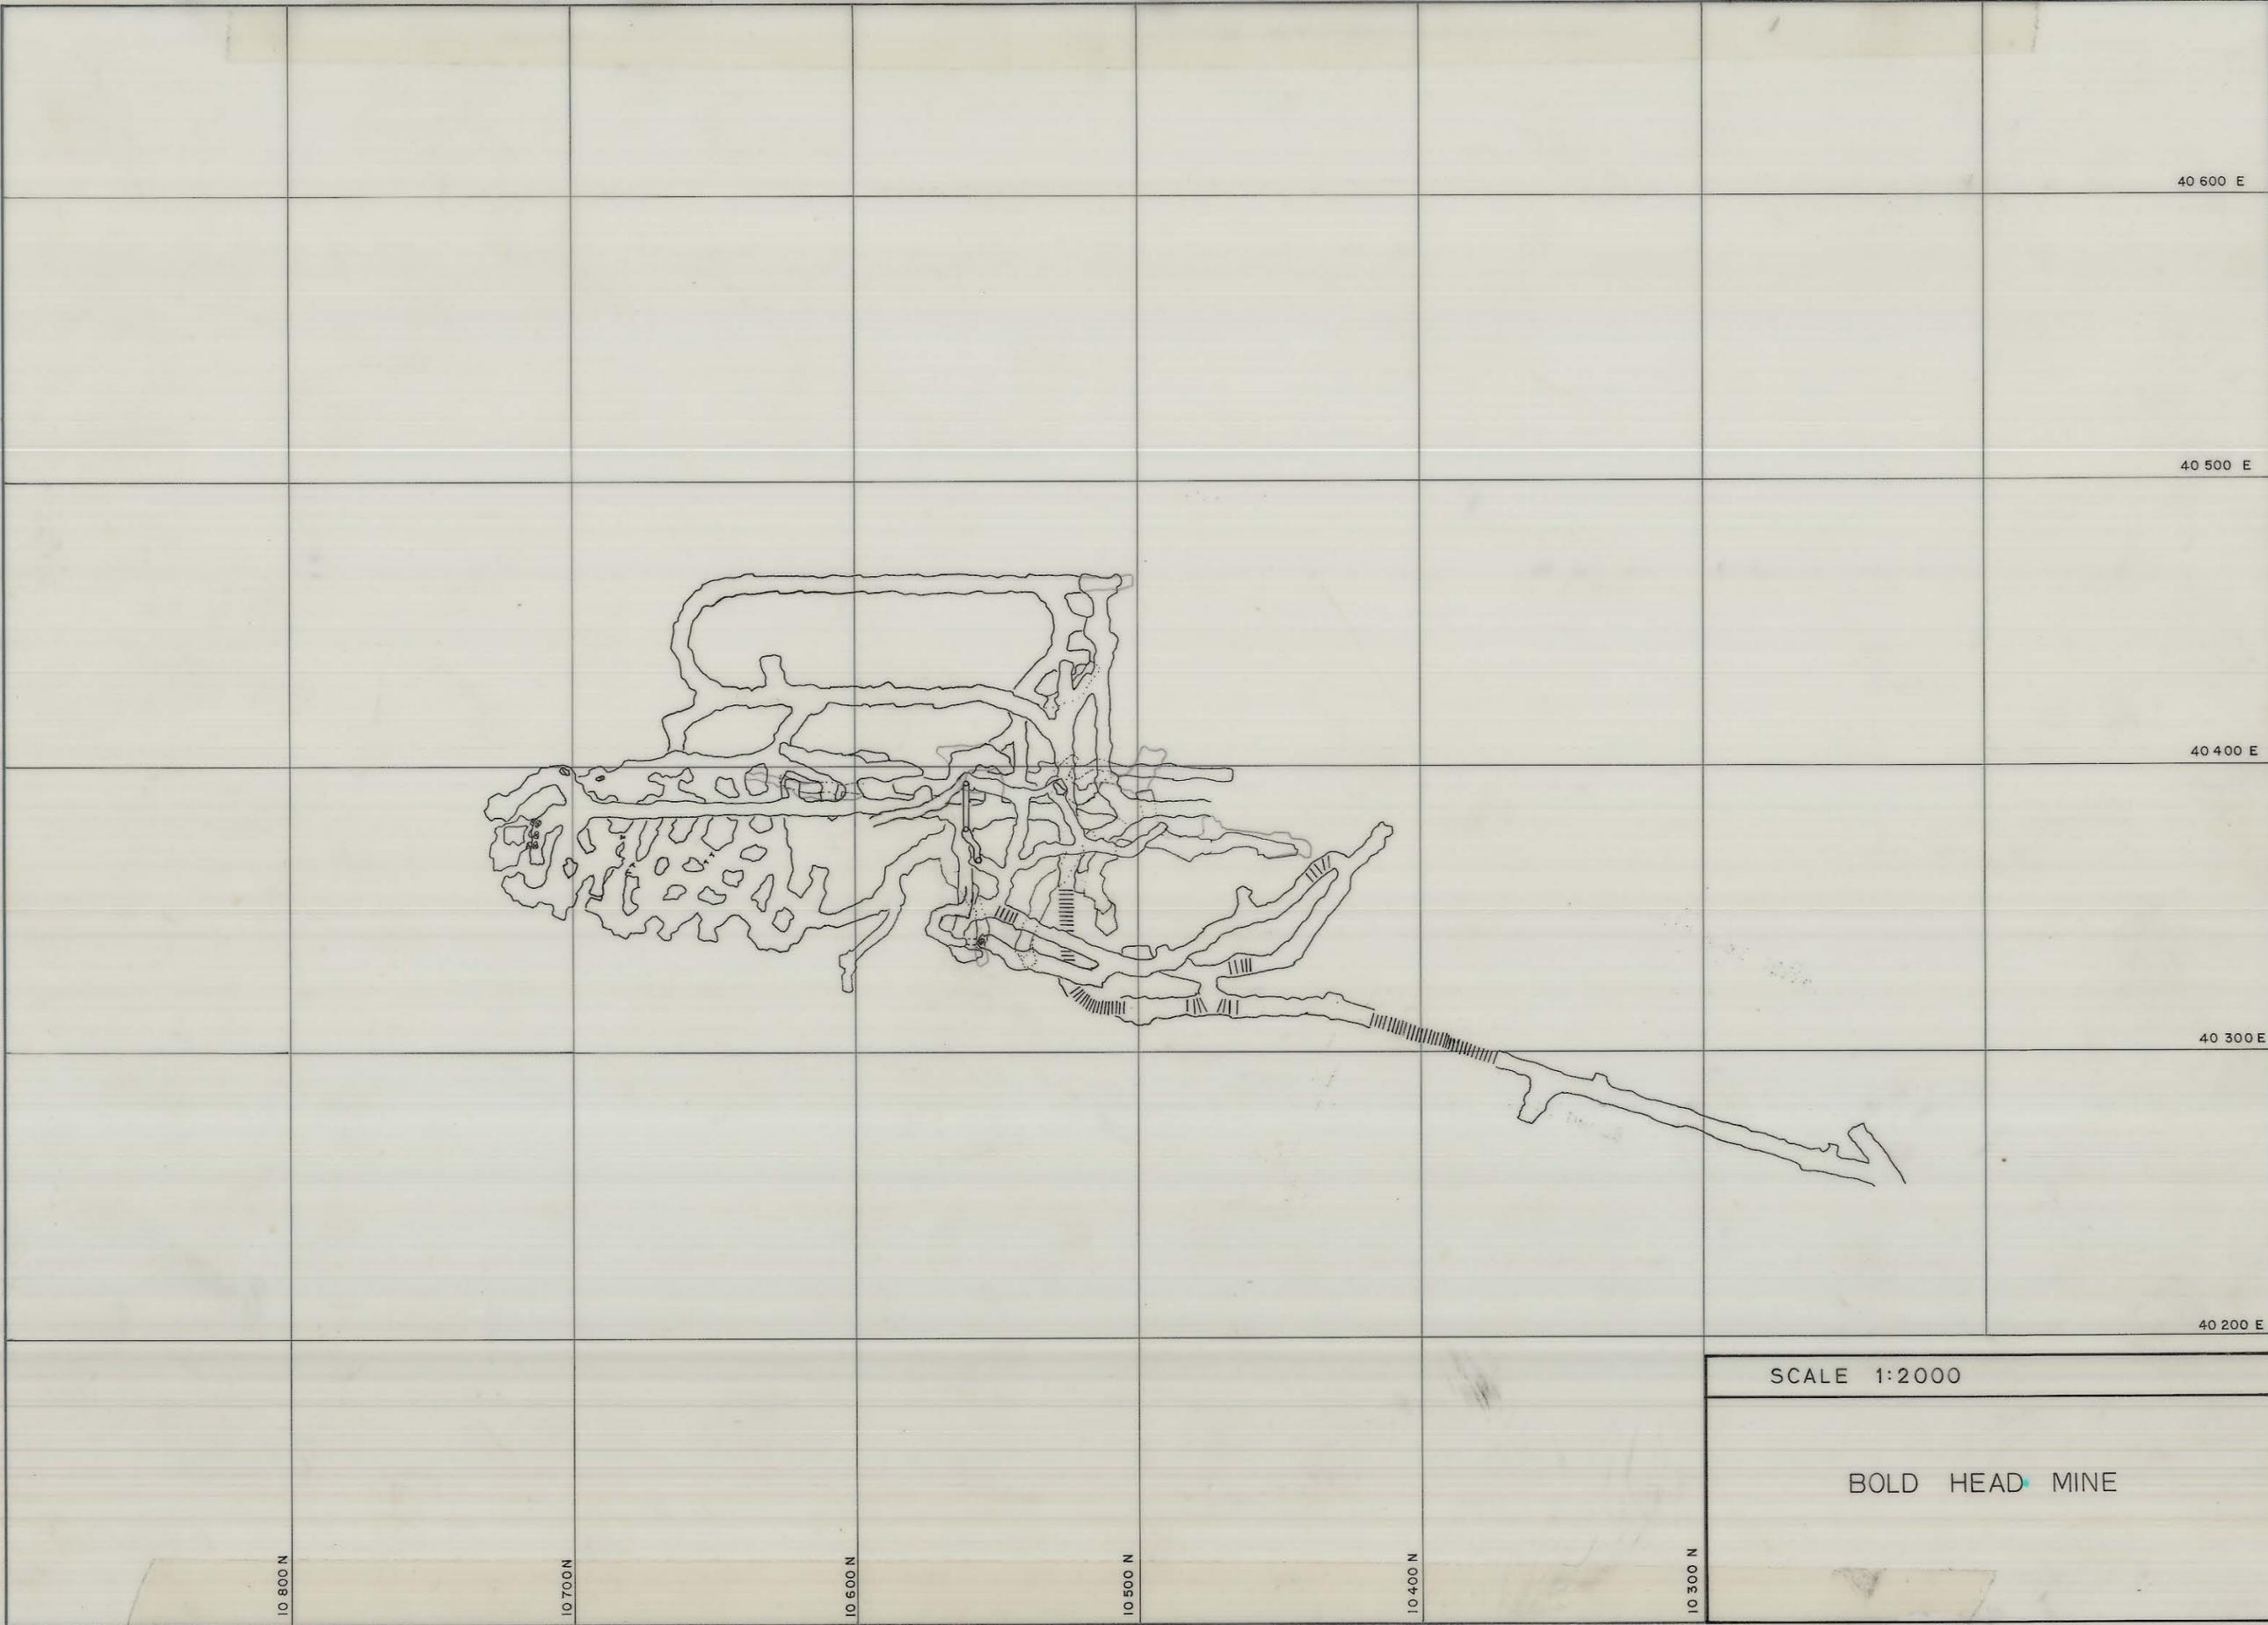

SCALE 1:2000

BOLD HEAD MINE