


5 cm

04BH17 - 3025

0374_4472

27 JUN 1981

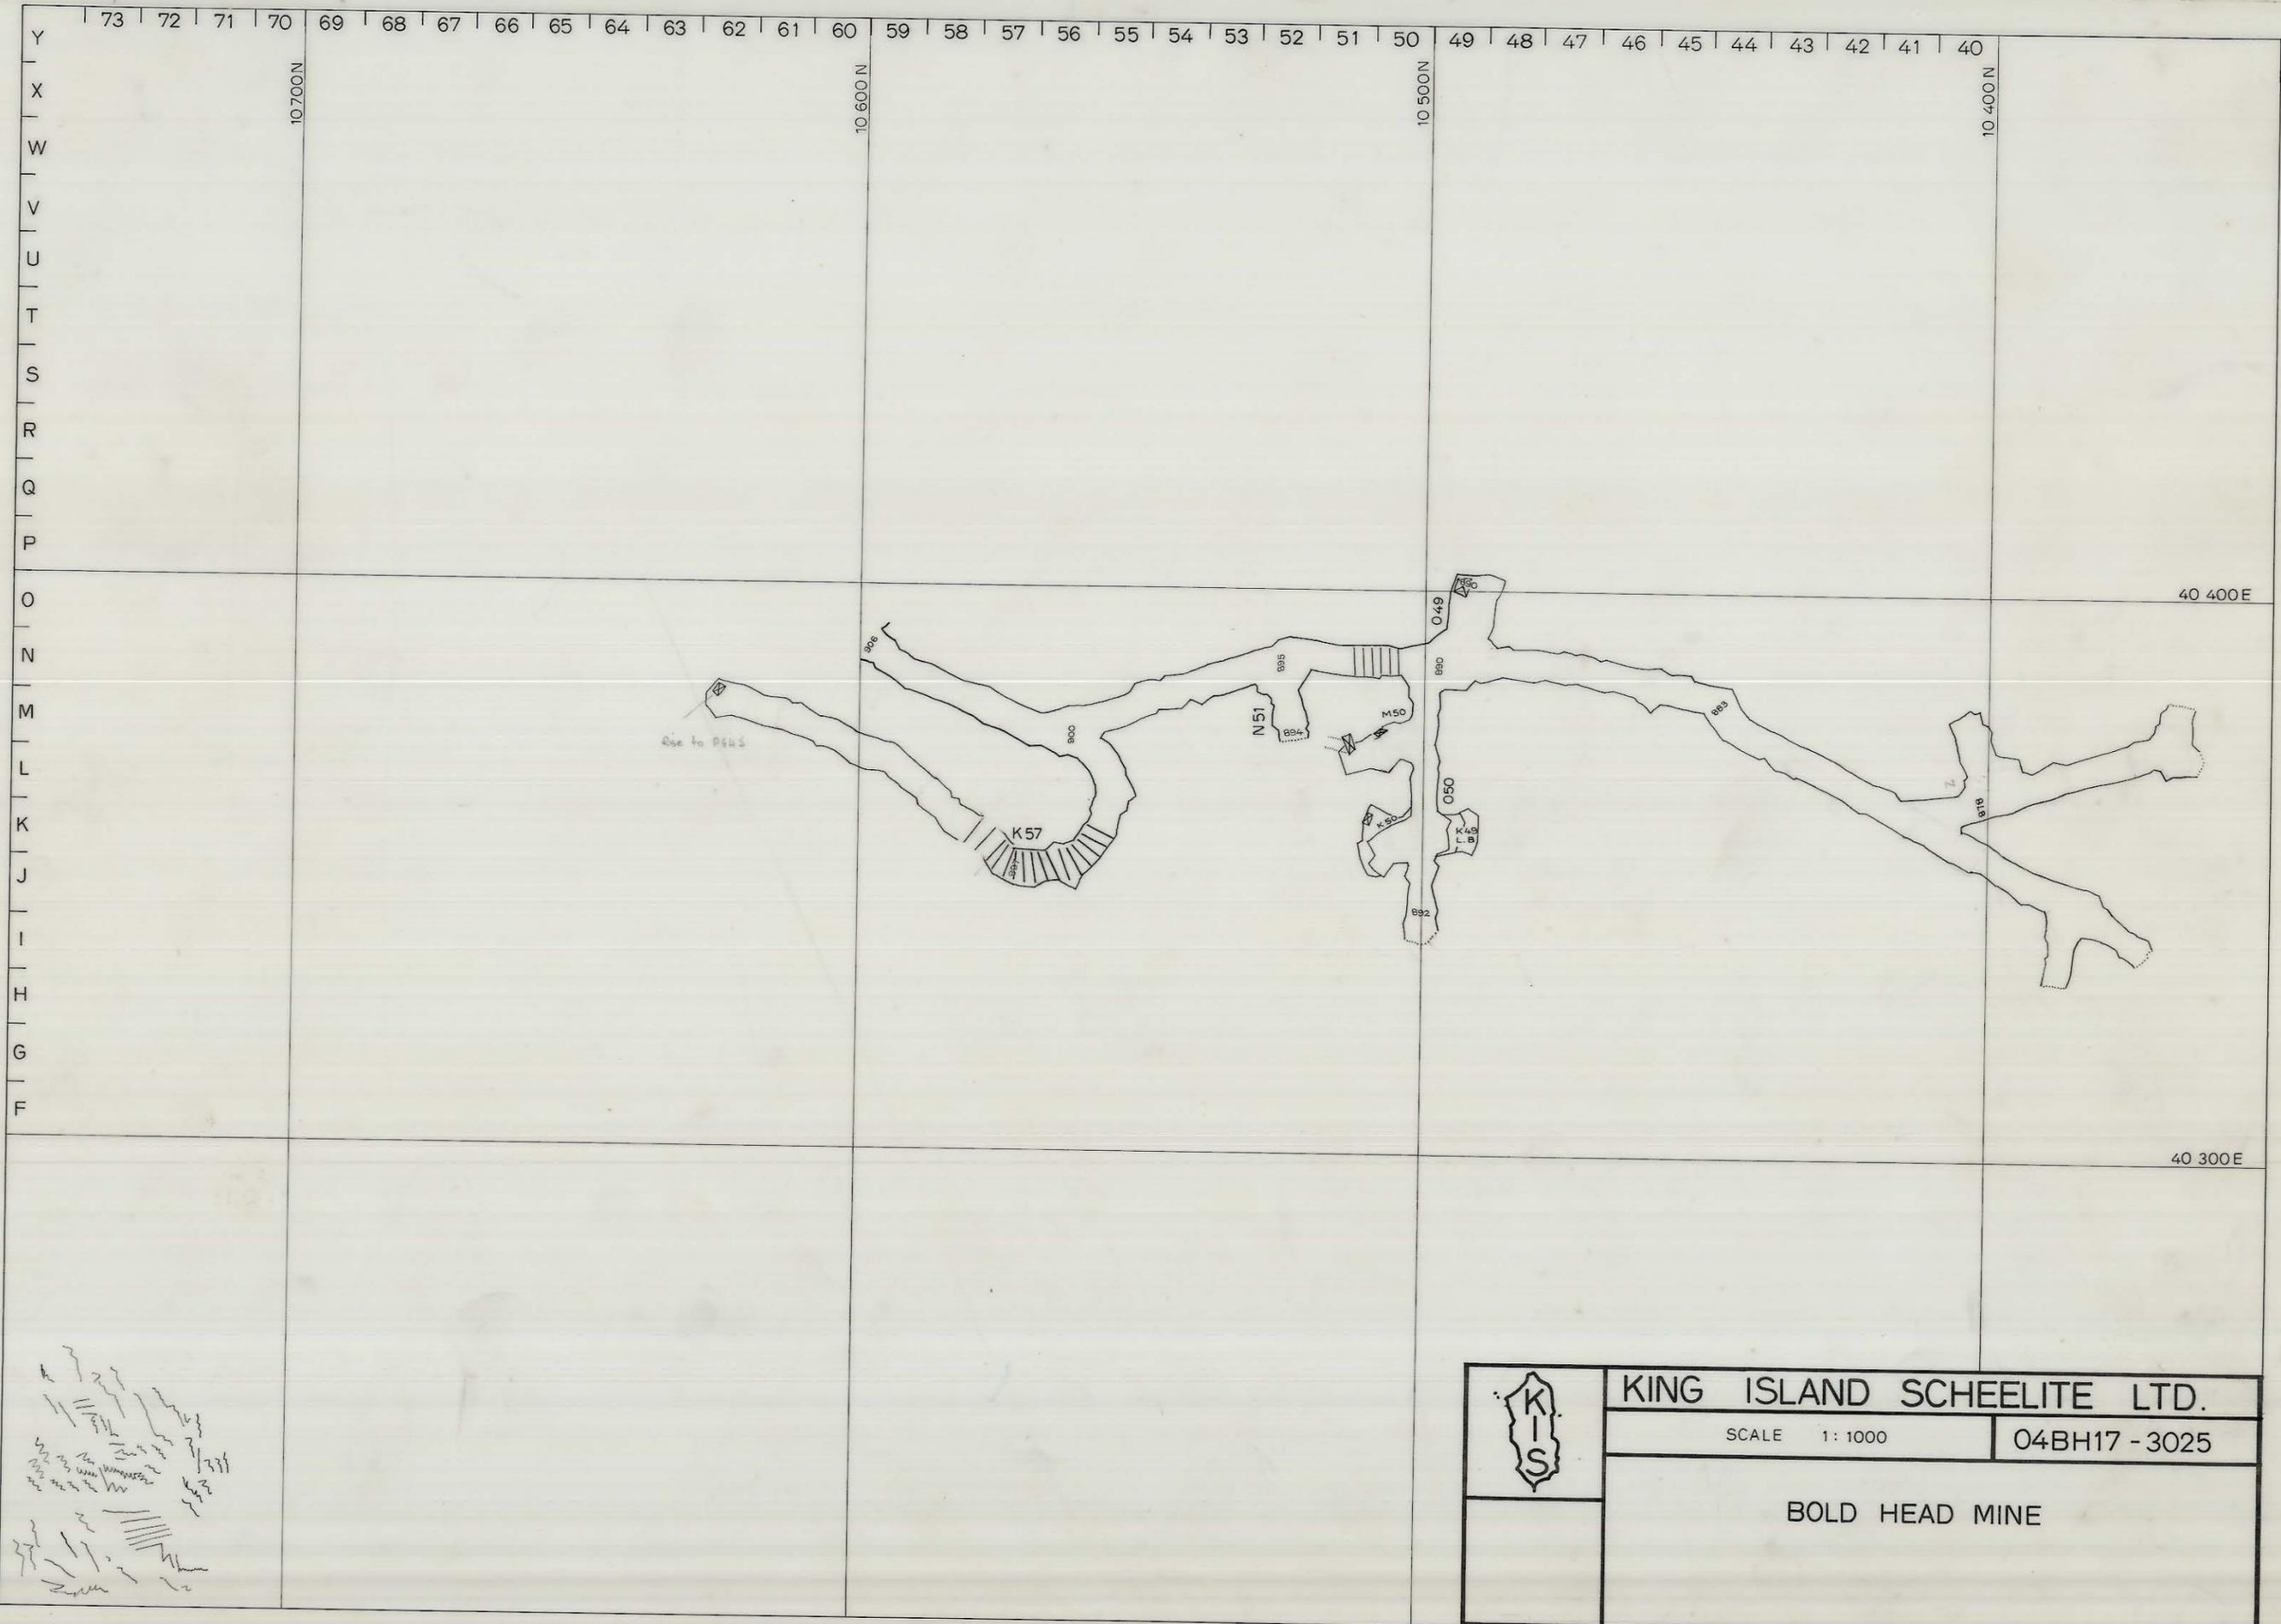

Handwritten notes and scribbles in the bottom left corner of the map area, including several lines of illegible text and wavy lines.

	KING ISLAND SCHEELITE LTD.	
	SCALE 1:1000	04BH17 - 3025
BOLD HEAD MINE		