


1:1000
Bald Head Mine
Overall Plan
Showing all levels

0374_4473

04BH17-2004

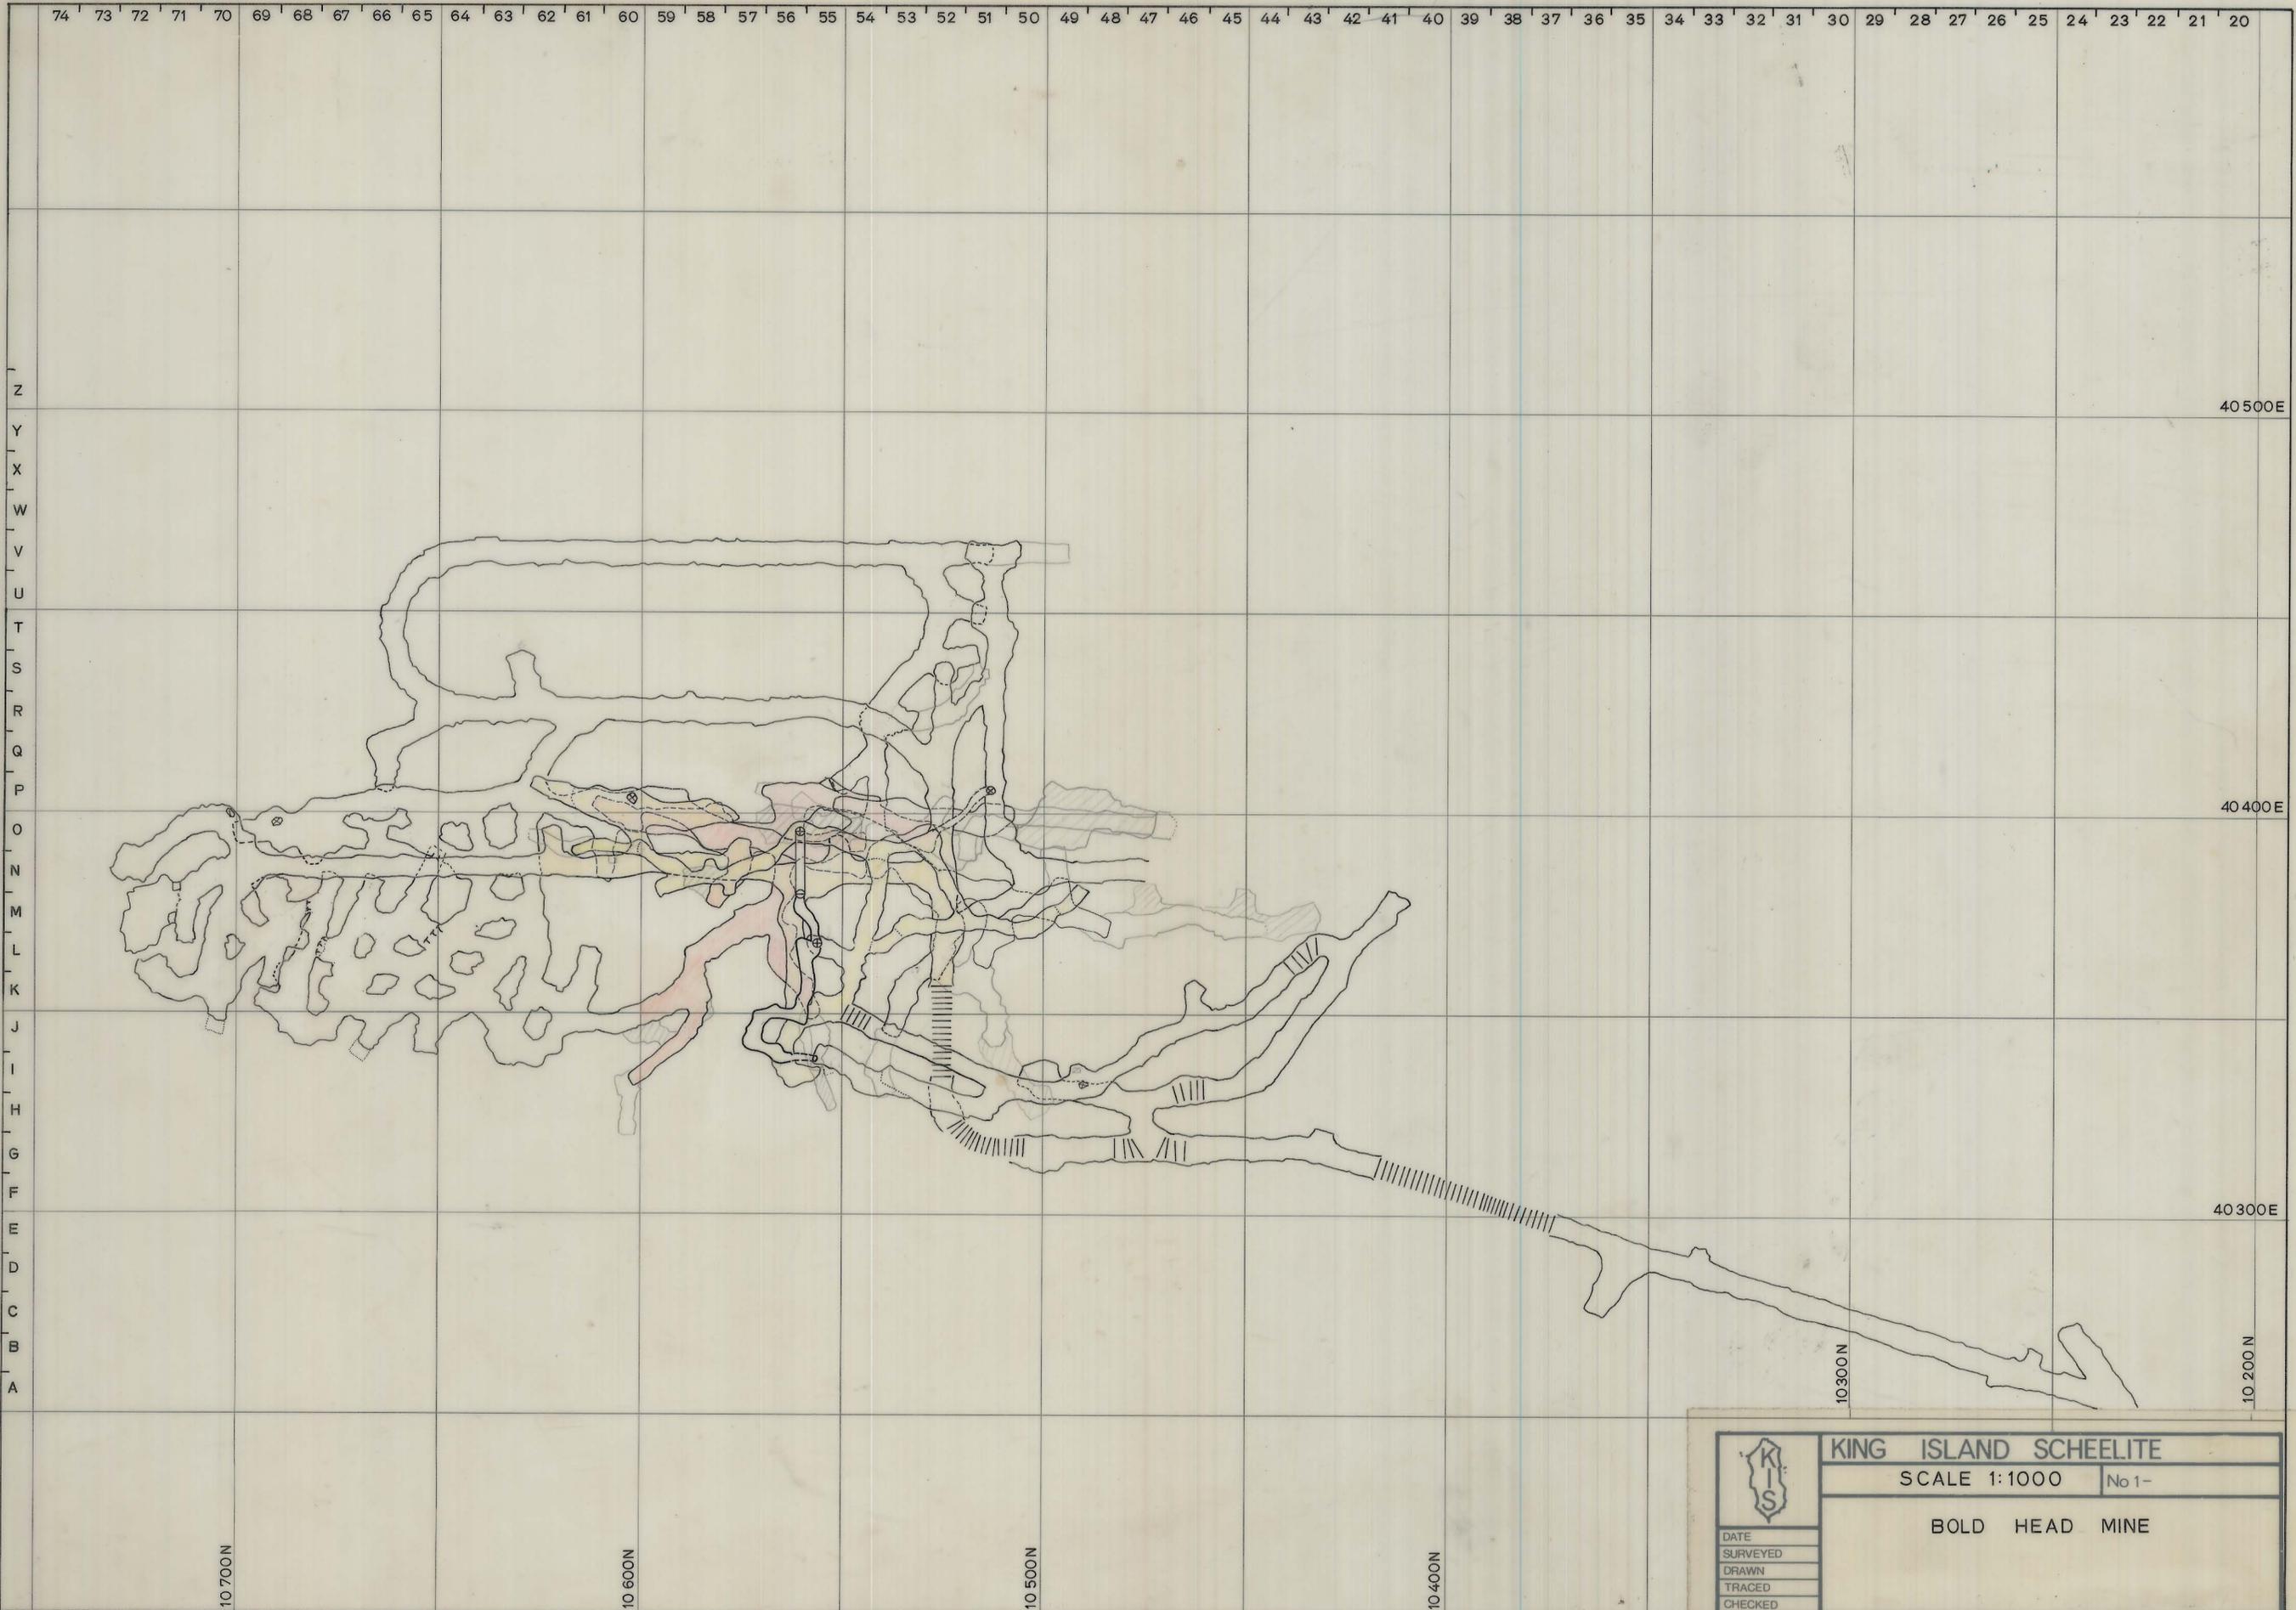

5 cm

10 700N

10 600N

10 500N

10 400N

10 300N

10 200N

40 500E

40 400E

40 300E

	KING ISLAND SCHEELITE	
	SCALE 1:1000	No 1-
BOLD HEAD MINE		
DATE		
SURVEYED		
DRAWN		
TRACED		
CHECKED		