


27 JUN 1981

5 cm

04BH13-165 086

H50 LIFT 8

0374-4476

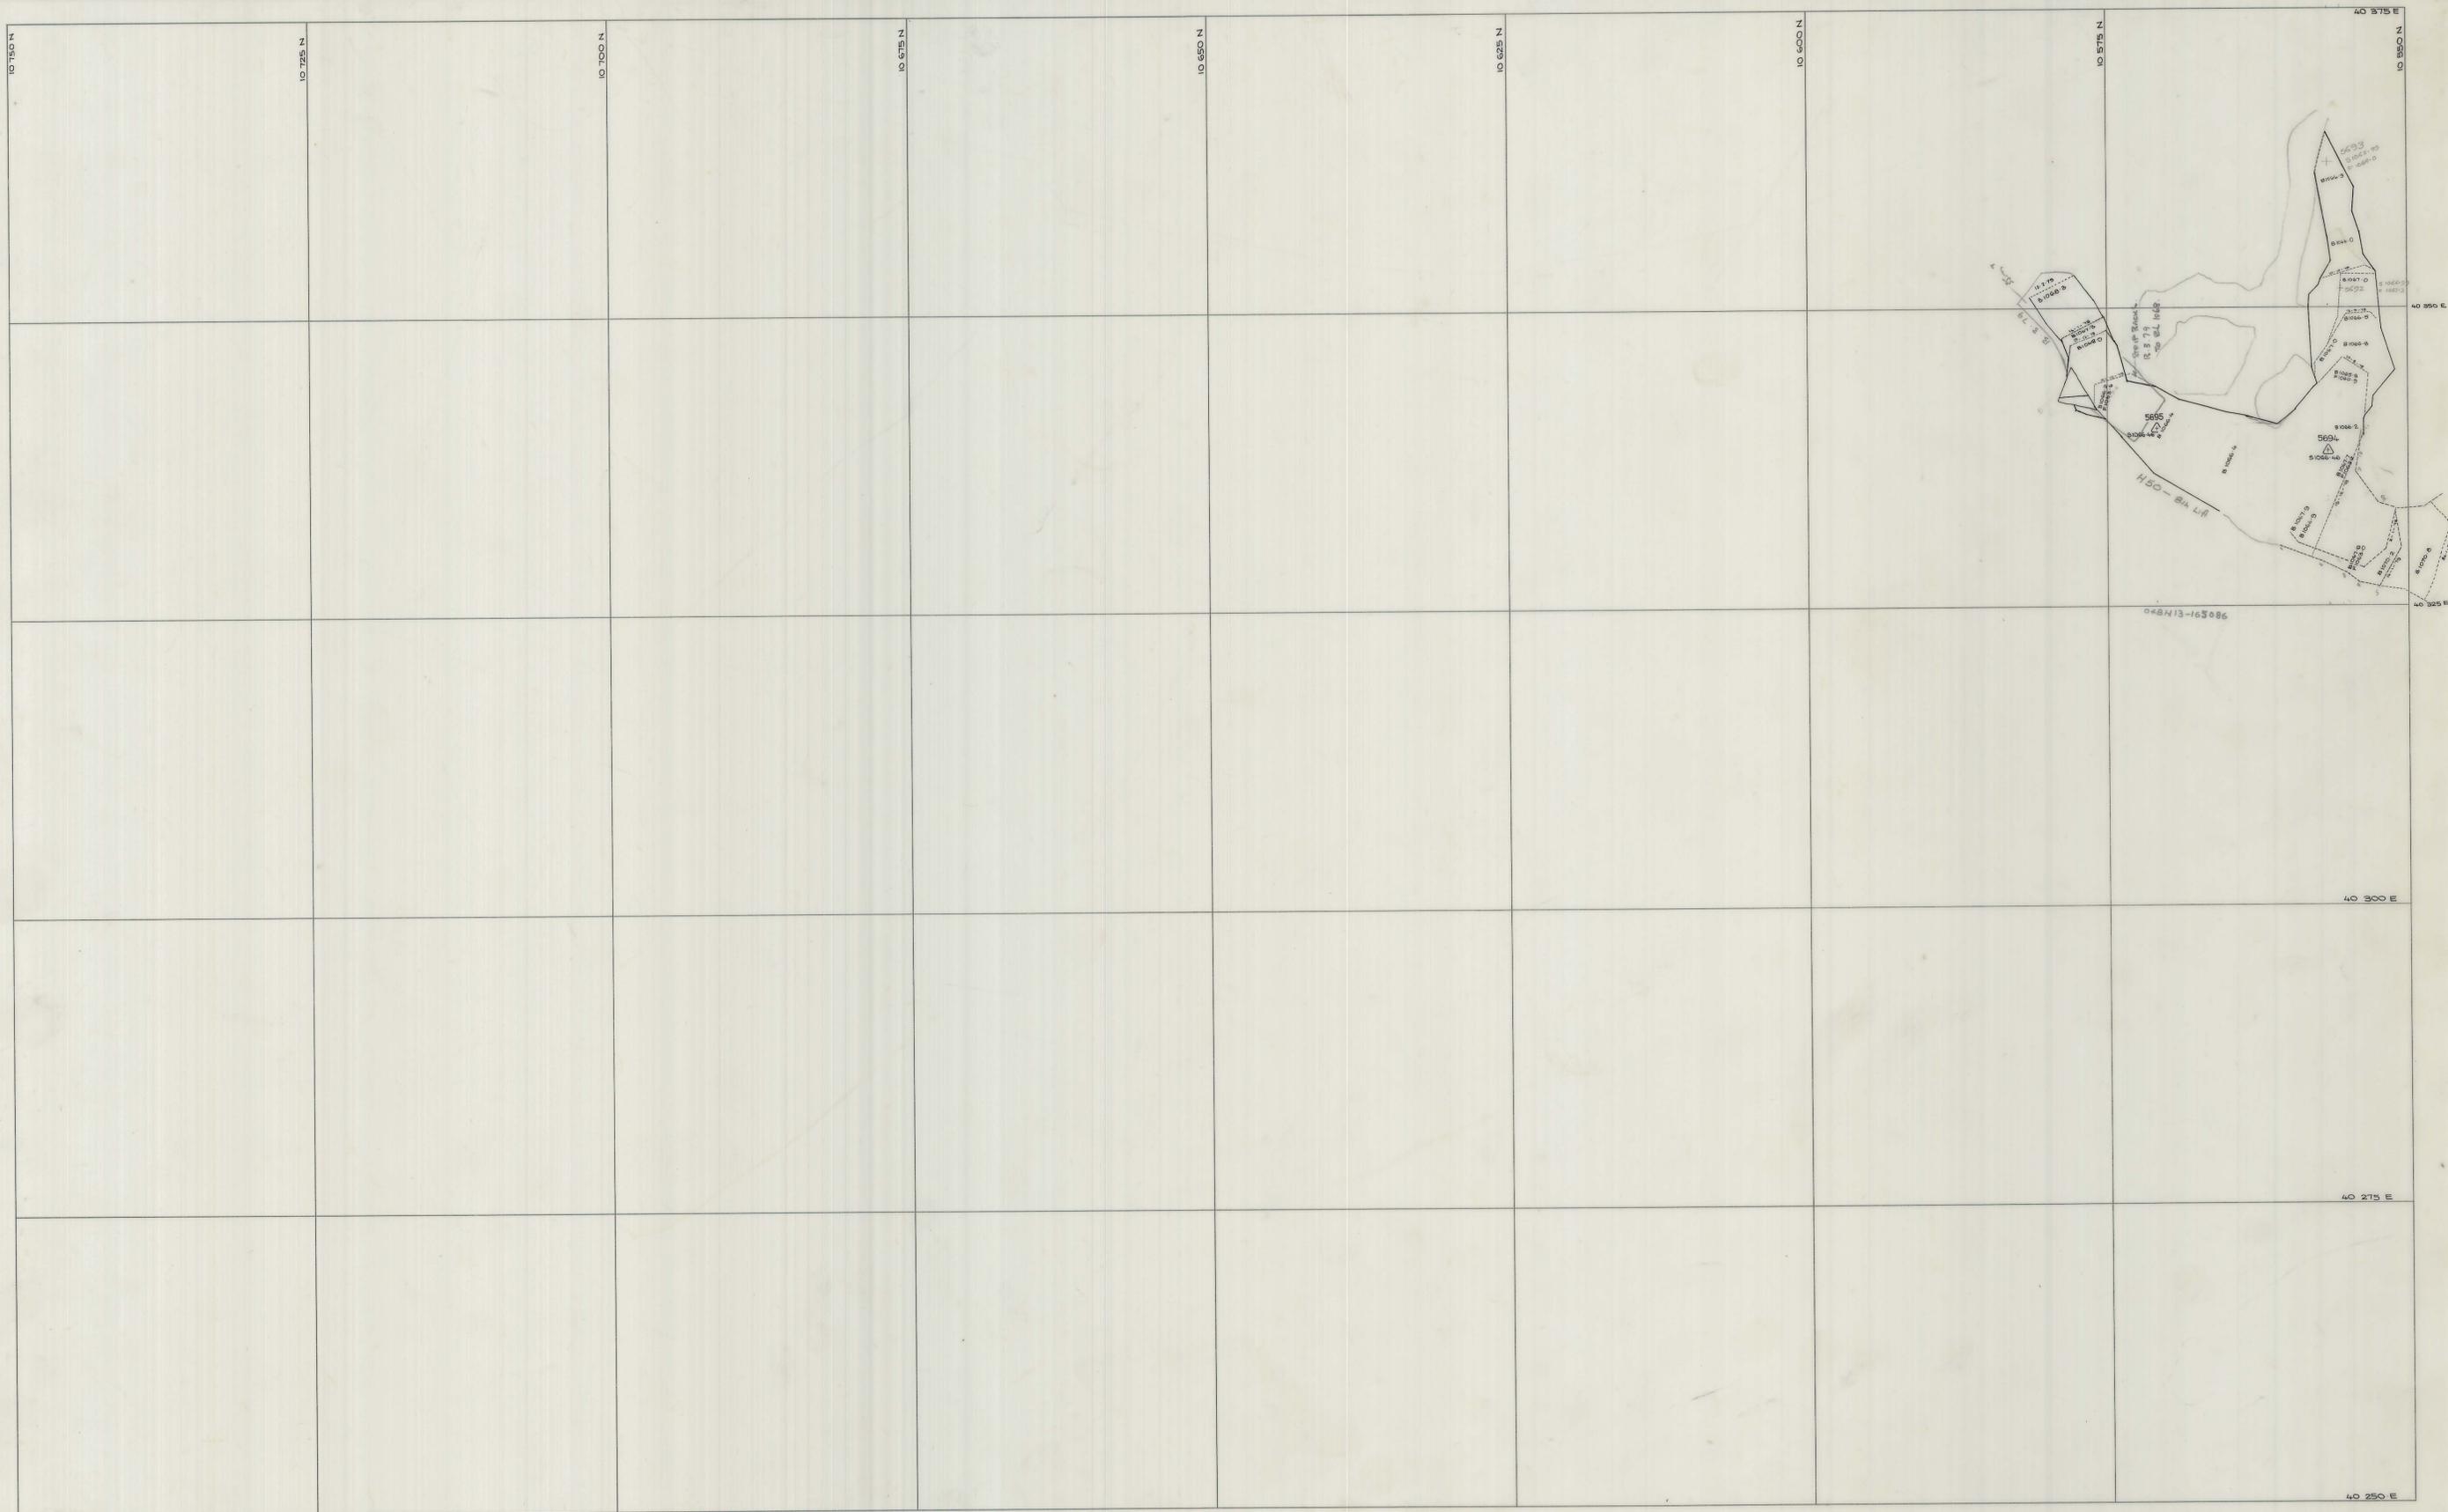

SCALE 1:250

LOCATION

BOLD HEAD MINE

SUBJECT

A LENS

H50 STOPE

LIFT 8

north

KIS KING ISLAND SCHEELITE
 A DIVISION OF WARMAN INTERNATIONAL
 GRASSY KING ISLAND

PLAN NUMBER

04BH13 - 165 086