
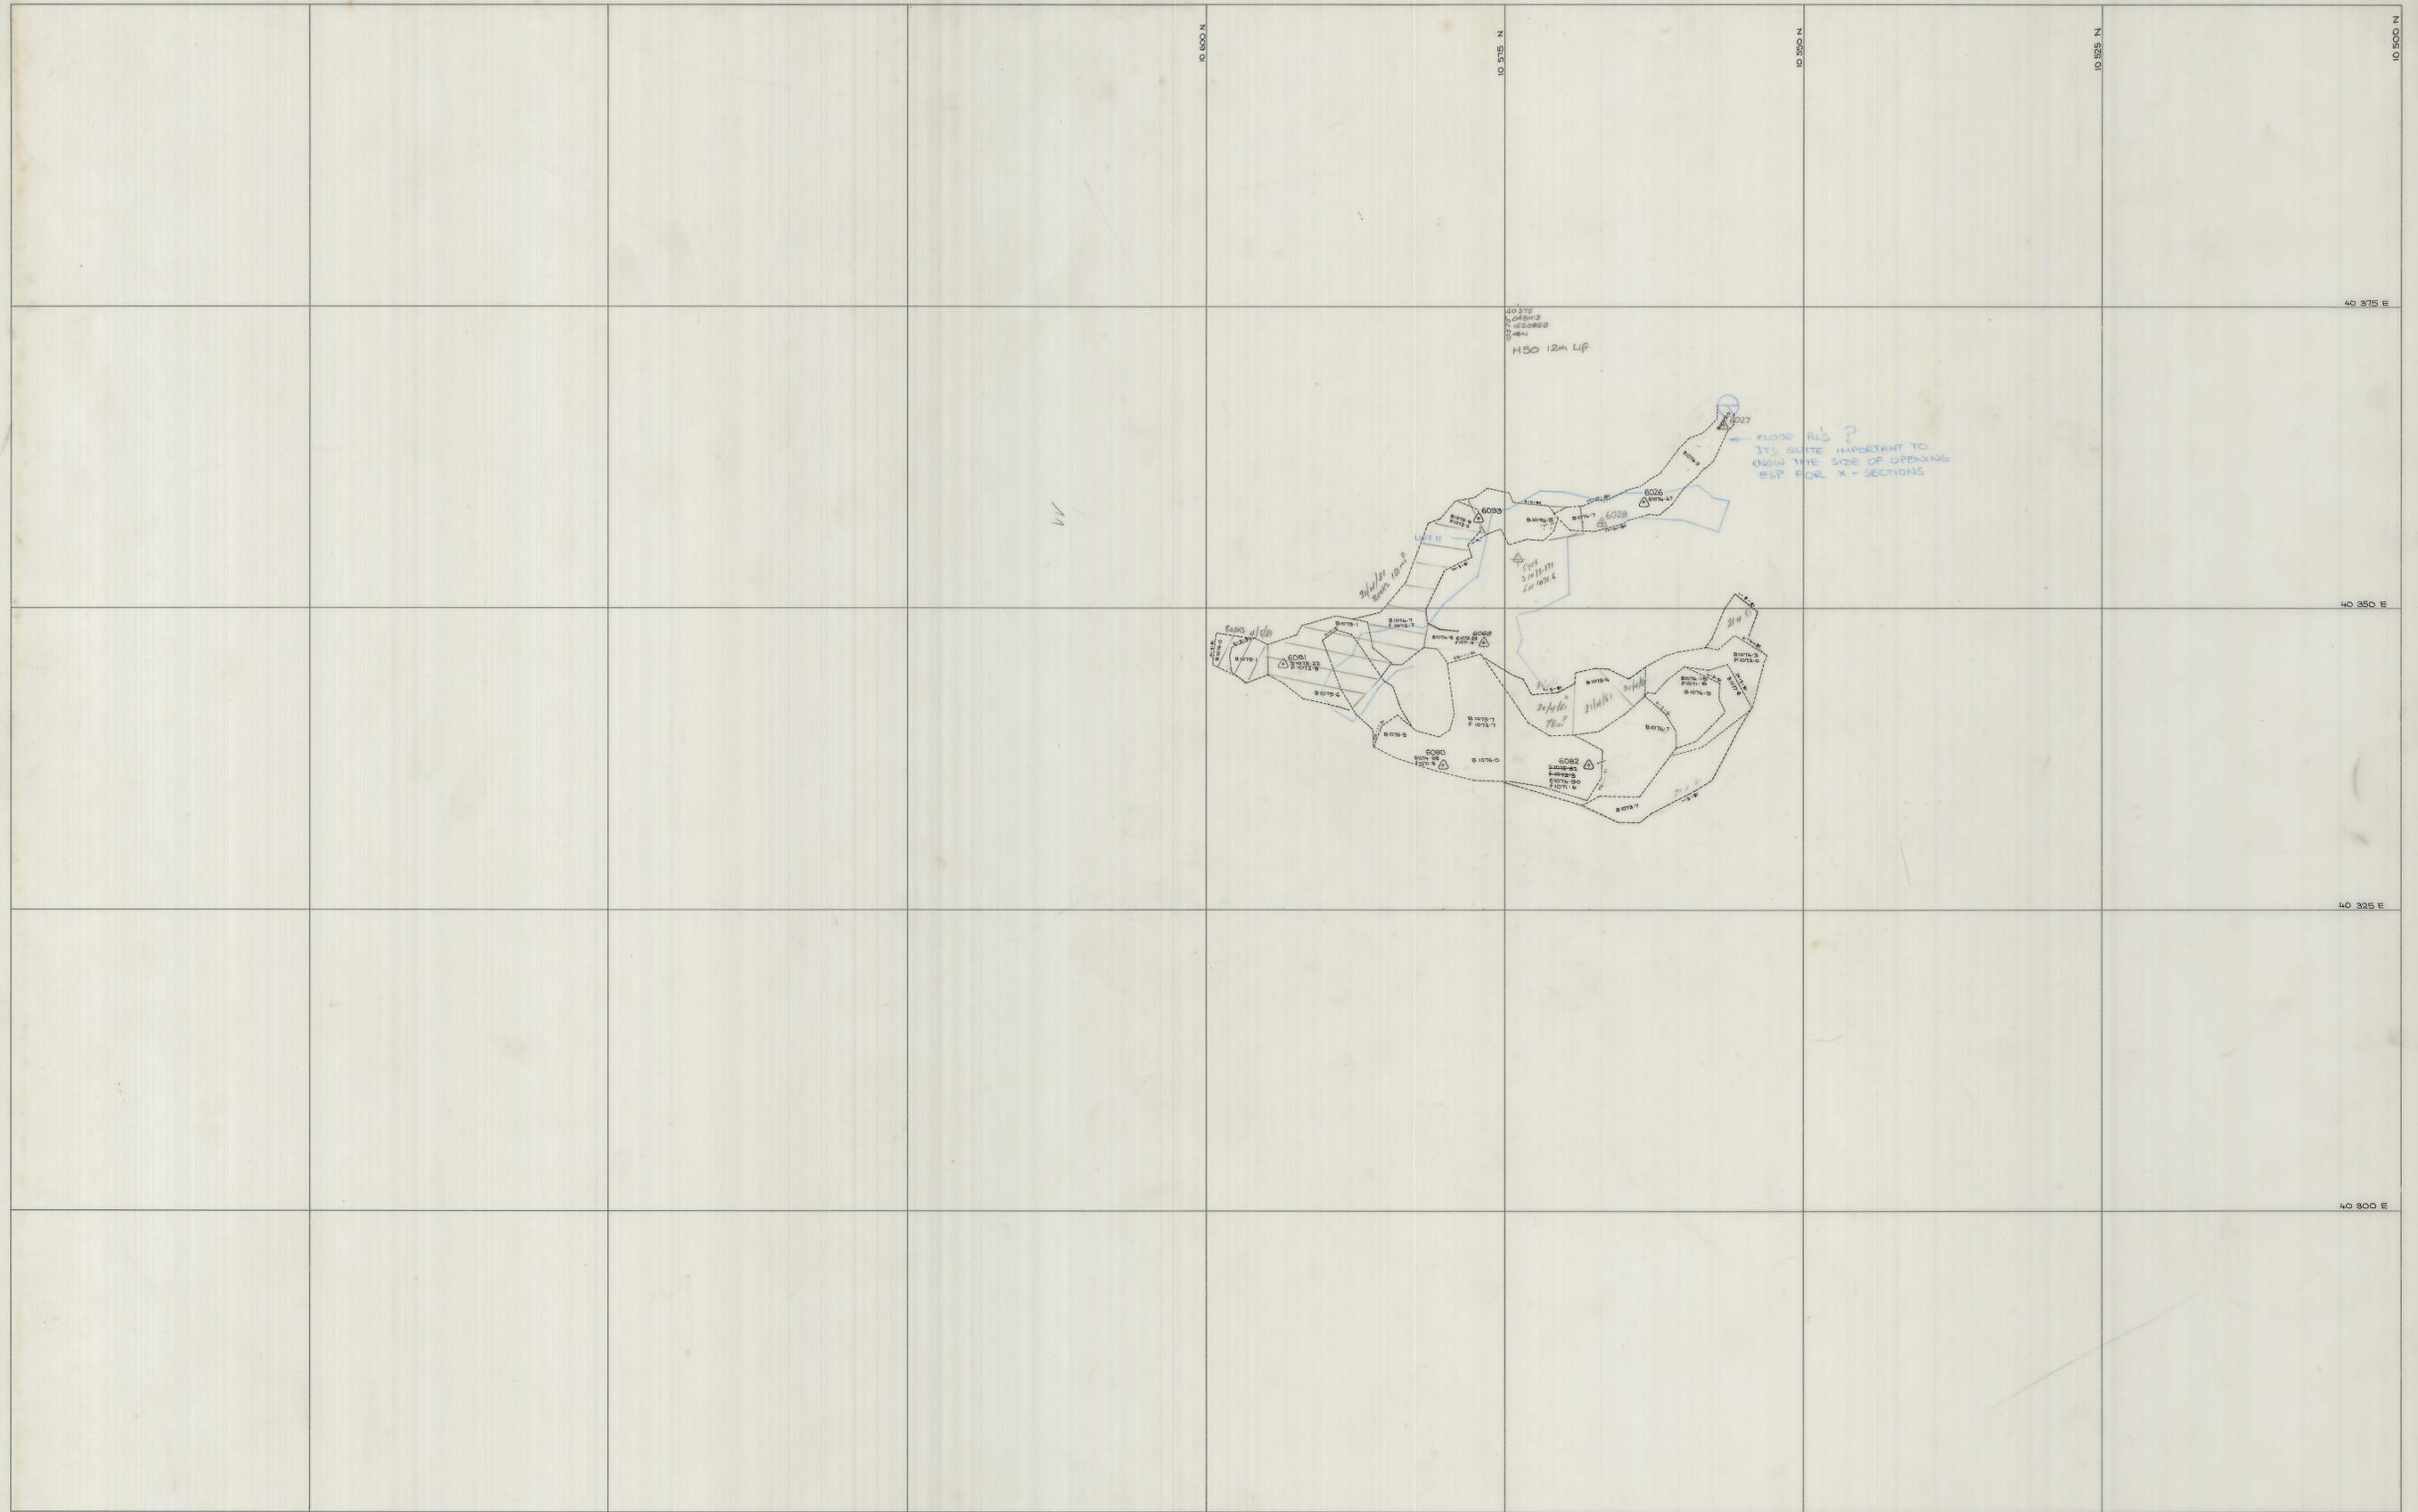


0374-4477

5 cm

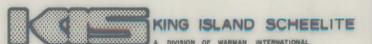

SCALE 1:250		LOCATION BOLD HEAD MINE	 KING ISLAND SCHEELITE A DIVISION OF WARMAN INTERNATIONAL GRASSY KING ISLAND PLAN NUMBER 77
SUBJECT H 50 STOPE 12 th lift		LOCATION north	
PLAN NUMBER 04BH13 - 165 077 S			