


5 cm

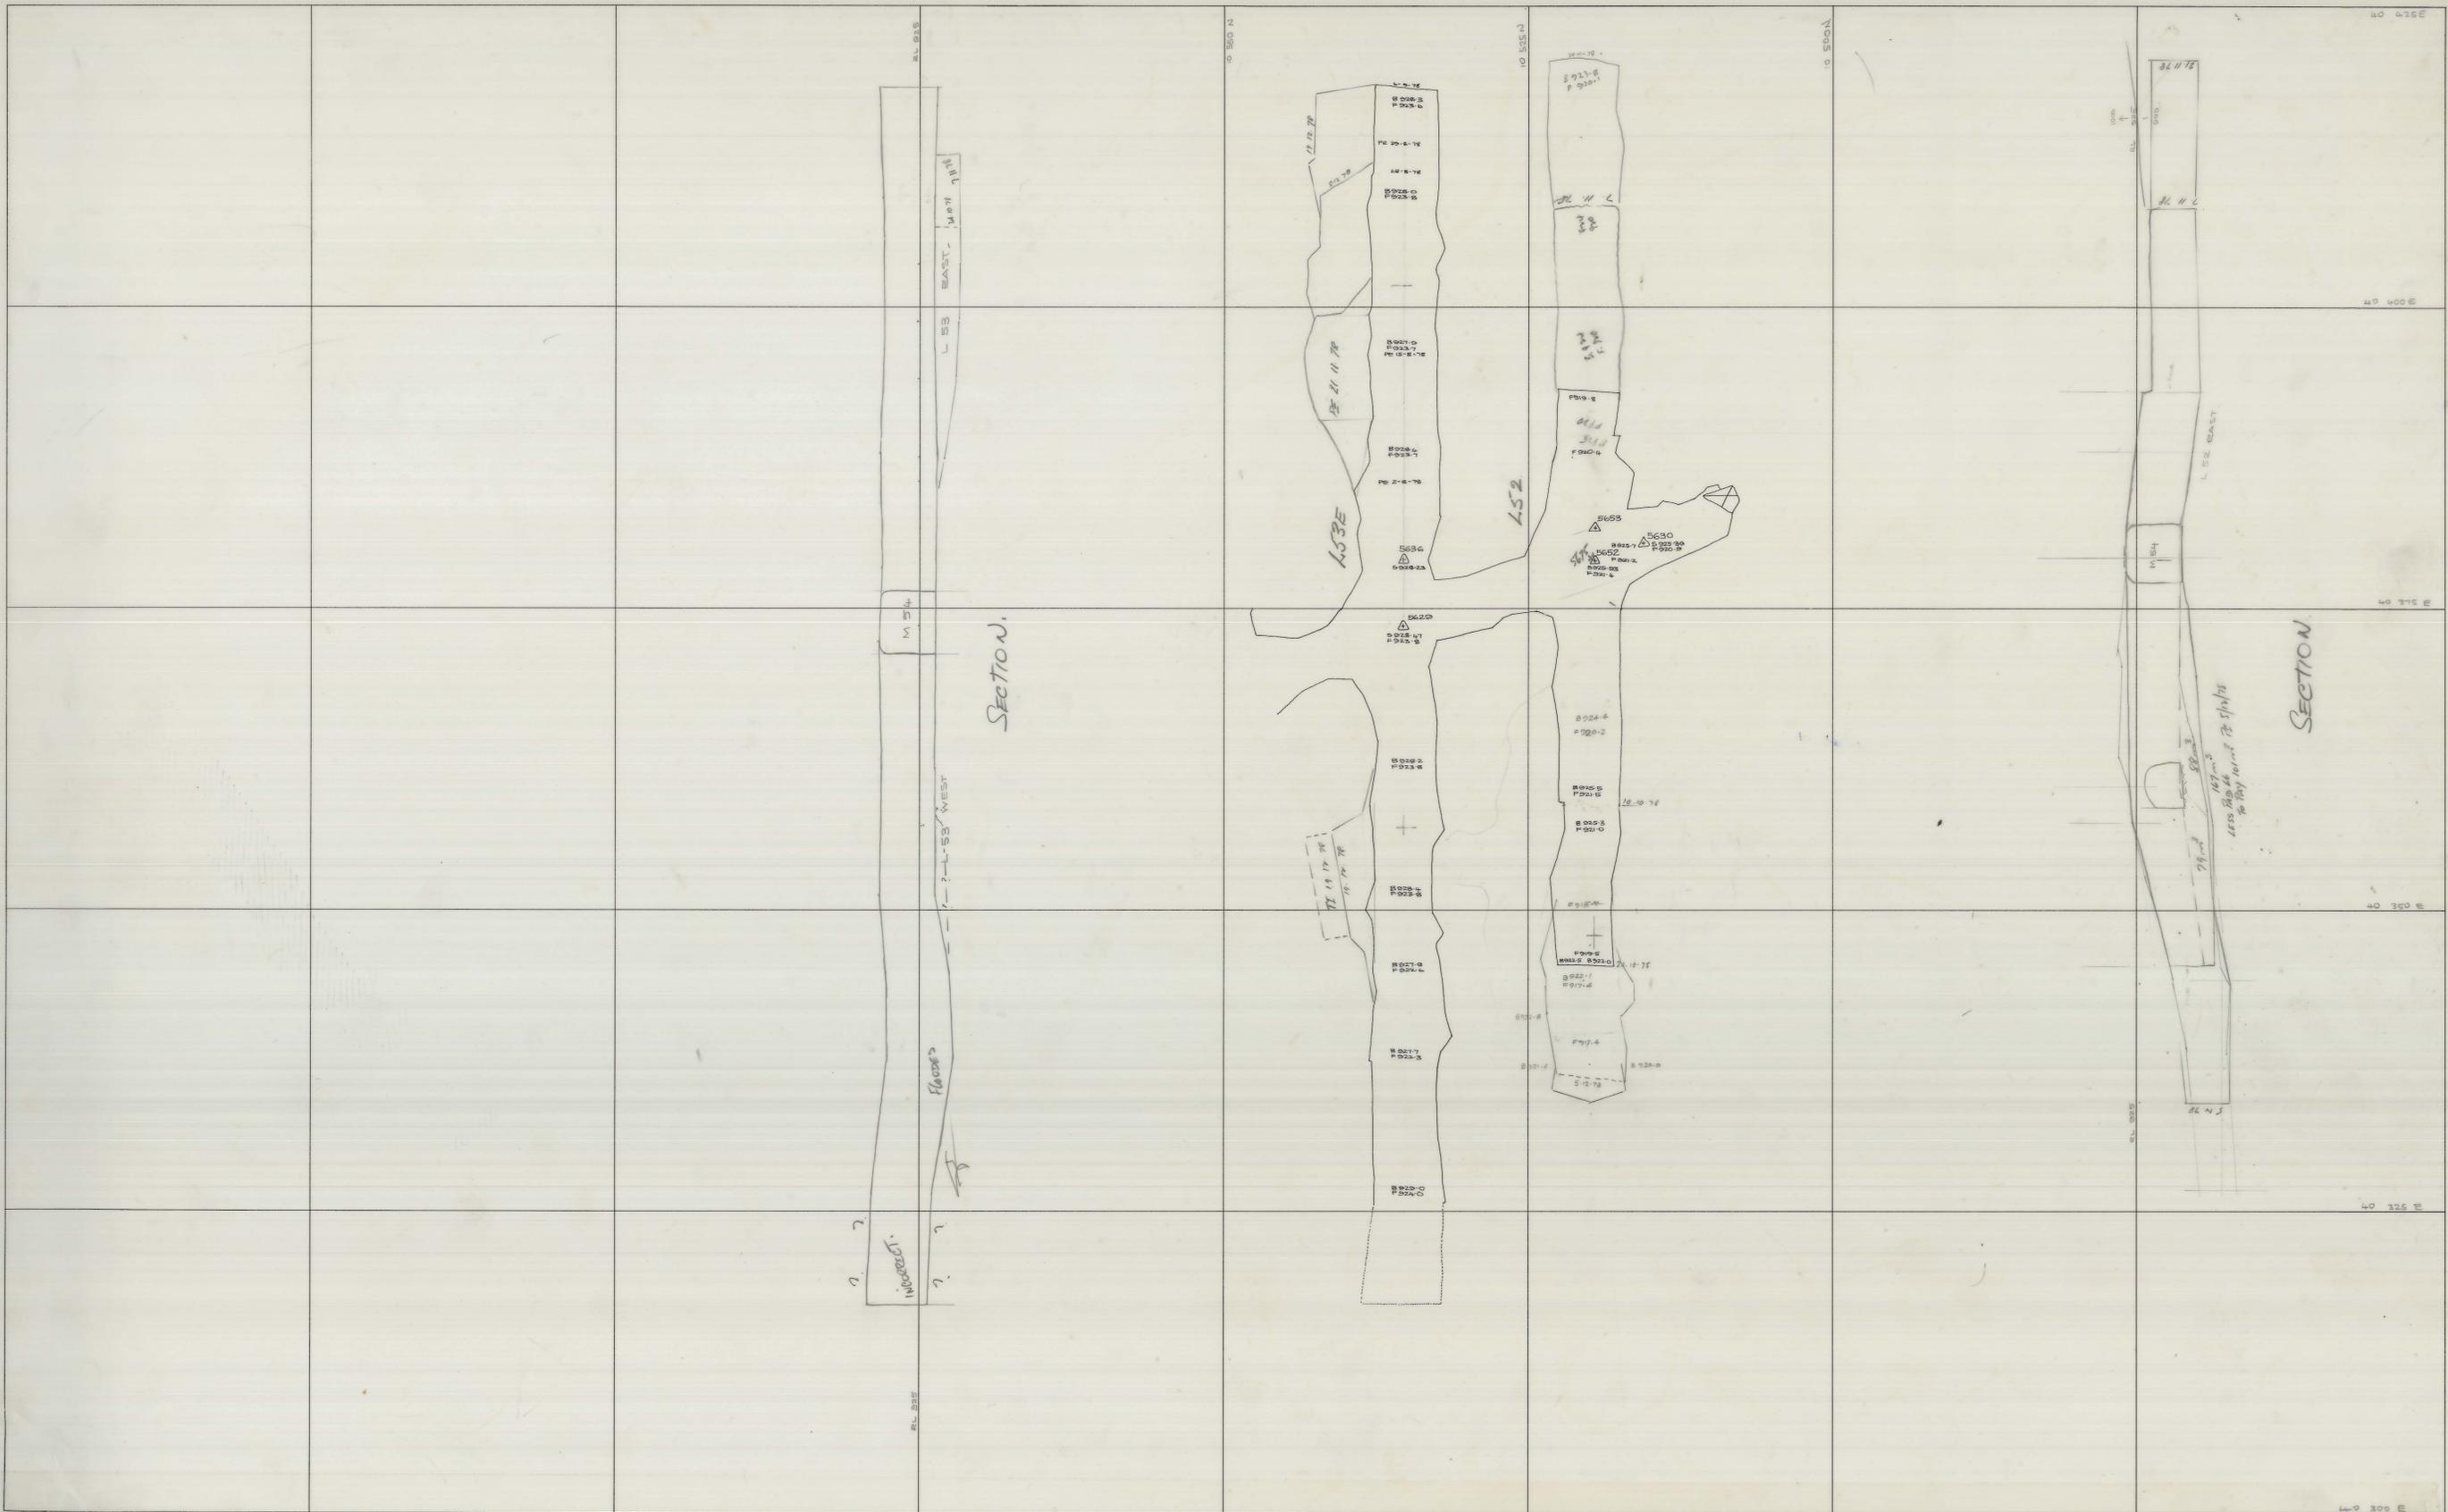

SCALE 1:	LOCATION C1. STONE UNDERCUTS.	<p>KING ISLAND SCHEELITE A DIVISION OF WESMAN INTERNATIONAL</p> <p>GRASSY KING ISLAND</p> <p>PLAN NUMBER</p>
	SUBJECT	
north		