


27 JUN 1981

5 cm

0374_4496

04BH22-1500

SURFACE DUMP

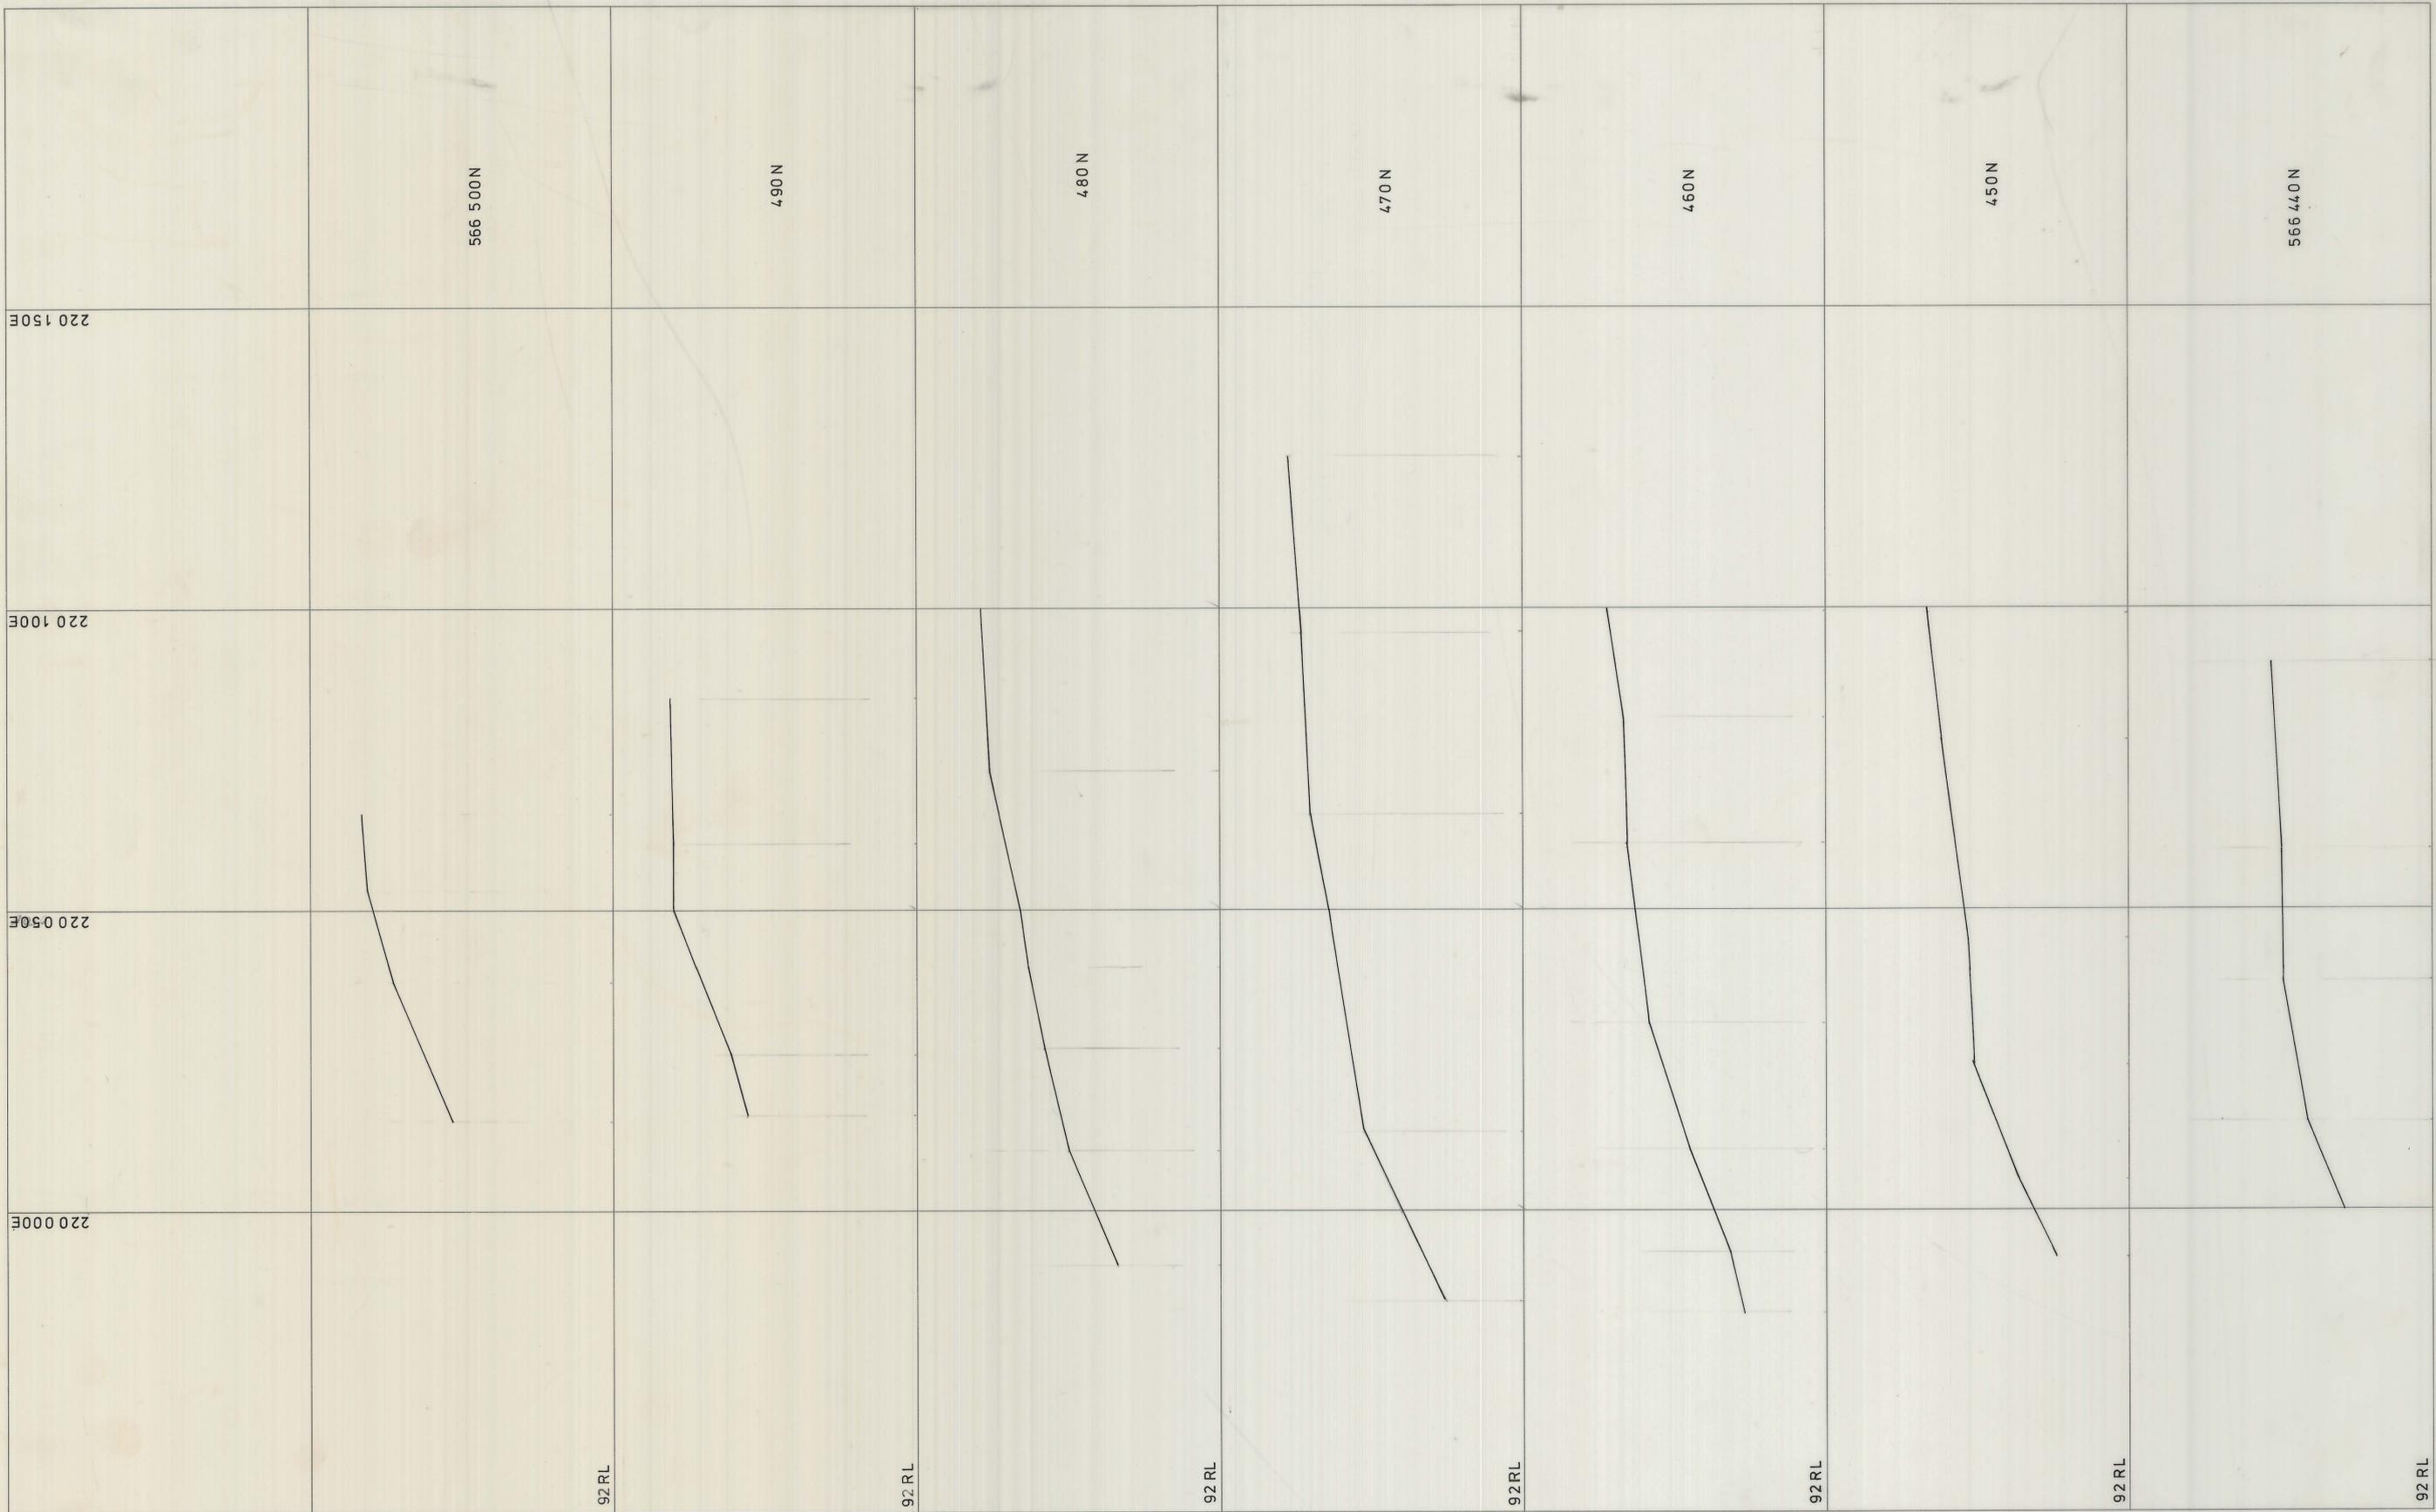

SCALE 1: 500 HORIZONTAL
1:50 VERTICAL

LOCATION
BOLD HEAD SURFACE
SUBJECT
DUMP AREA SECTIONS
ORIGINAL BASE
north
AS AT 26.5.76 26¹⁰ 76

KIS KING ISLAND SCHEELITE
A DIVISION OF WARMAN INTERNATIONAL
GRASSY KING ISLAND
PLAN NUMBER
04BH22 - 1500