


27 JUN 1981

0374\_4499

04BH13-165087

H50  
[LIFT 7]

5 cm

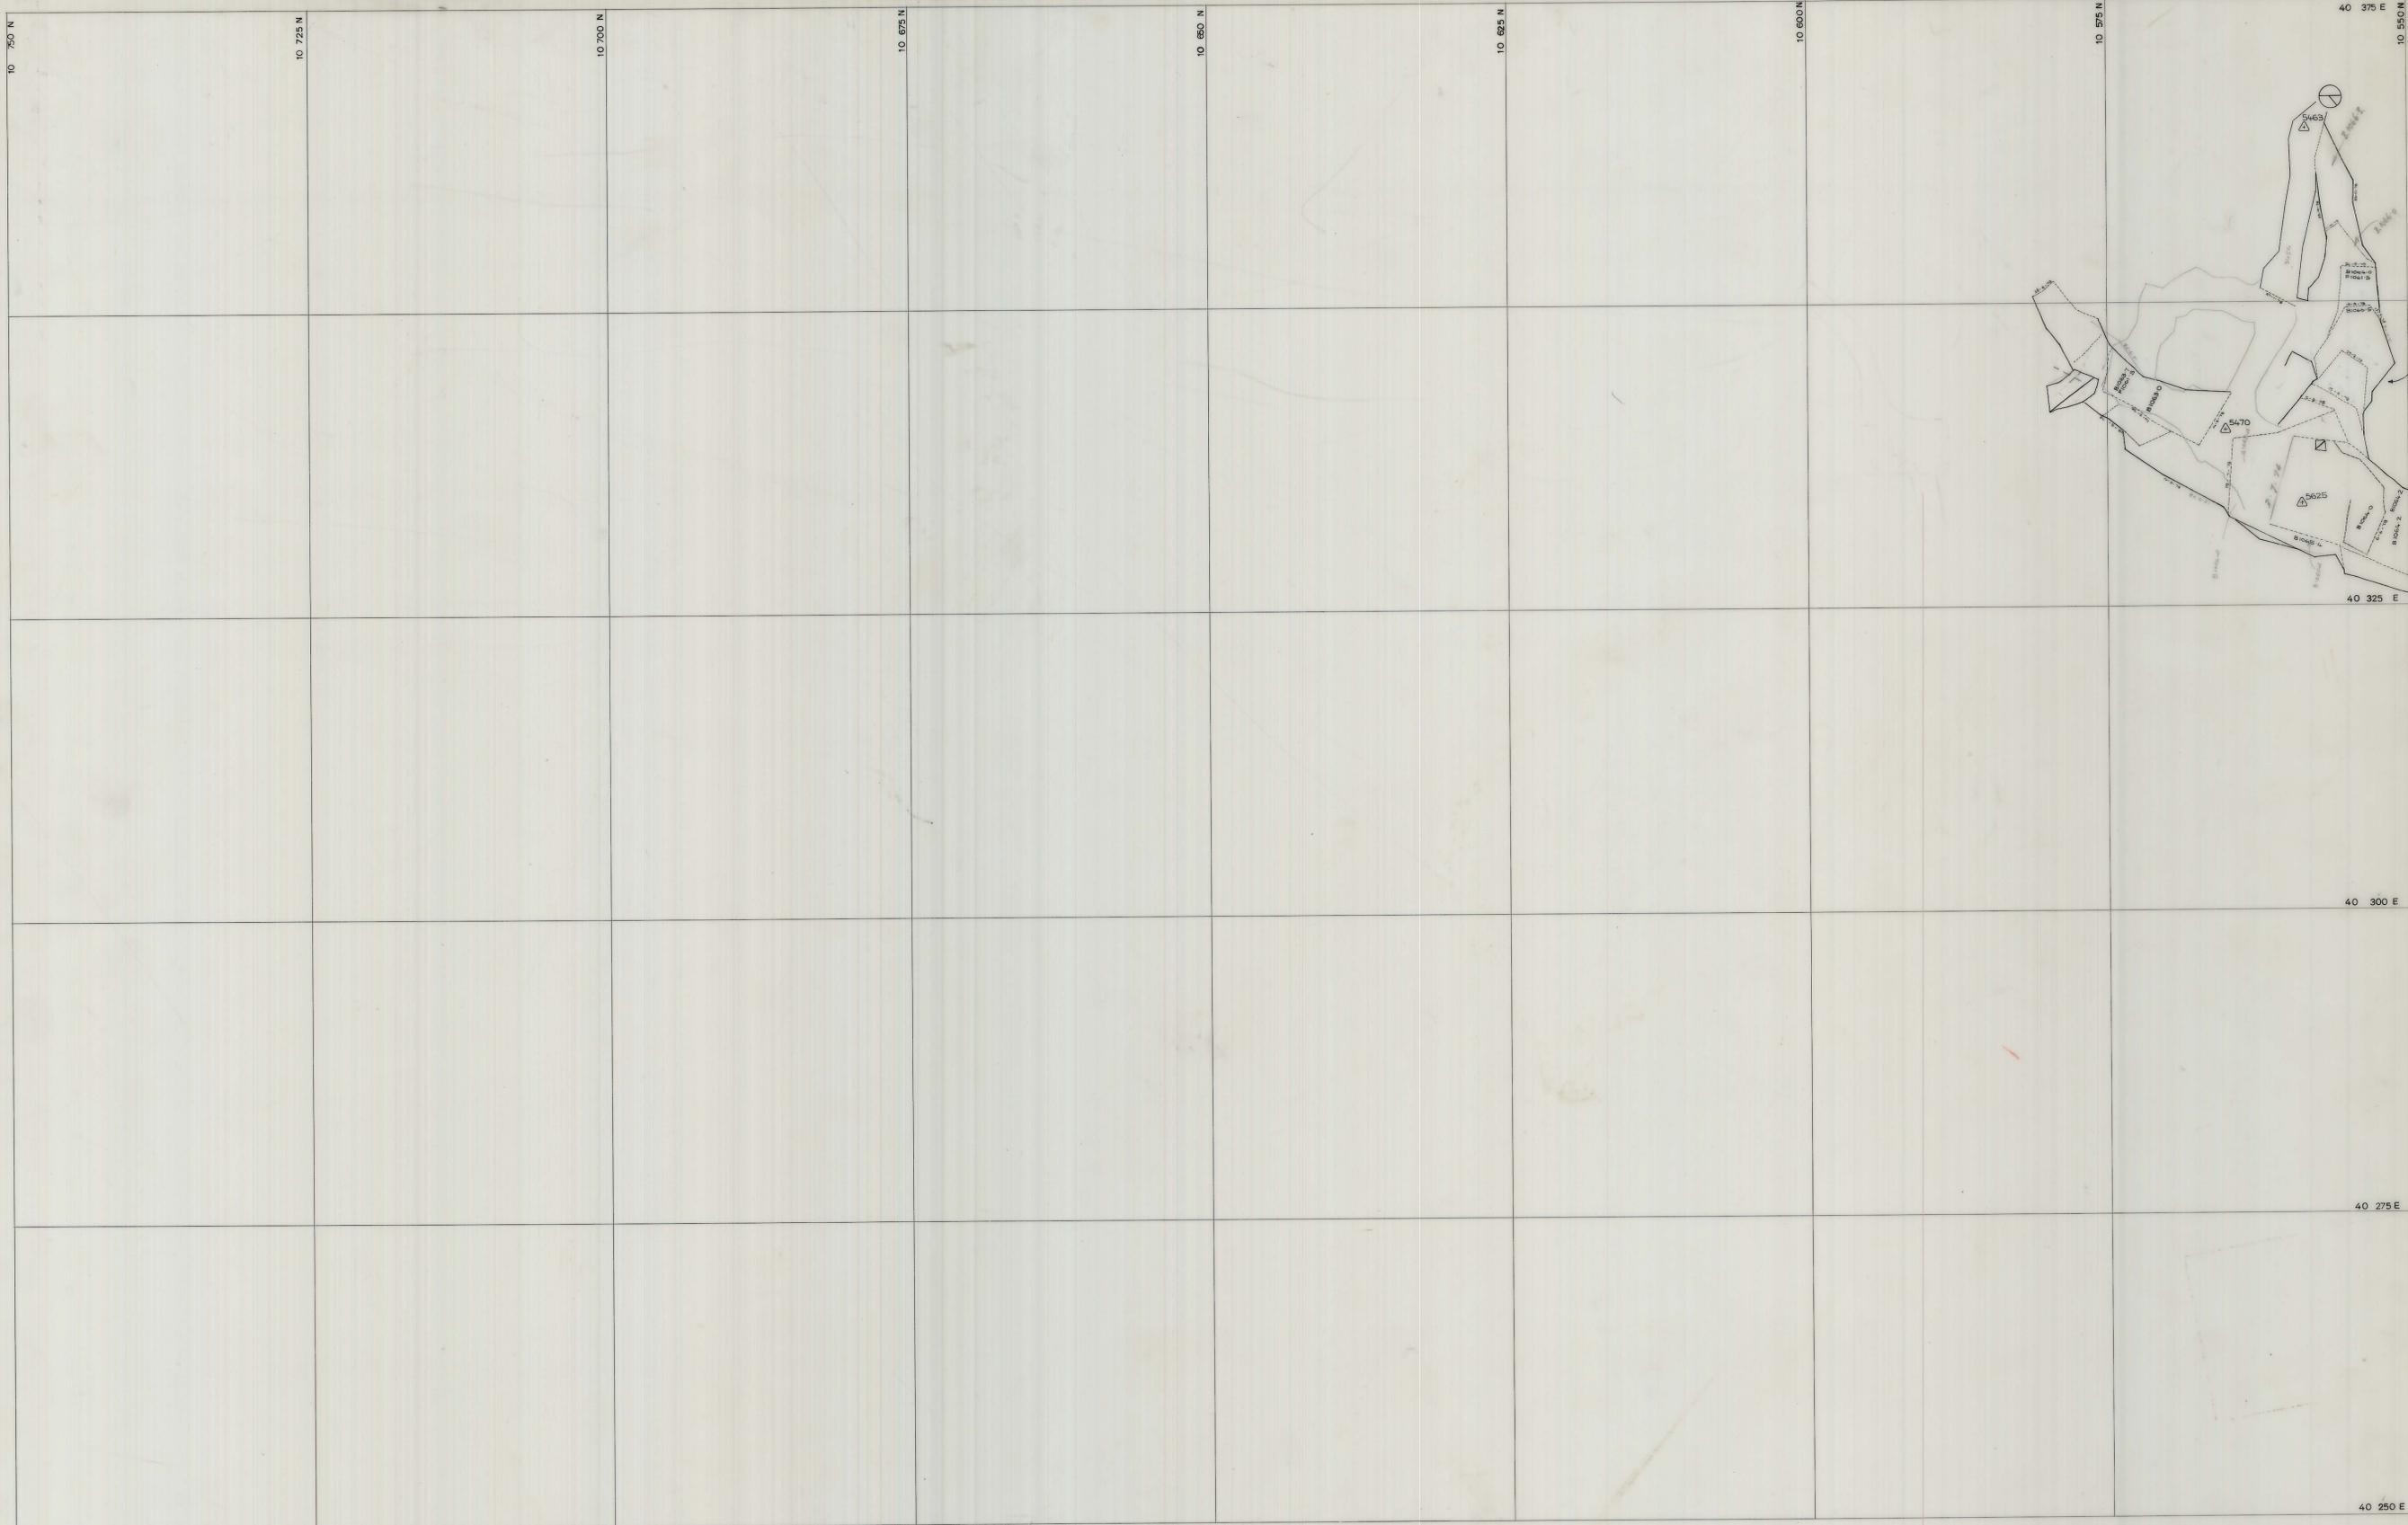

	SCALE 1 250		LOCATION BOLD HEAD MINE	 A DIVISION OF WARMAN INTERNATIONAL GRASSY KING ISLAND PLAN NUMBER 04BH13-165087
		north	SUBJECT A LENS H 50 [LIFT 7]	