



0374-450

04DM15 - 1051
SECTION 2000 1987

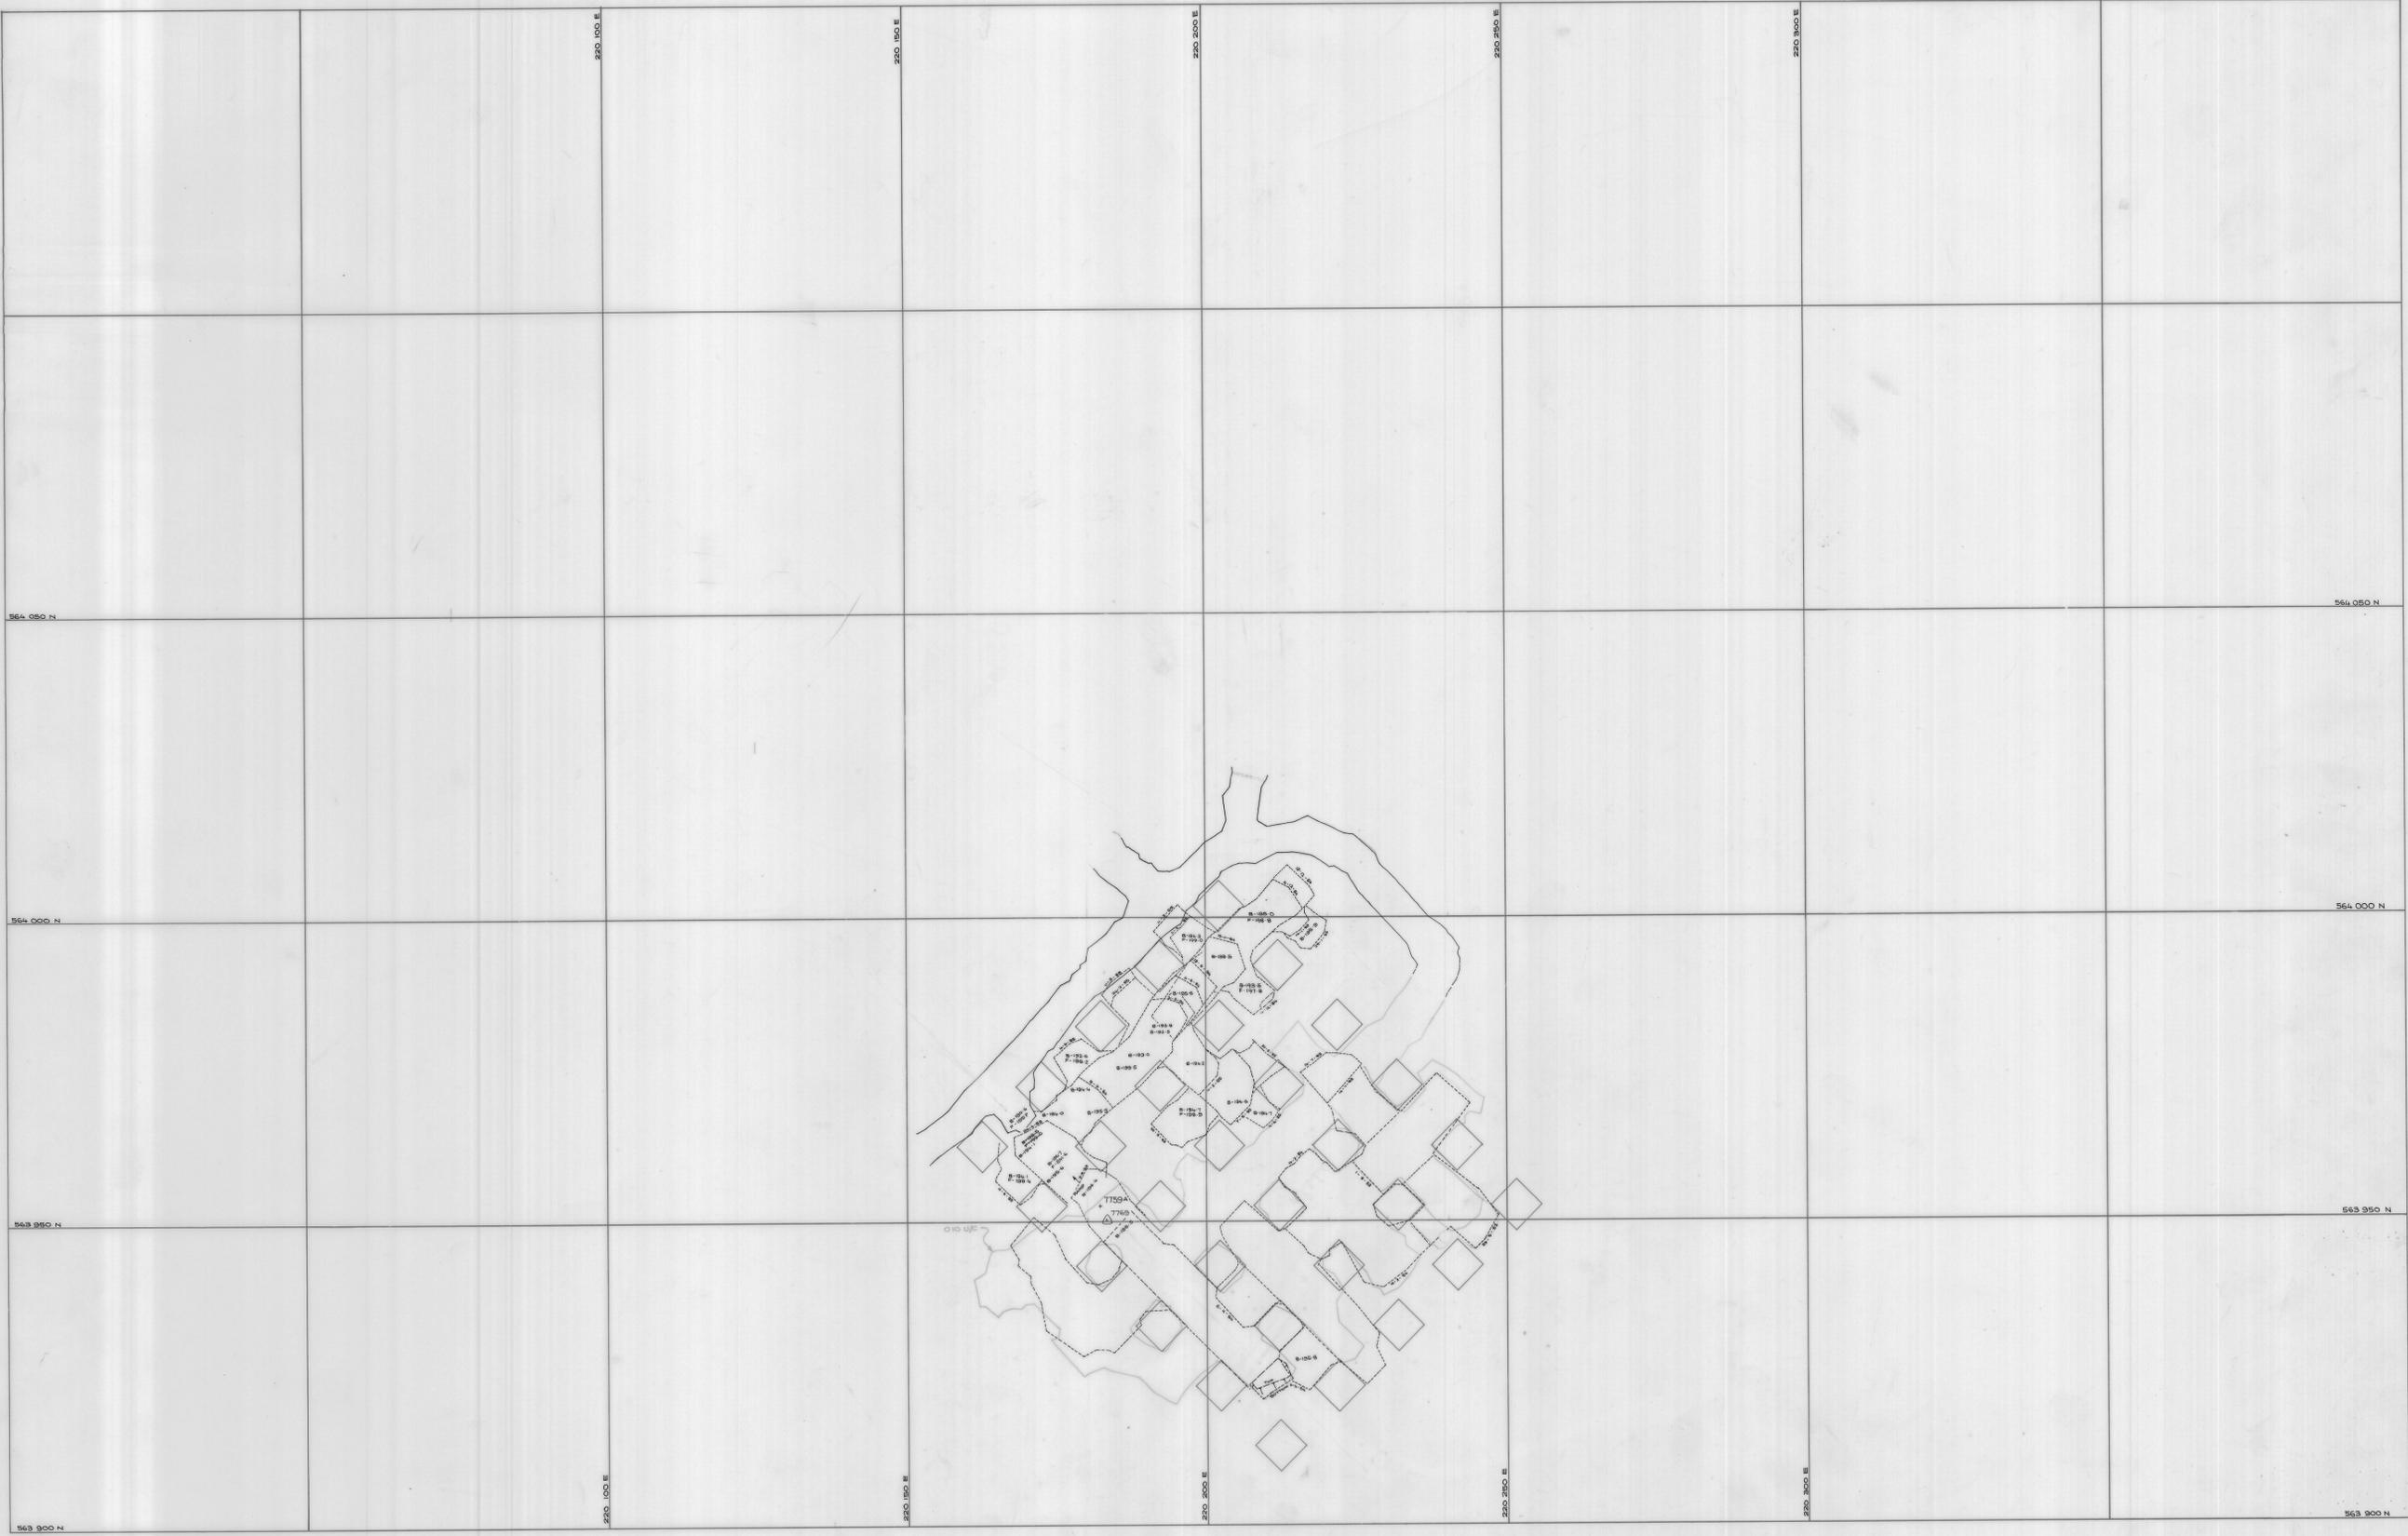

SCALE 1: 500

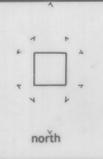

LOCATION DOLPHIN MINE
 SUBJECT LOWER PIT/O 10 - CROWN PILLAR
 Lift 8

KIS KING ISLAND SCHEELITE
 A DIVISION OF WARMAN INTERNATIONAL

GRASSY KING ISLAND

PLAN NUMBER 04DM15 - 1051