


27 JUN 1981

5 cm

04BH13-165090

0374\_4500

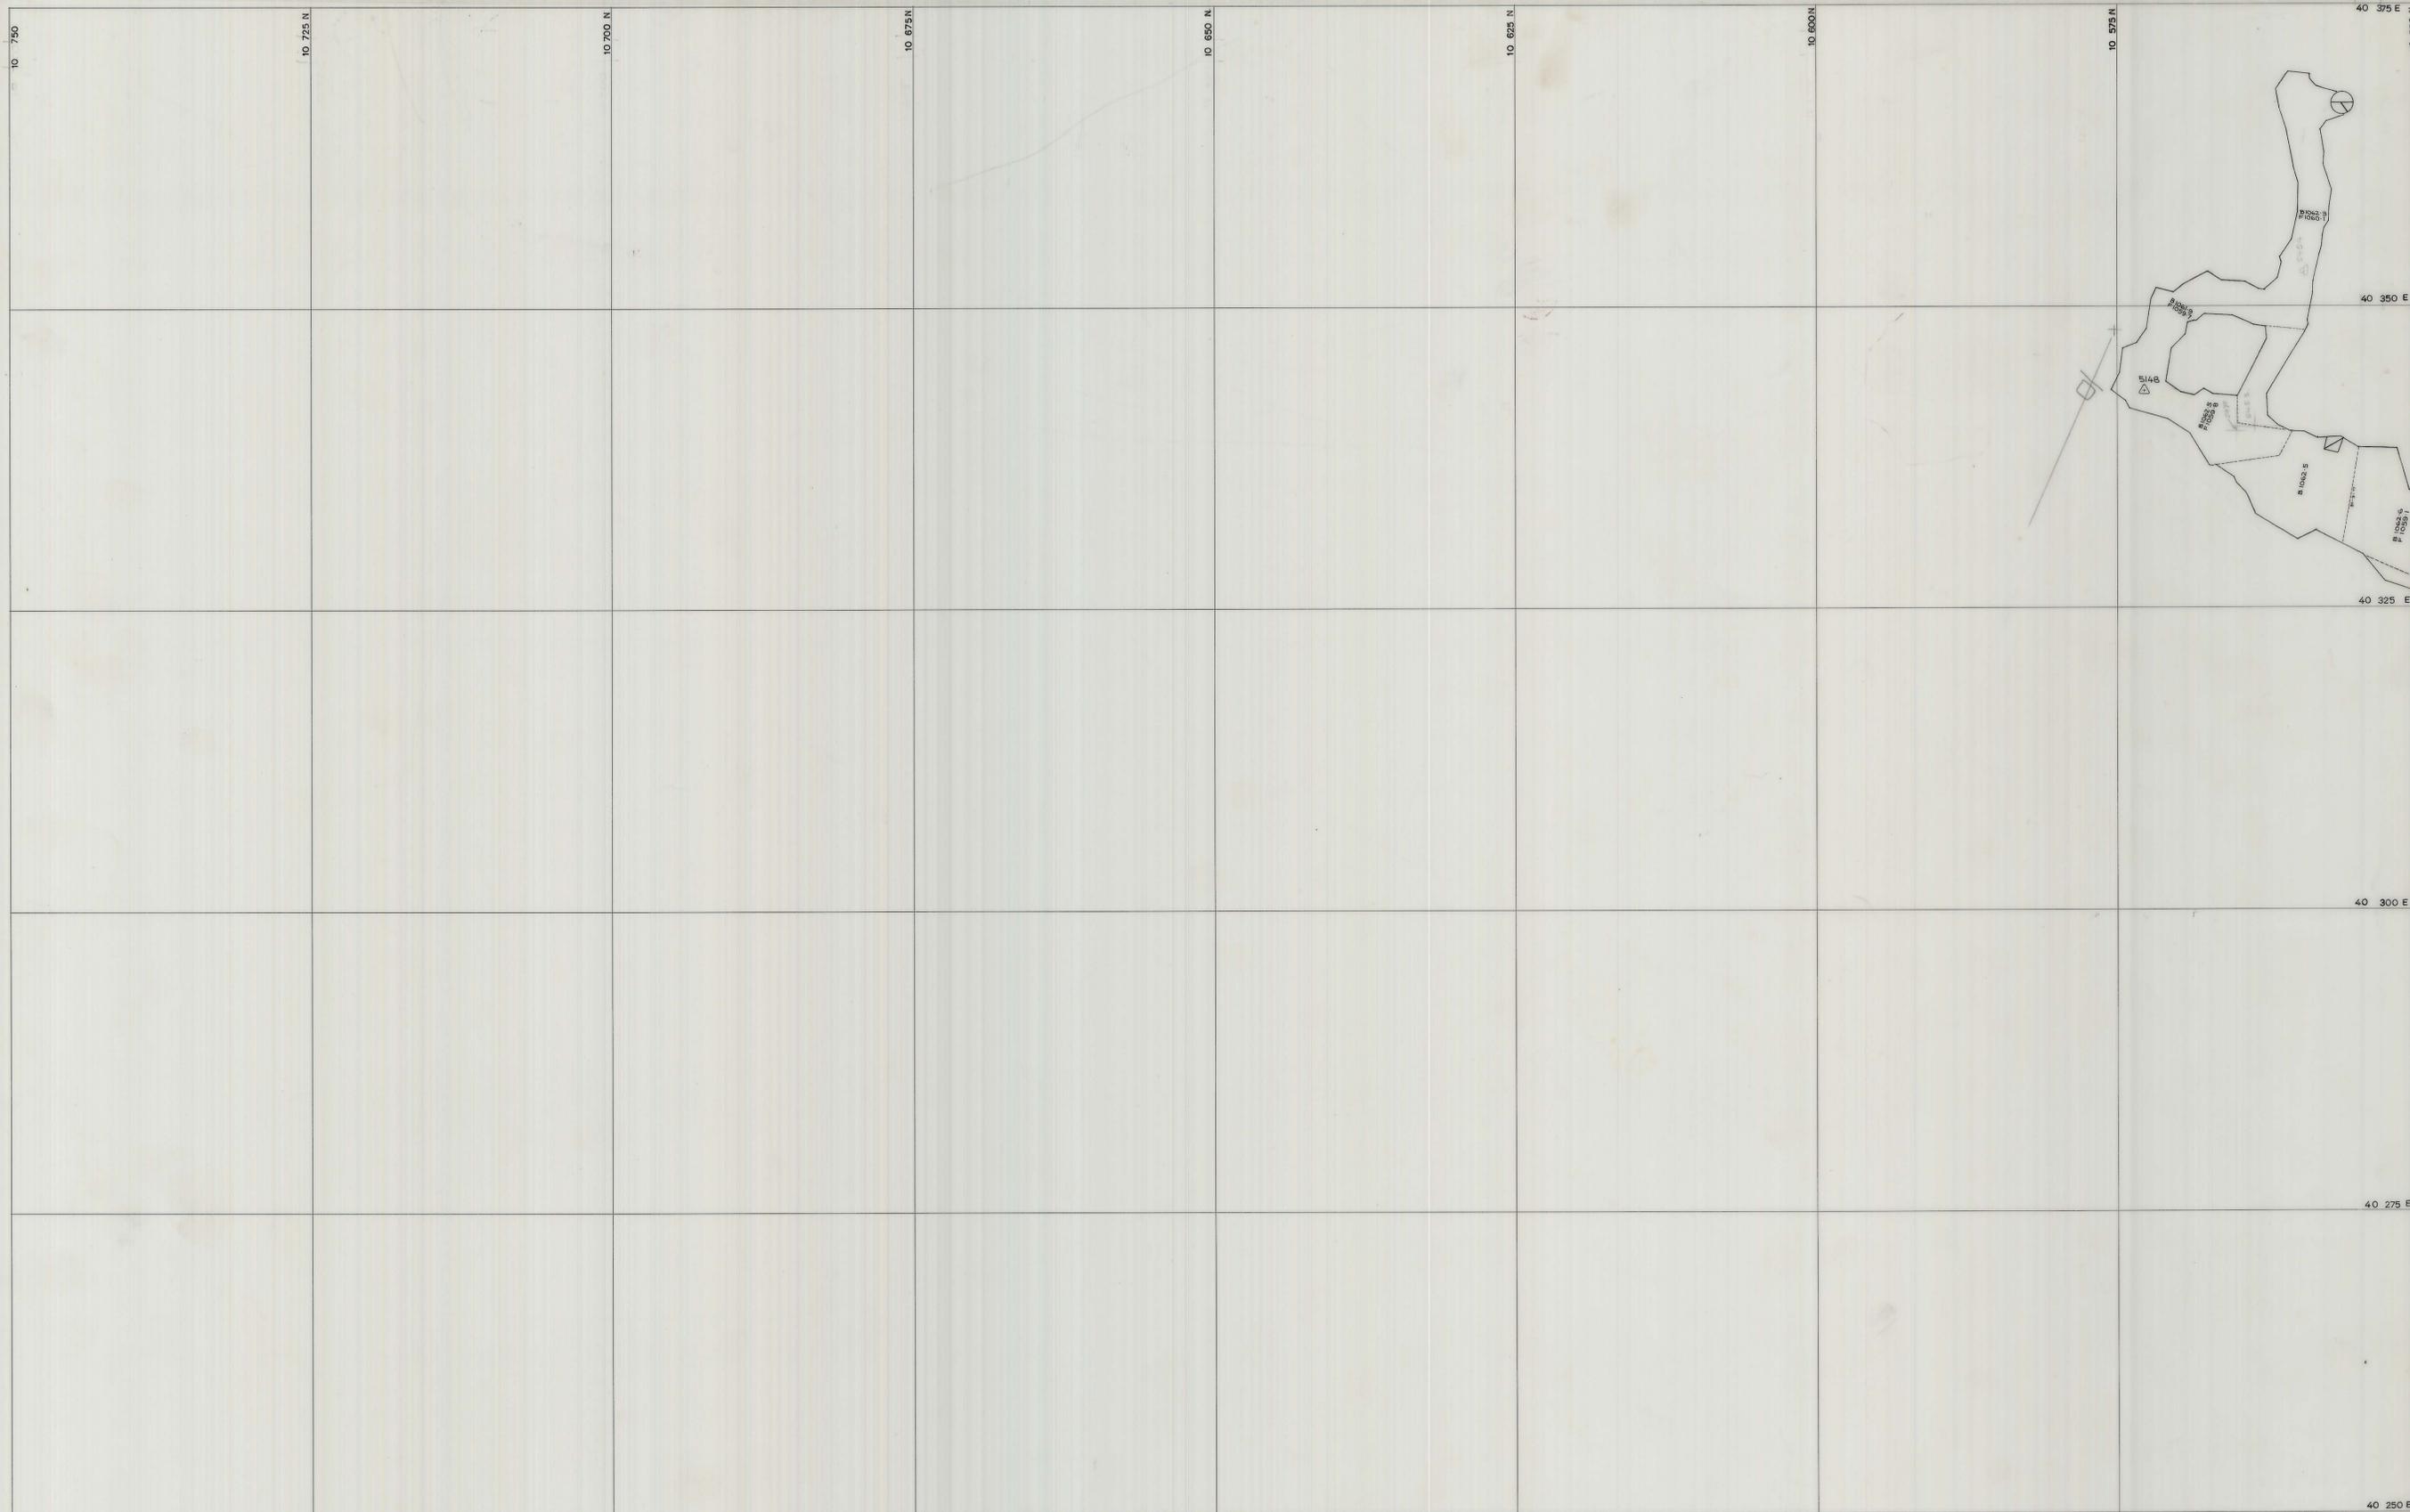

SCALE 1: 250

LOCATION BOLD HEAD MINE

SUBJECT A LENS STOPE  
H50 [LIFT N°6]

north

**KIS** KING ISLAND SCHEELITE  
A DIVISION OF WARMAN INTERNATIONAL

GRASSY KING ISLAND

PLAN NUMBER 04BH13-165090