


27 JUN 1981

5 cm

04BH13-165114

P. 70

0374_4503

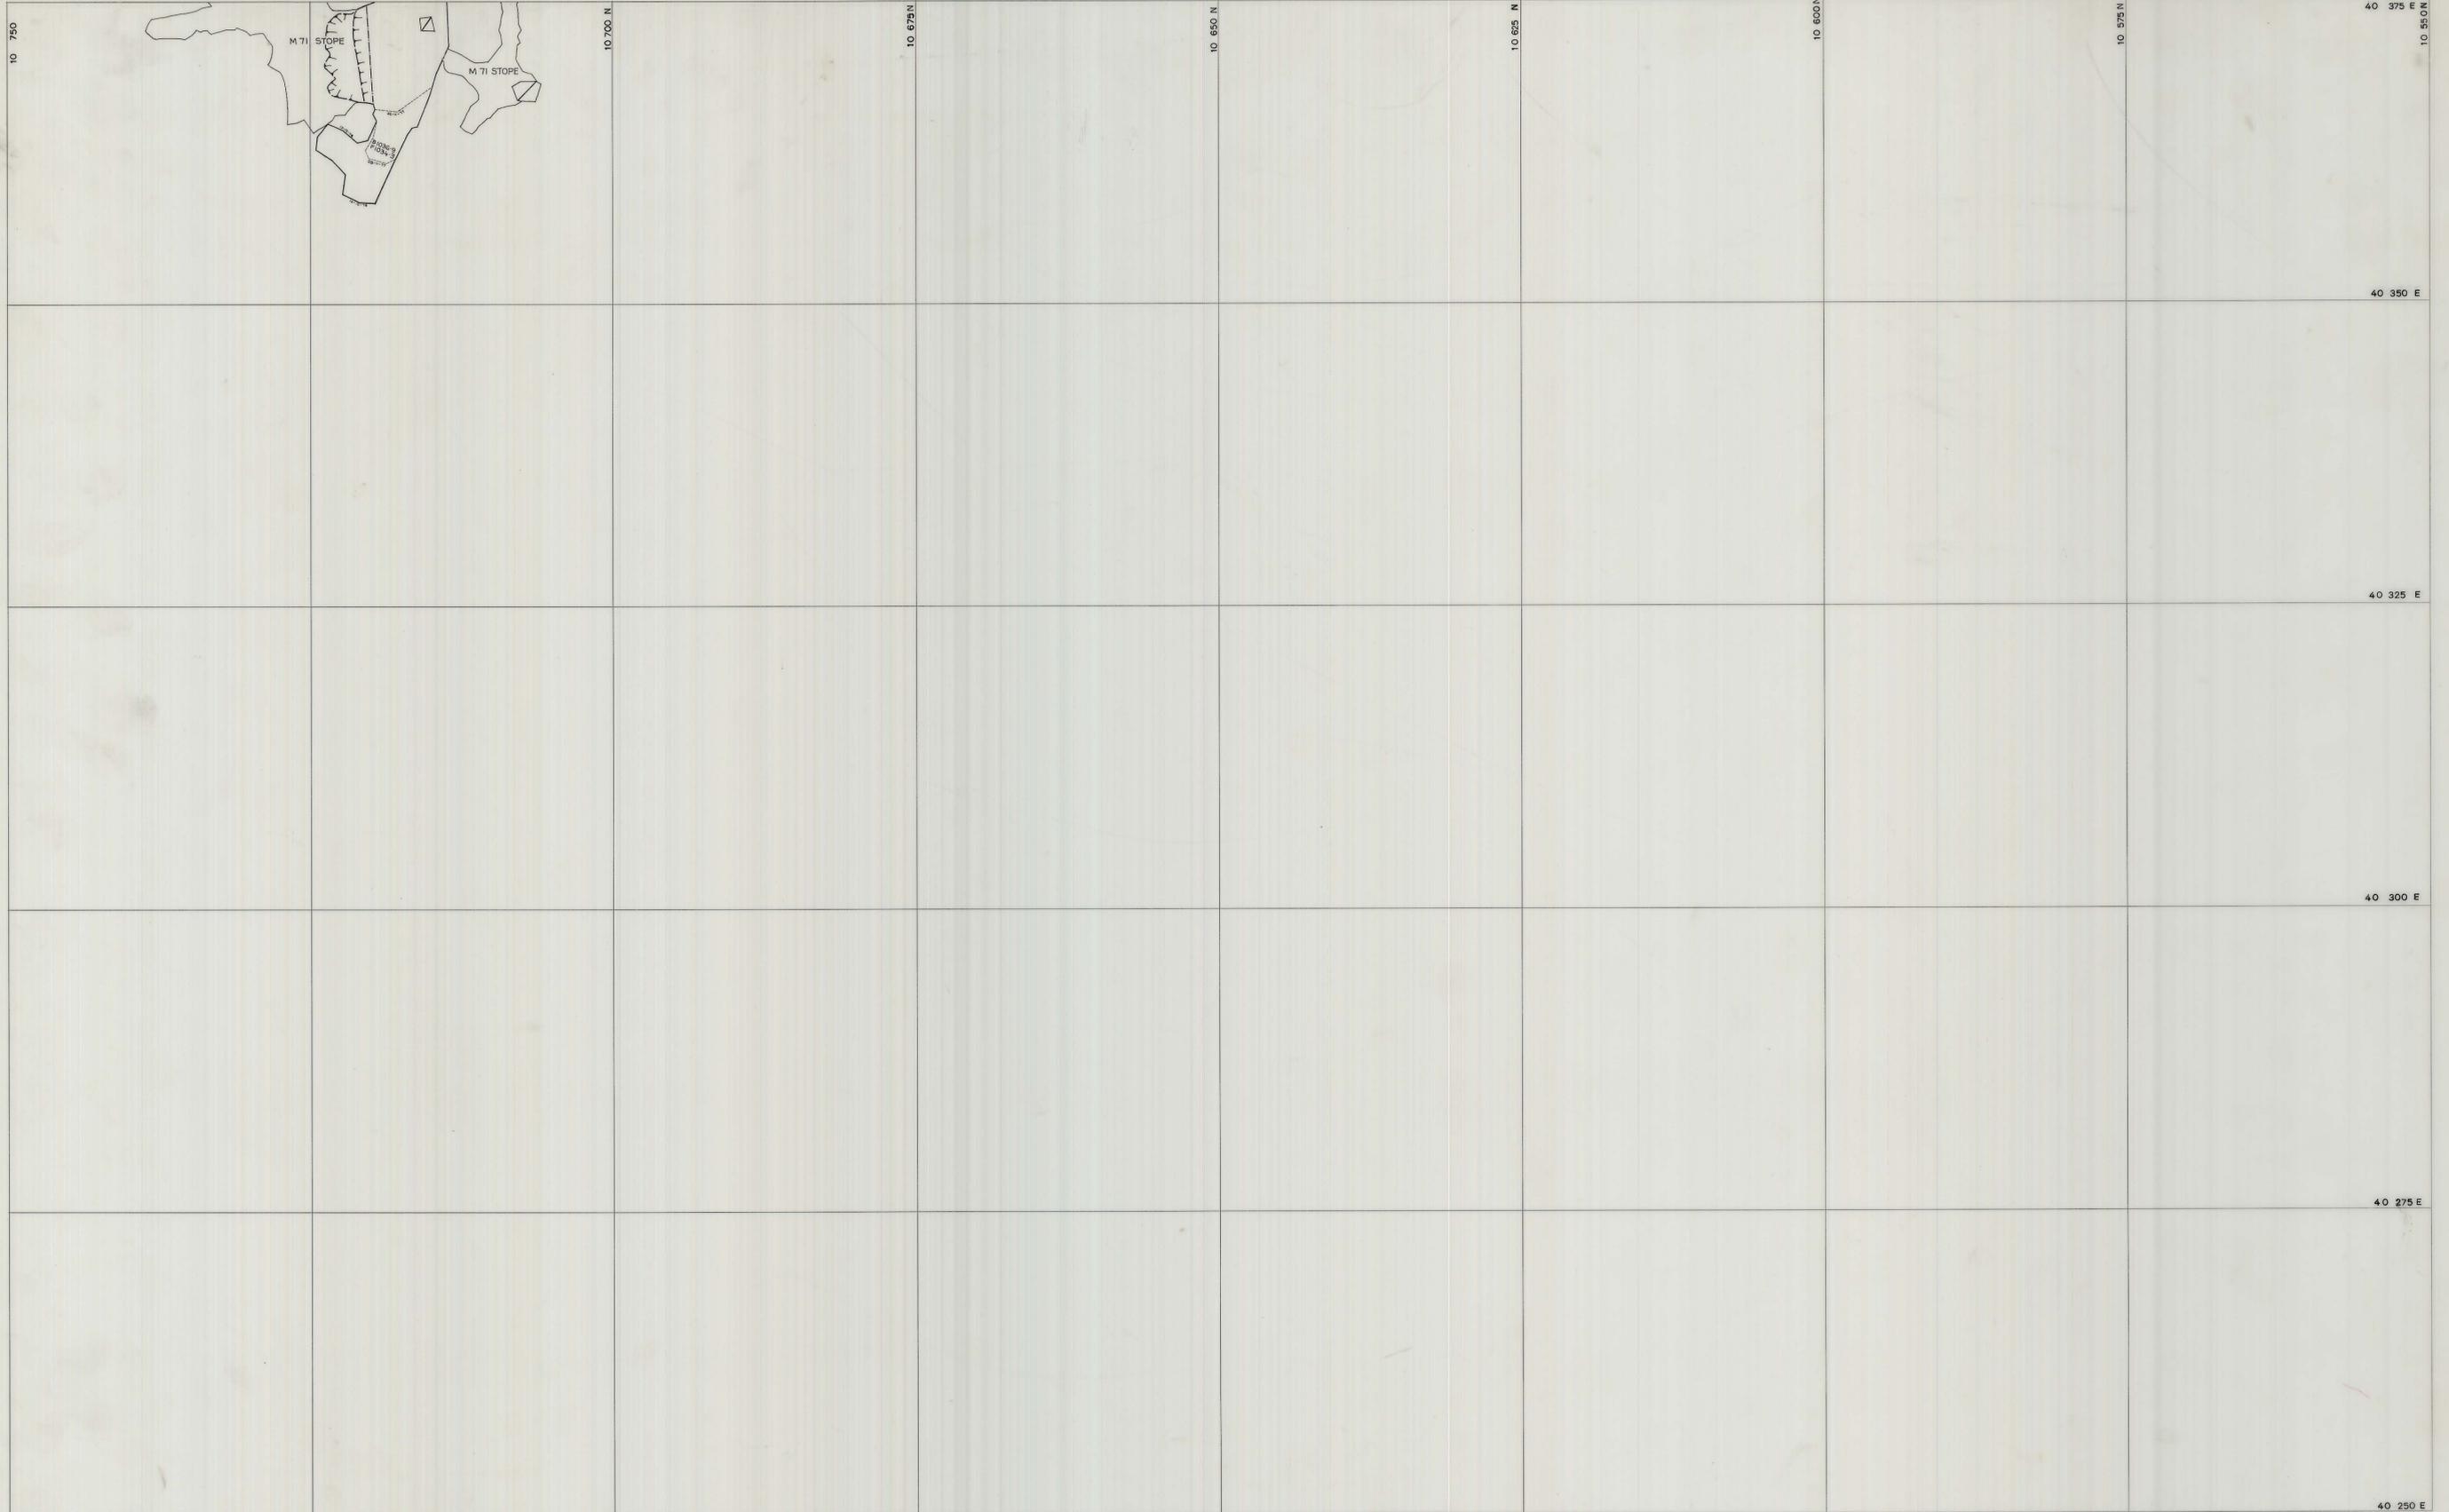

	SCALE 1:250	north	LOCATION BOLD HEAD MINE	 KING ISLAND SCHEELITE A DIVISION OF WARMAN INTERNATIONAL GRASSY KING ISLAND
			SUBJECT P 70 STOPE	