


27 JUN 1981

5 cm

04BH13- 165 214

L58  
L59

0374\_4504

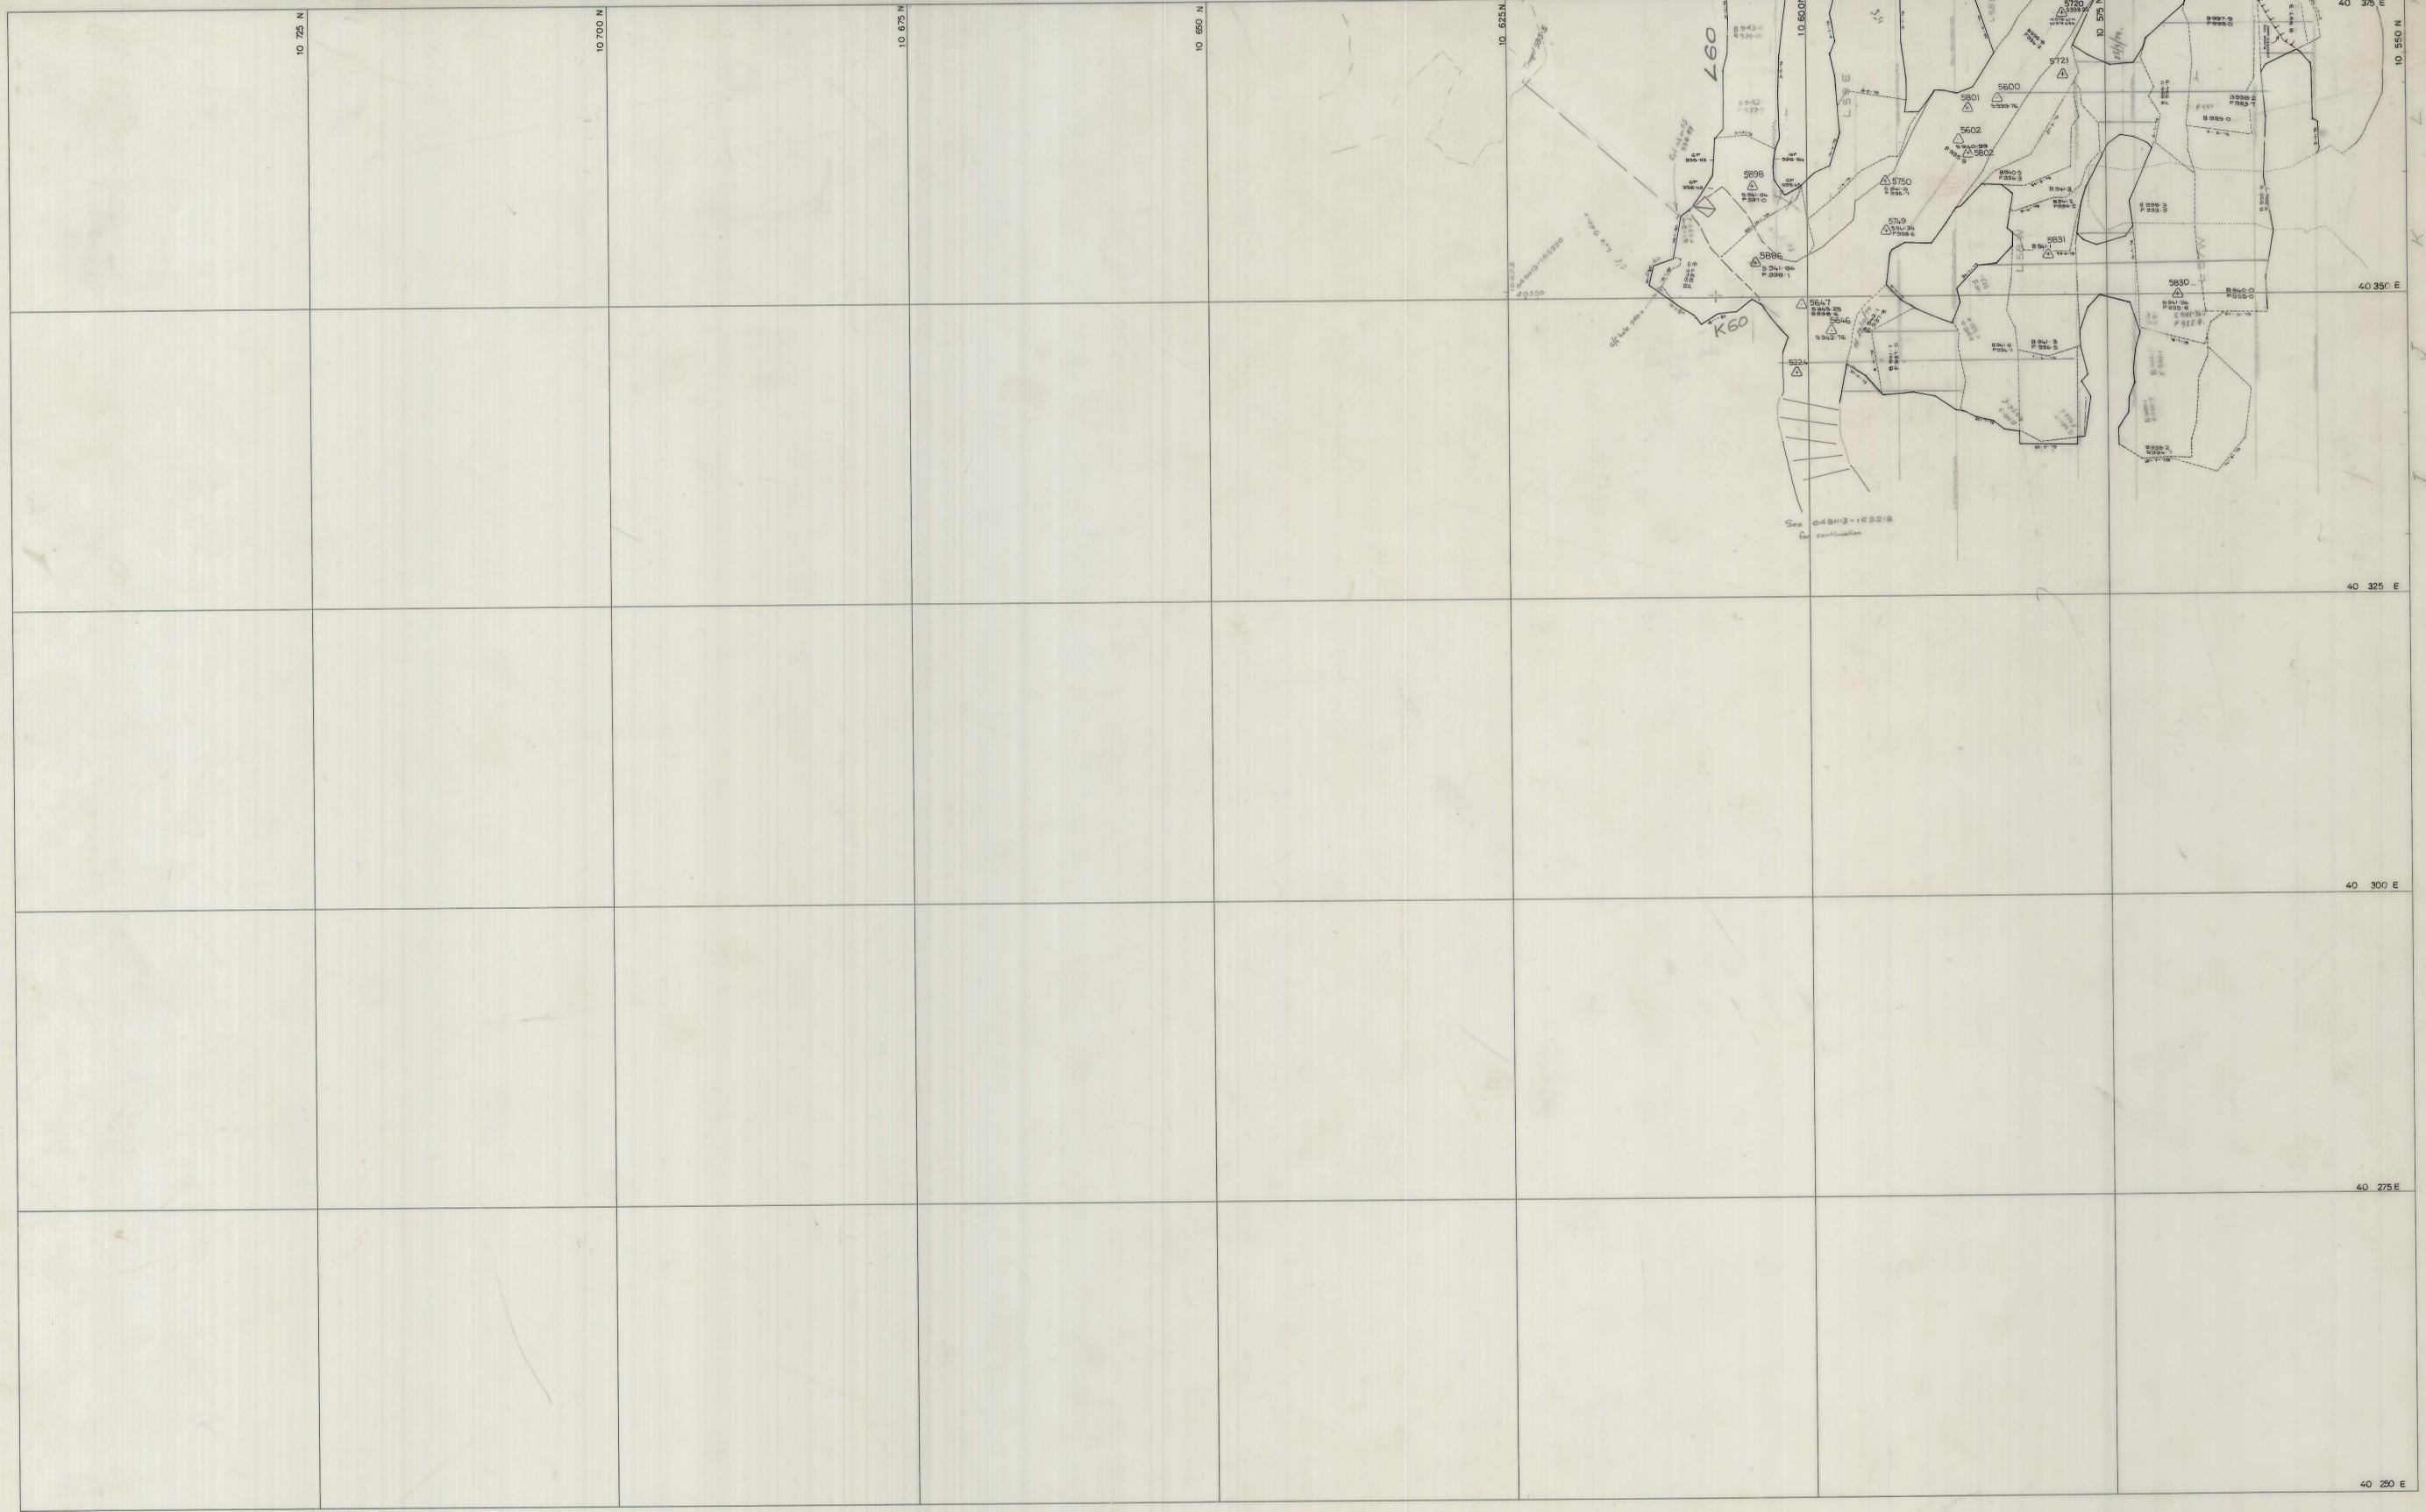

	SCALE	1: 250	north	LOCATION	BOLD HEAD MINE	 KING ISLAND SCHEELITE A DIVISION OF WARMIN INTERNATIONAL GRASSY KING ISLAND
	L60 : Calc Sht B5 <i>Design along</i>			SUBJECT	C1 OREBODY L57, L58 & L59	