




27 JUN 1981

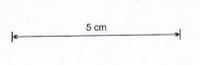

04BH13-166 103

0374\_4505

P70  
LIFT 4

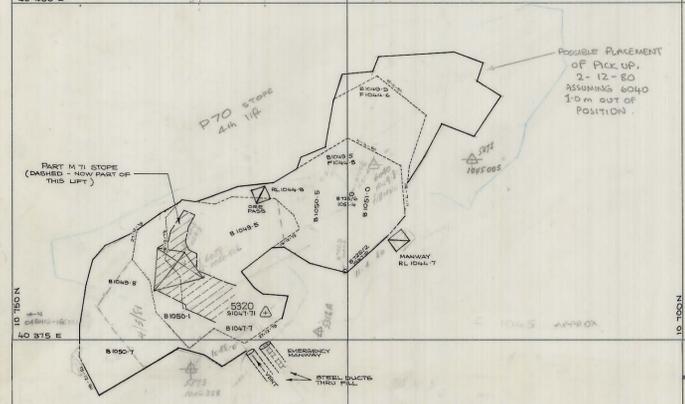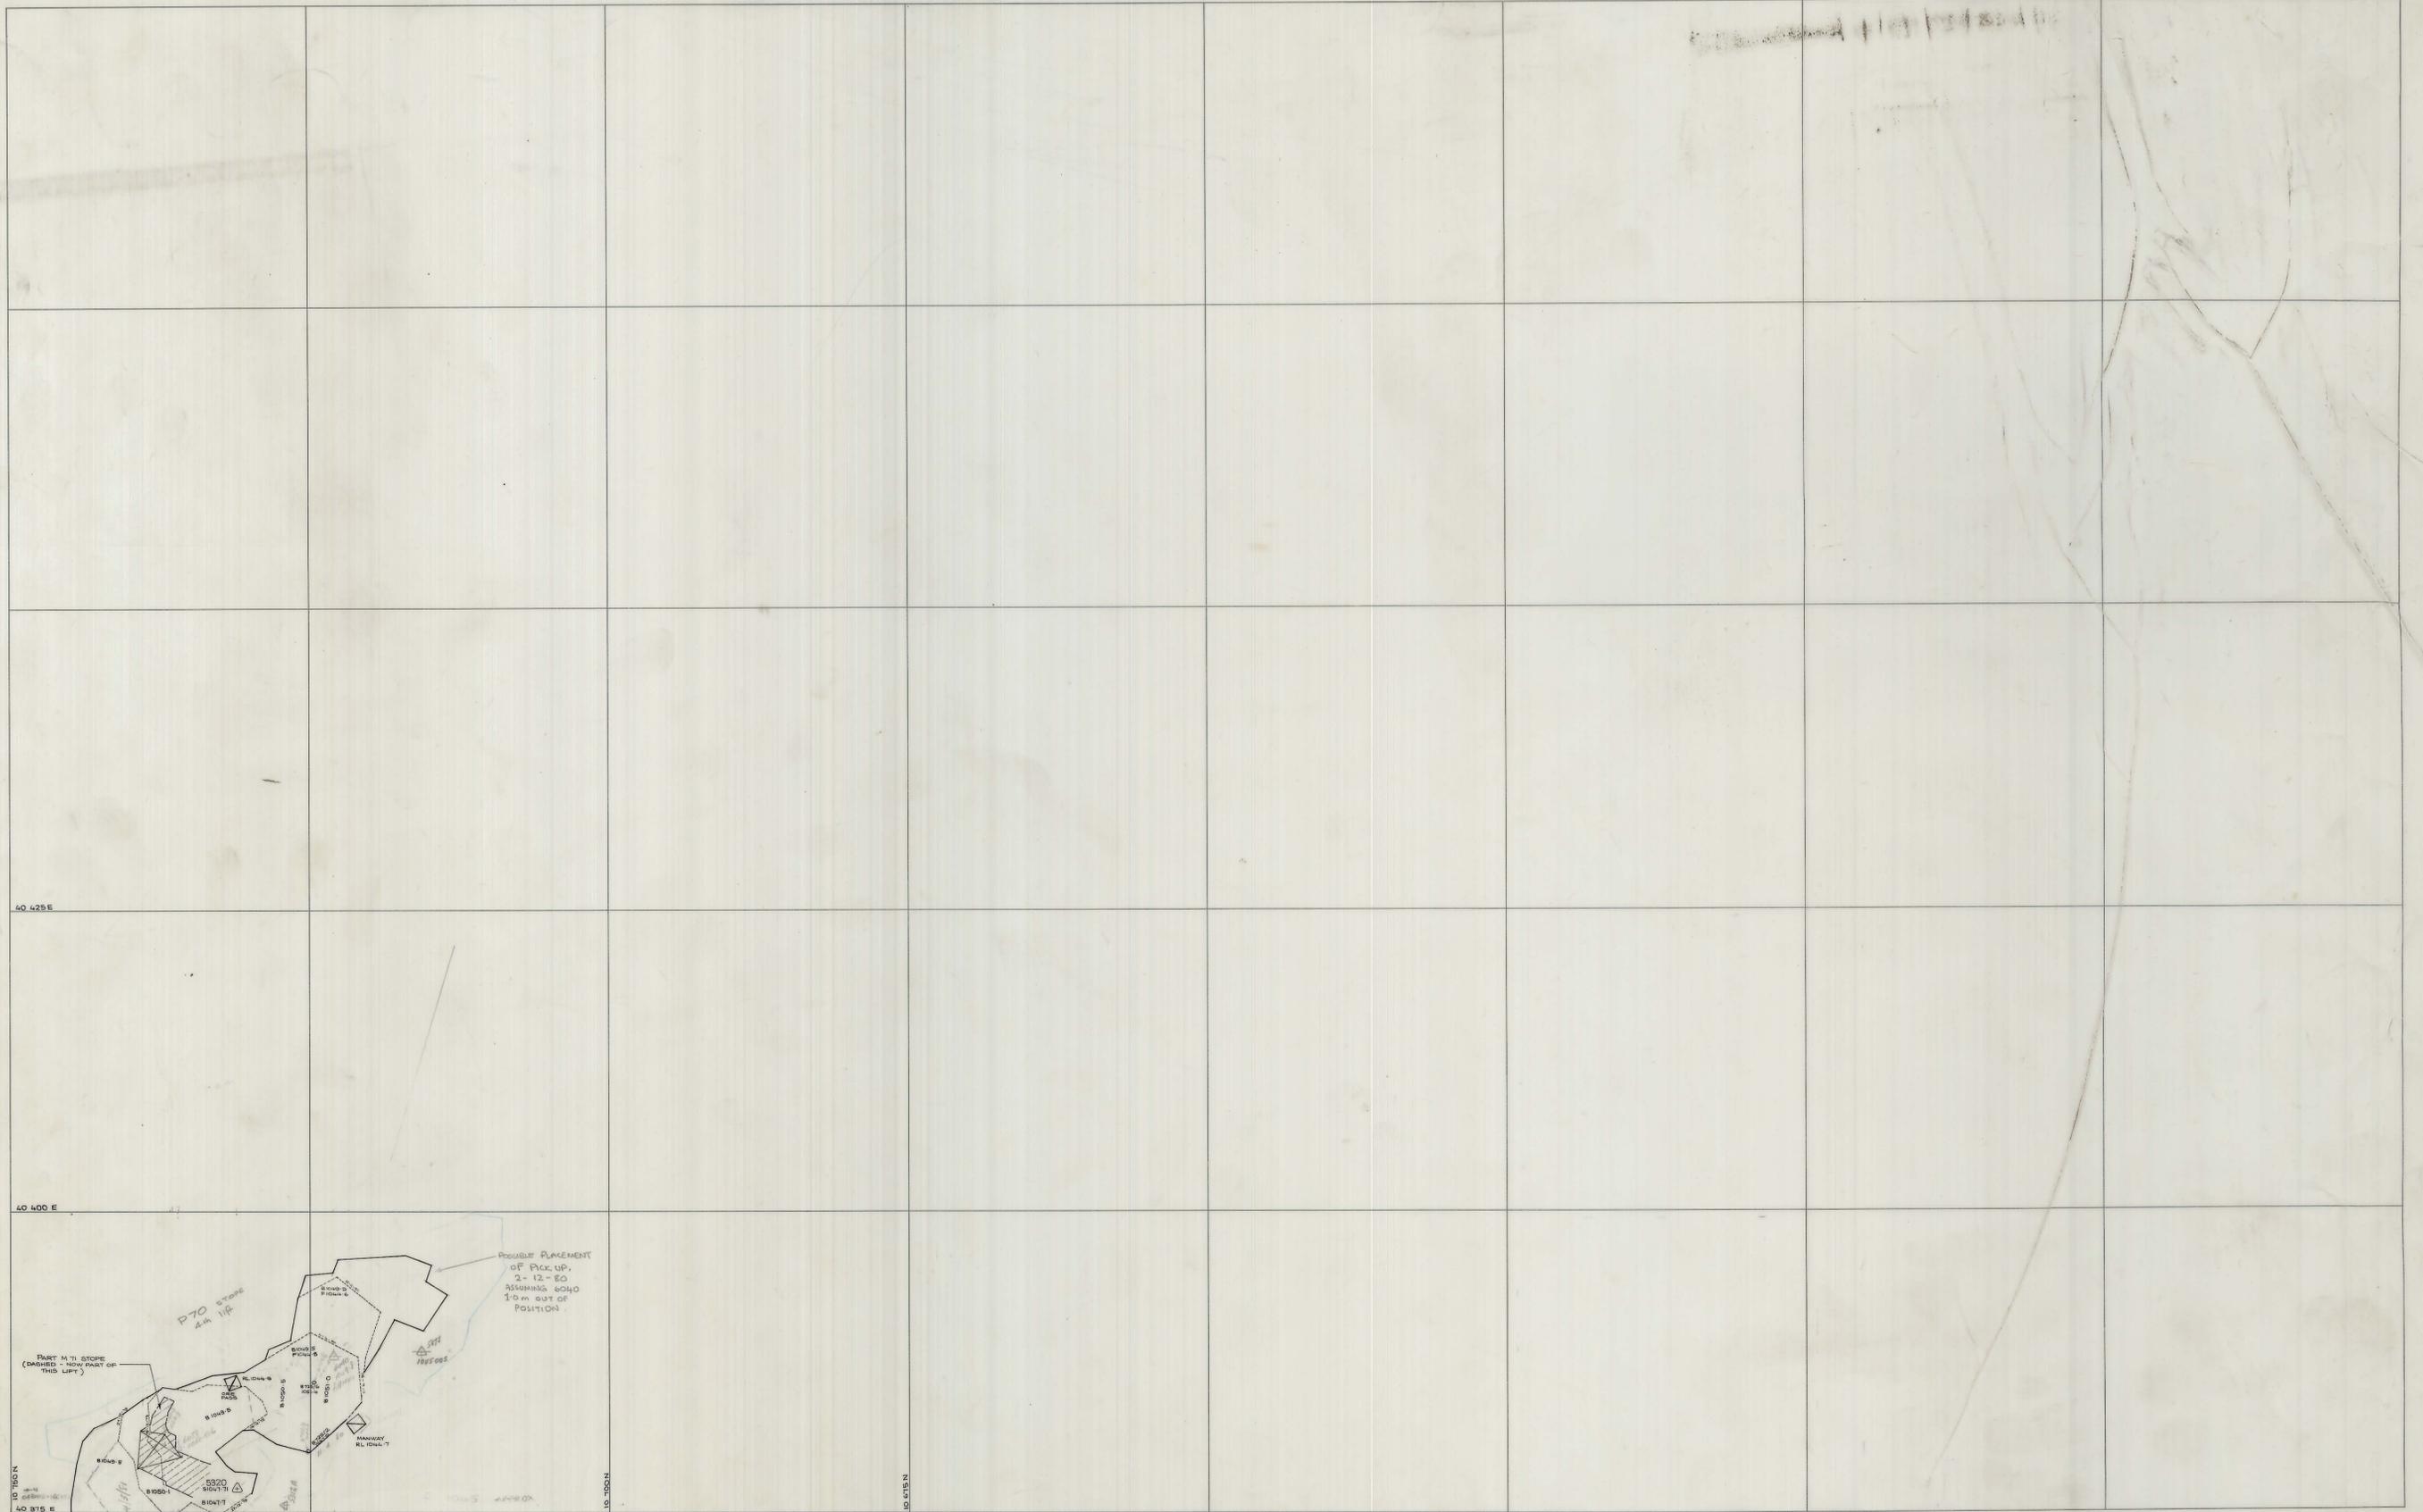

60 425 E

40 400 E

10 375 E

10 350 E

10 325 E

10 300 E

10 275 E

10 250 E

10 225 E

10 200 E

10 175 E

10 150 E

10 125 E

10 100 E

10 75 E

10 50 E

10 350 N

10 325 N

10 300 N

10 275 N

10 250 N

10 225 N

10 200 N

10 175 N

10 150 N

10 125 N

10 100 N

10 75 N

10 50 N

10 350 N

10 325 N

10 300 N

10 275 N

10 250 N

10 225 N

10 200 N

10 175 N

10 150 N

10 125 N

10 100 N

10 75 N

10 50 N

SCALE 1:250

04BH13-166 103

LOCATION

BOLD HEAD MINE

SUBJECT

P70 STOPE

4th lift

LOCATION

BOLD HEAD MINE

SUBJECT

P70 STOPE

4th lift

KING ISLAND SCHEELITE

A DIVISION OF WARMAN INTERNATIONAL

GRASSY KING ISLAND

PLAN NUMBER

04BH13 - 166 103

north