



27 JUN 1981

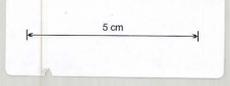

04BH13 - 166 105

P 70
3rd
lift

0374_4506

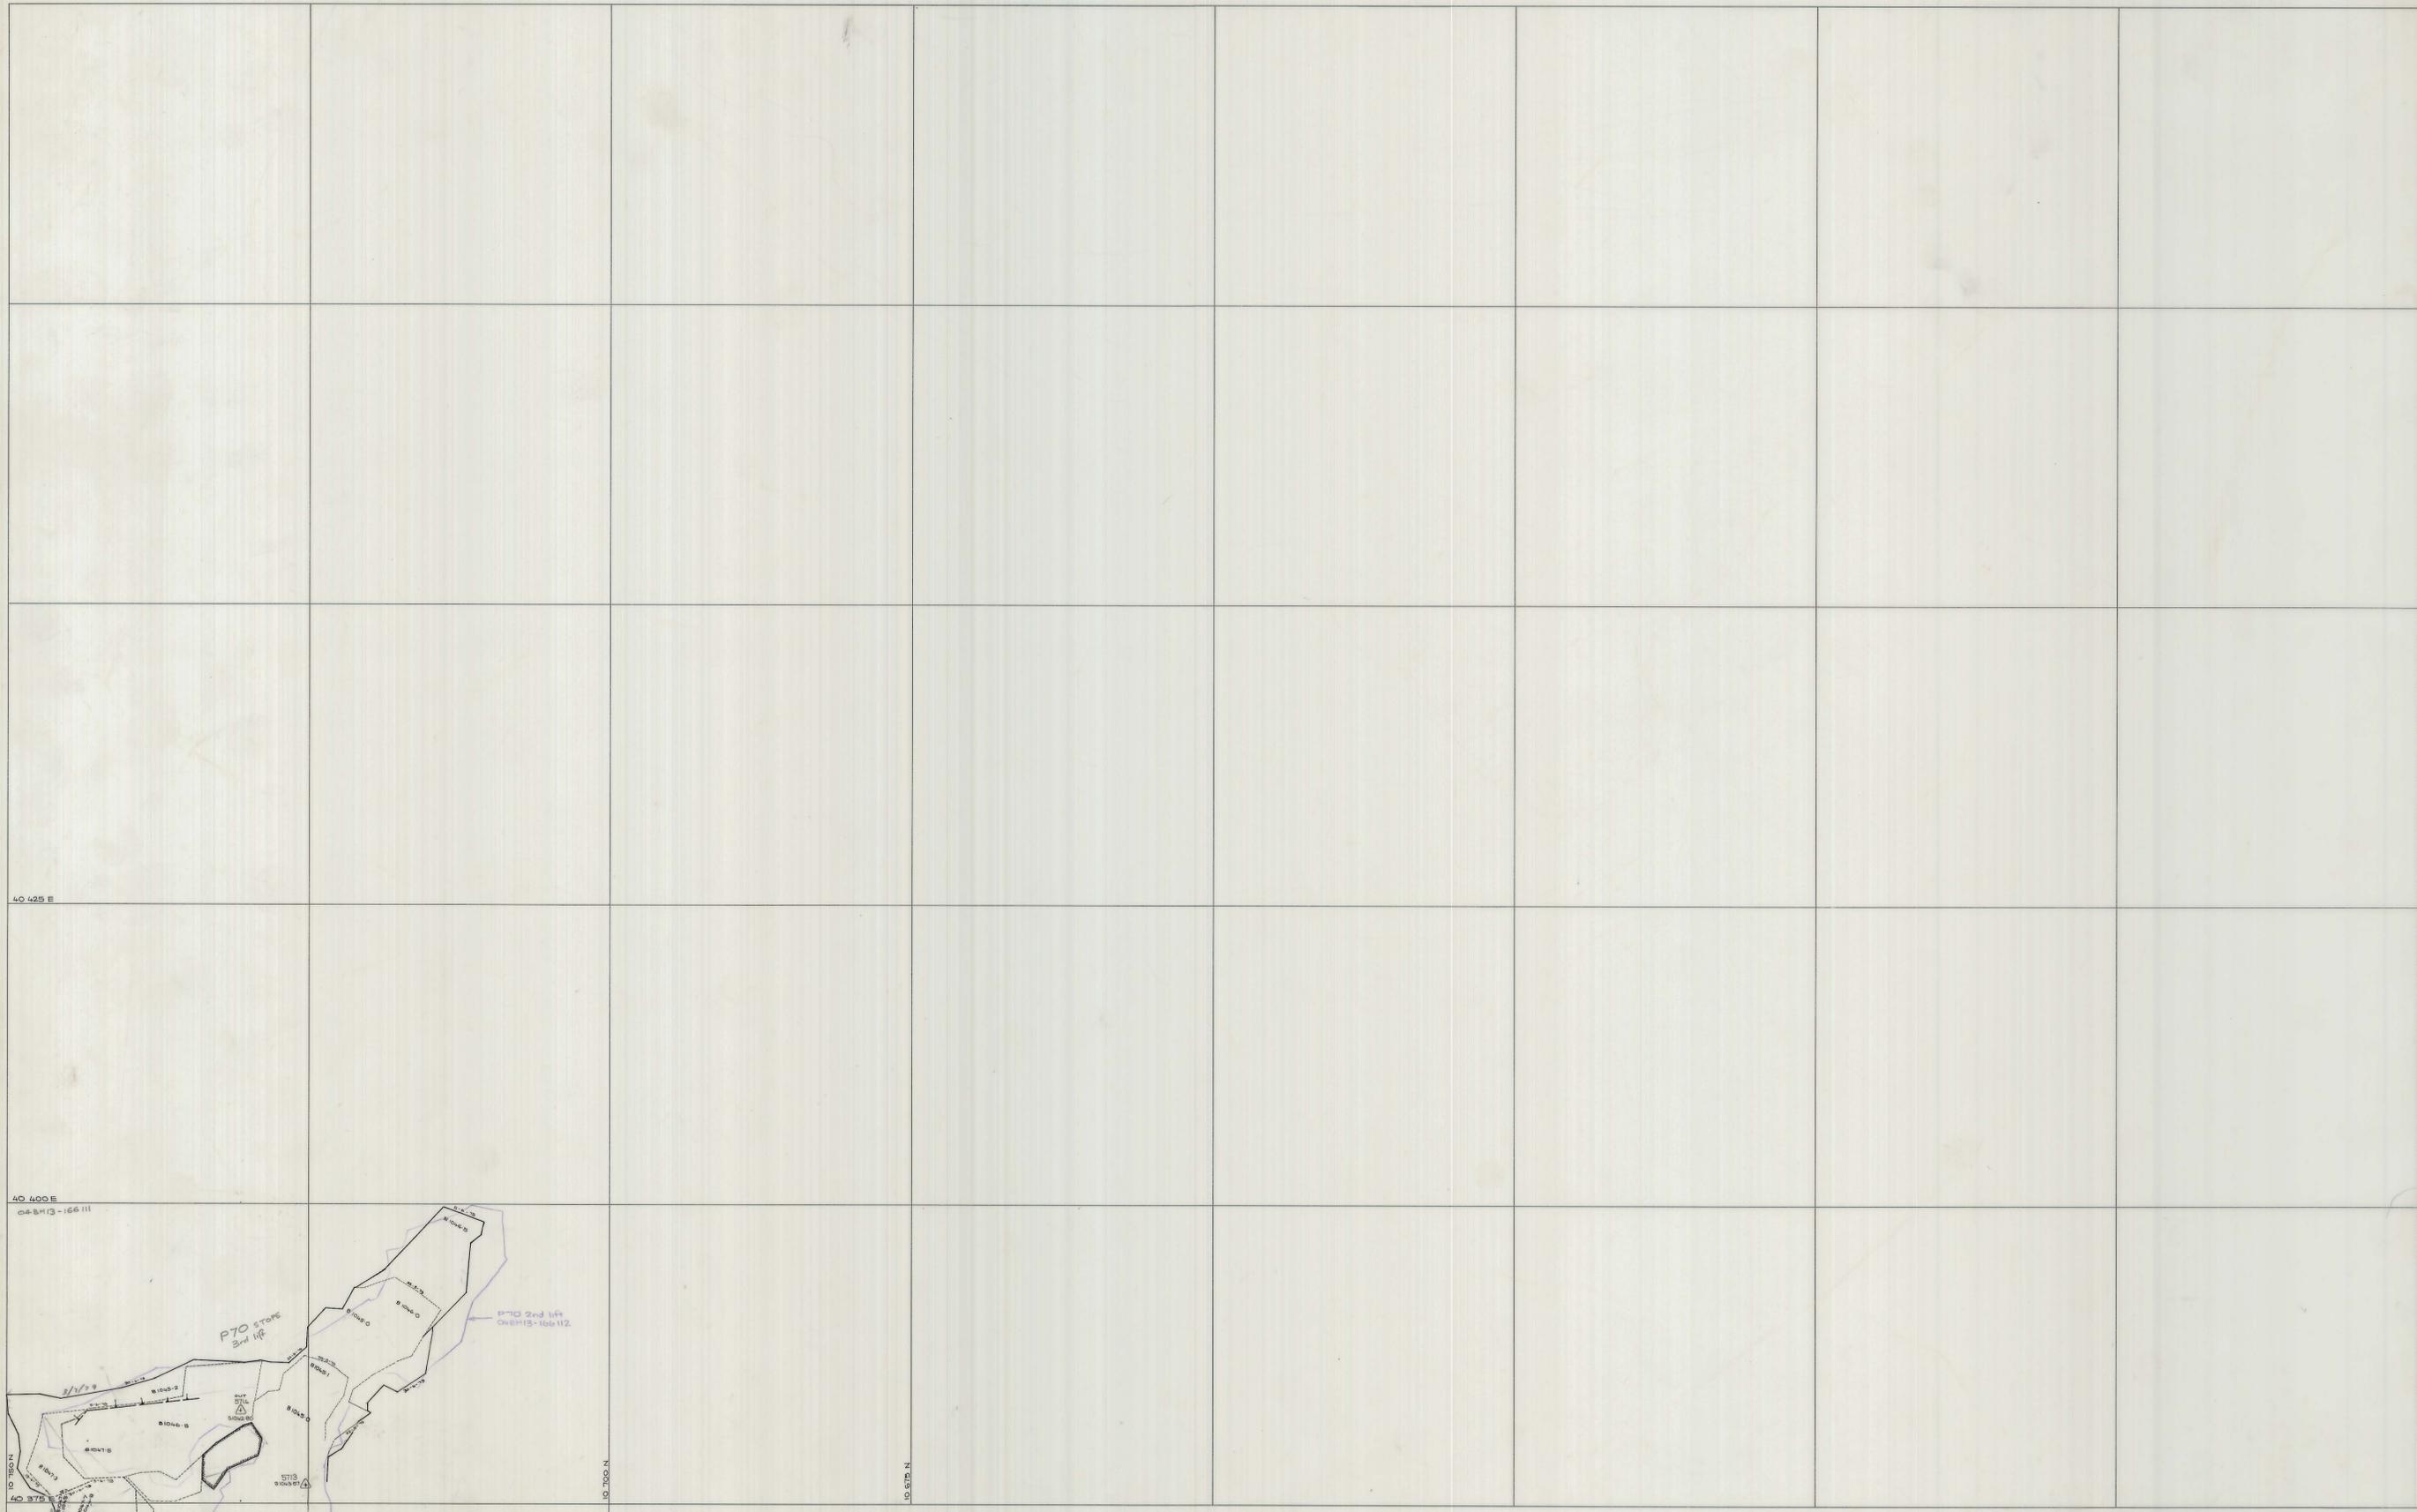

LOCATION BOLD HEAD MINE

SUBJECT
P 70
3rd lift

north

KIS KING ISLAND SCHEELITE
A DIVISION OF HERMAN INTERNATIONAL

GRASSY KING ISLAND

PLAN NUMBER 04BH13 - 166 105