


5 cm

04BH13 - 166 108

P70
LIFT 2.

0374_4507

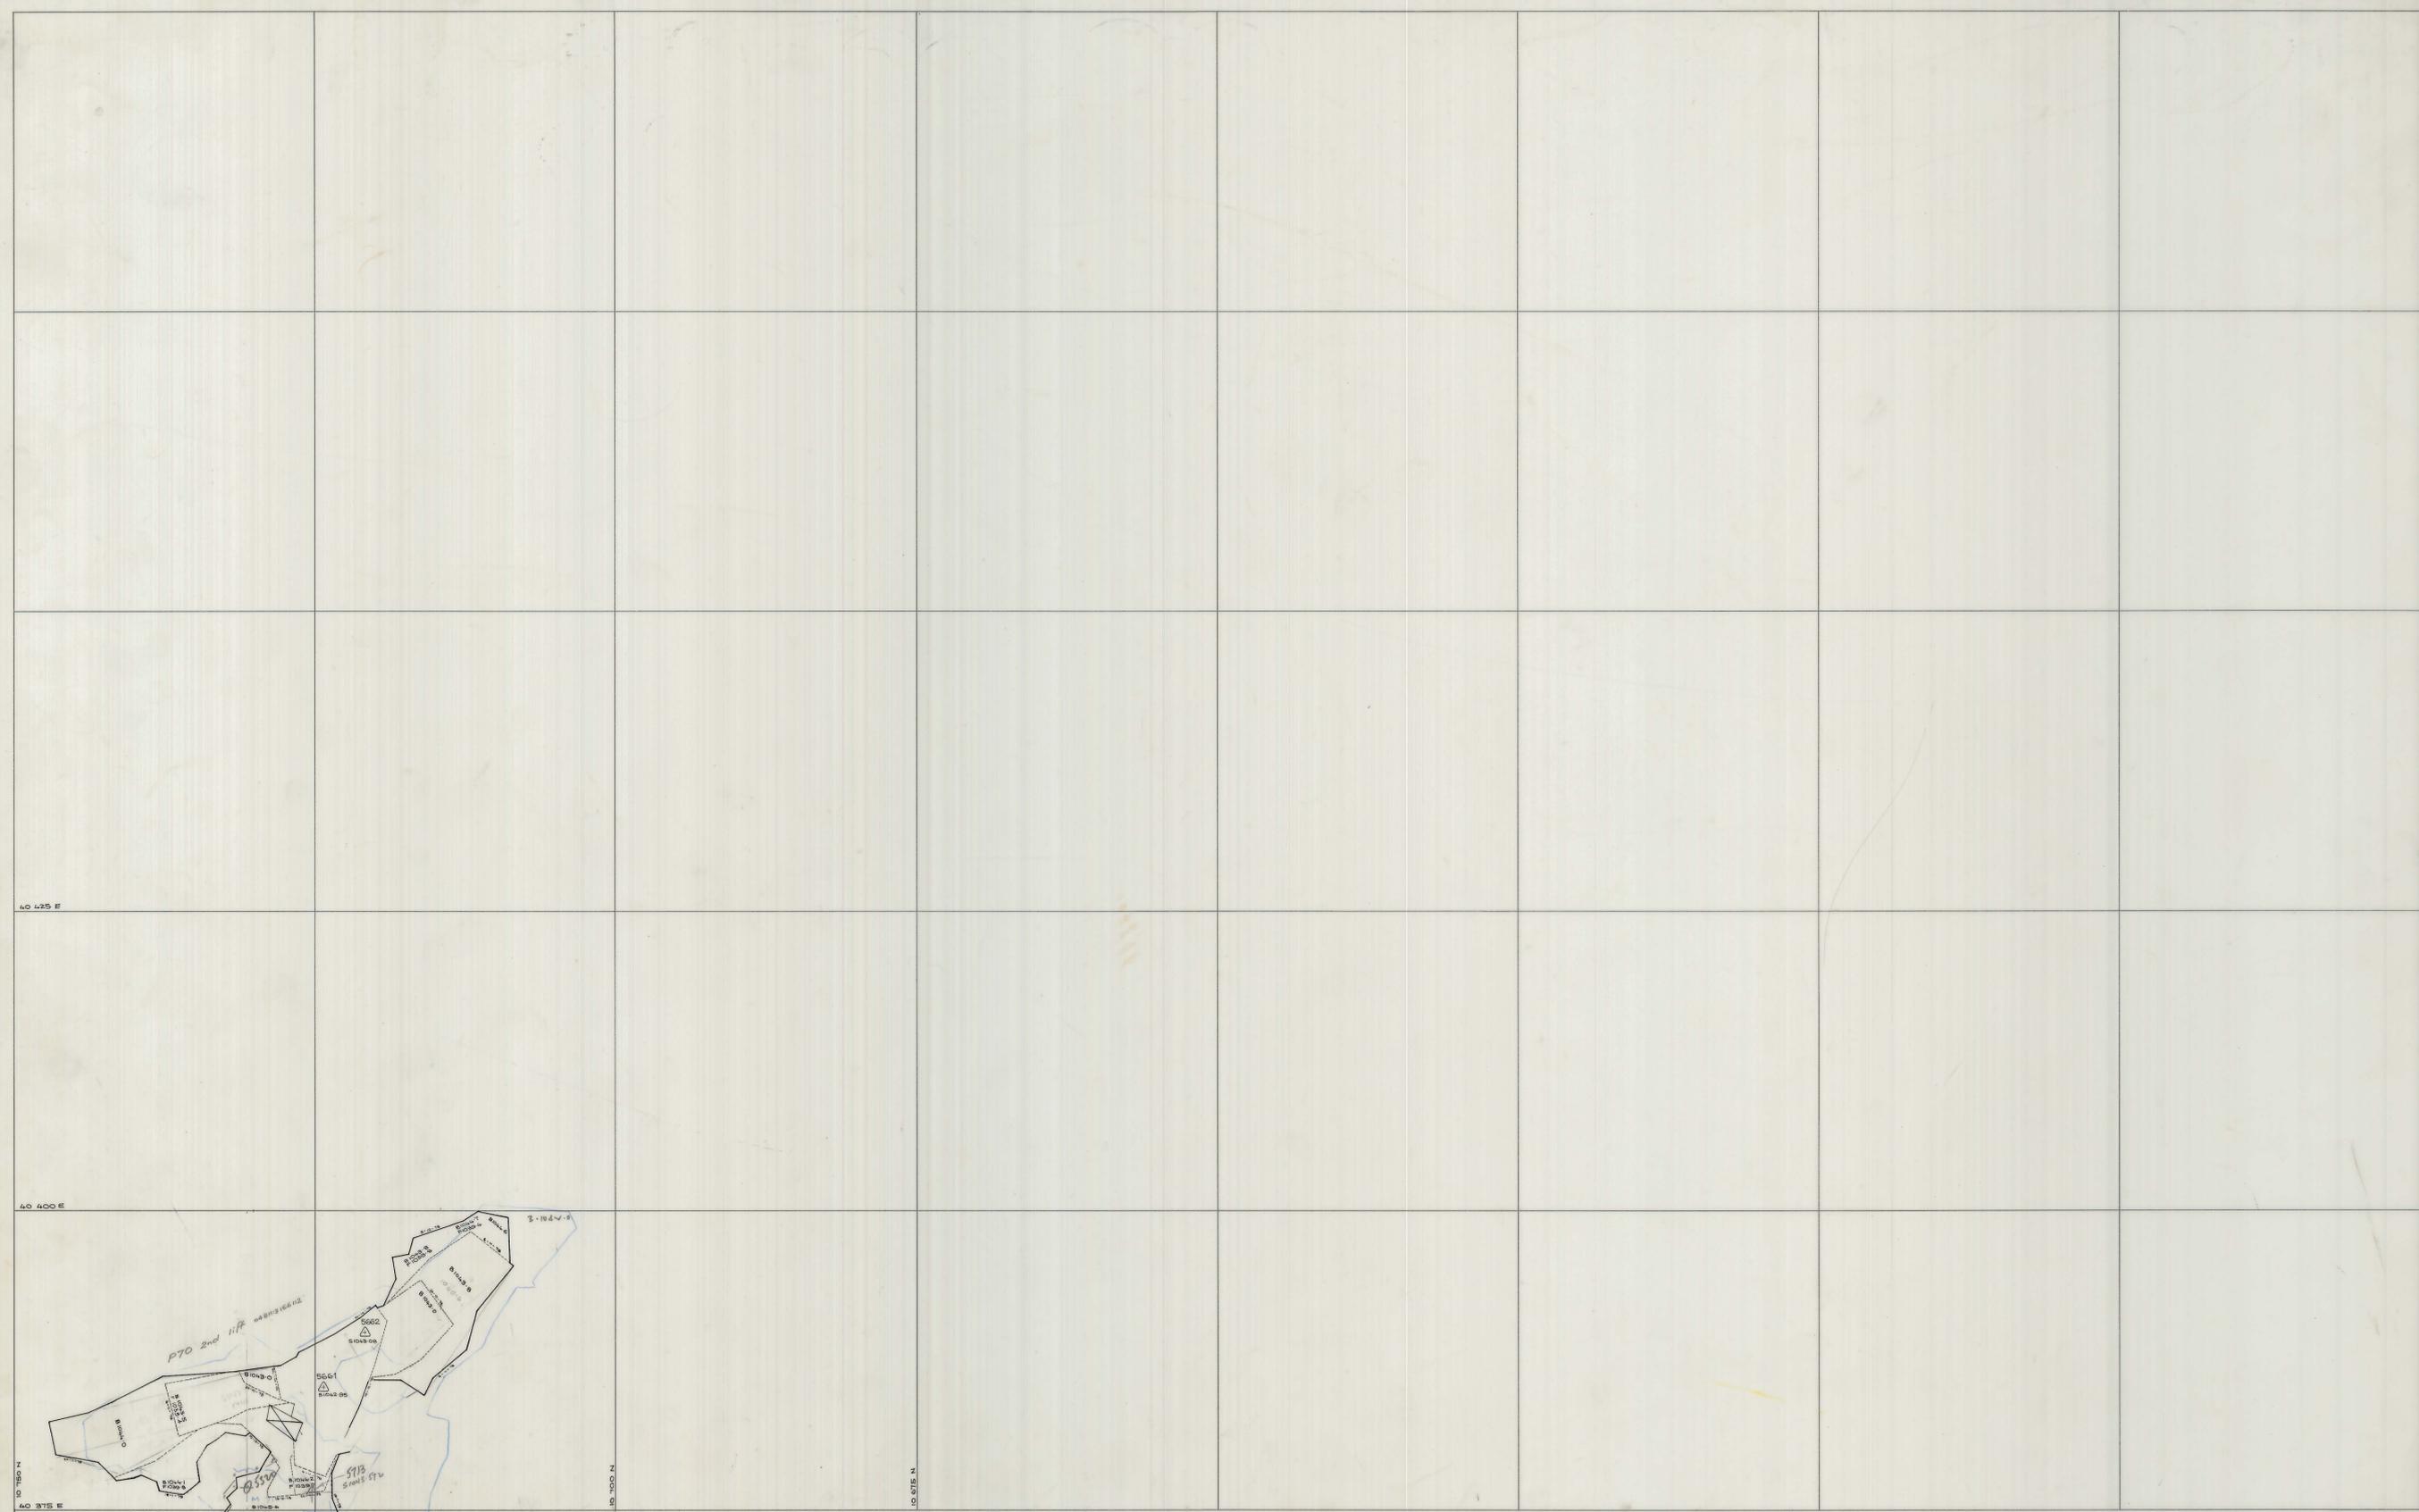

NO 425 E
NO 400 E
NO 375 E
NO 350 N
NO 325 N
NO 300 N
NO 275 N
NO 250 N
NO 225 N
NO 200 N
NO 175 N
NO 150 N
NO 125 N
NO 100 N
NO 75 N
NO 50 N
NO 25 N
NO 0 N
NO 25 S
NO 50 S
NO 75 S
NO 100 S
NO 125 S
NO 150 S
NO 175 S
NO 200 S
NO 225 S
NO 250 S
NO 275 S
NO 300 S
NO 325 S
NO 350 S
NO 375 S
NO 400 S
NO 425 S

SCALE 1:250

north

LOCATION
BOLD HEAD MINE

SUBJECT
P70 STOPE
2nd lift

KIS KING ISLAND SCHEELITE
A DIVISION OF YARRAN INTERNATIONAL

GRASSY KING ISLAND

PLAN NUMBER
04BH13 - 166 108