
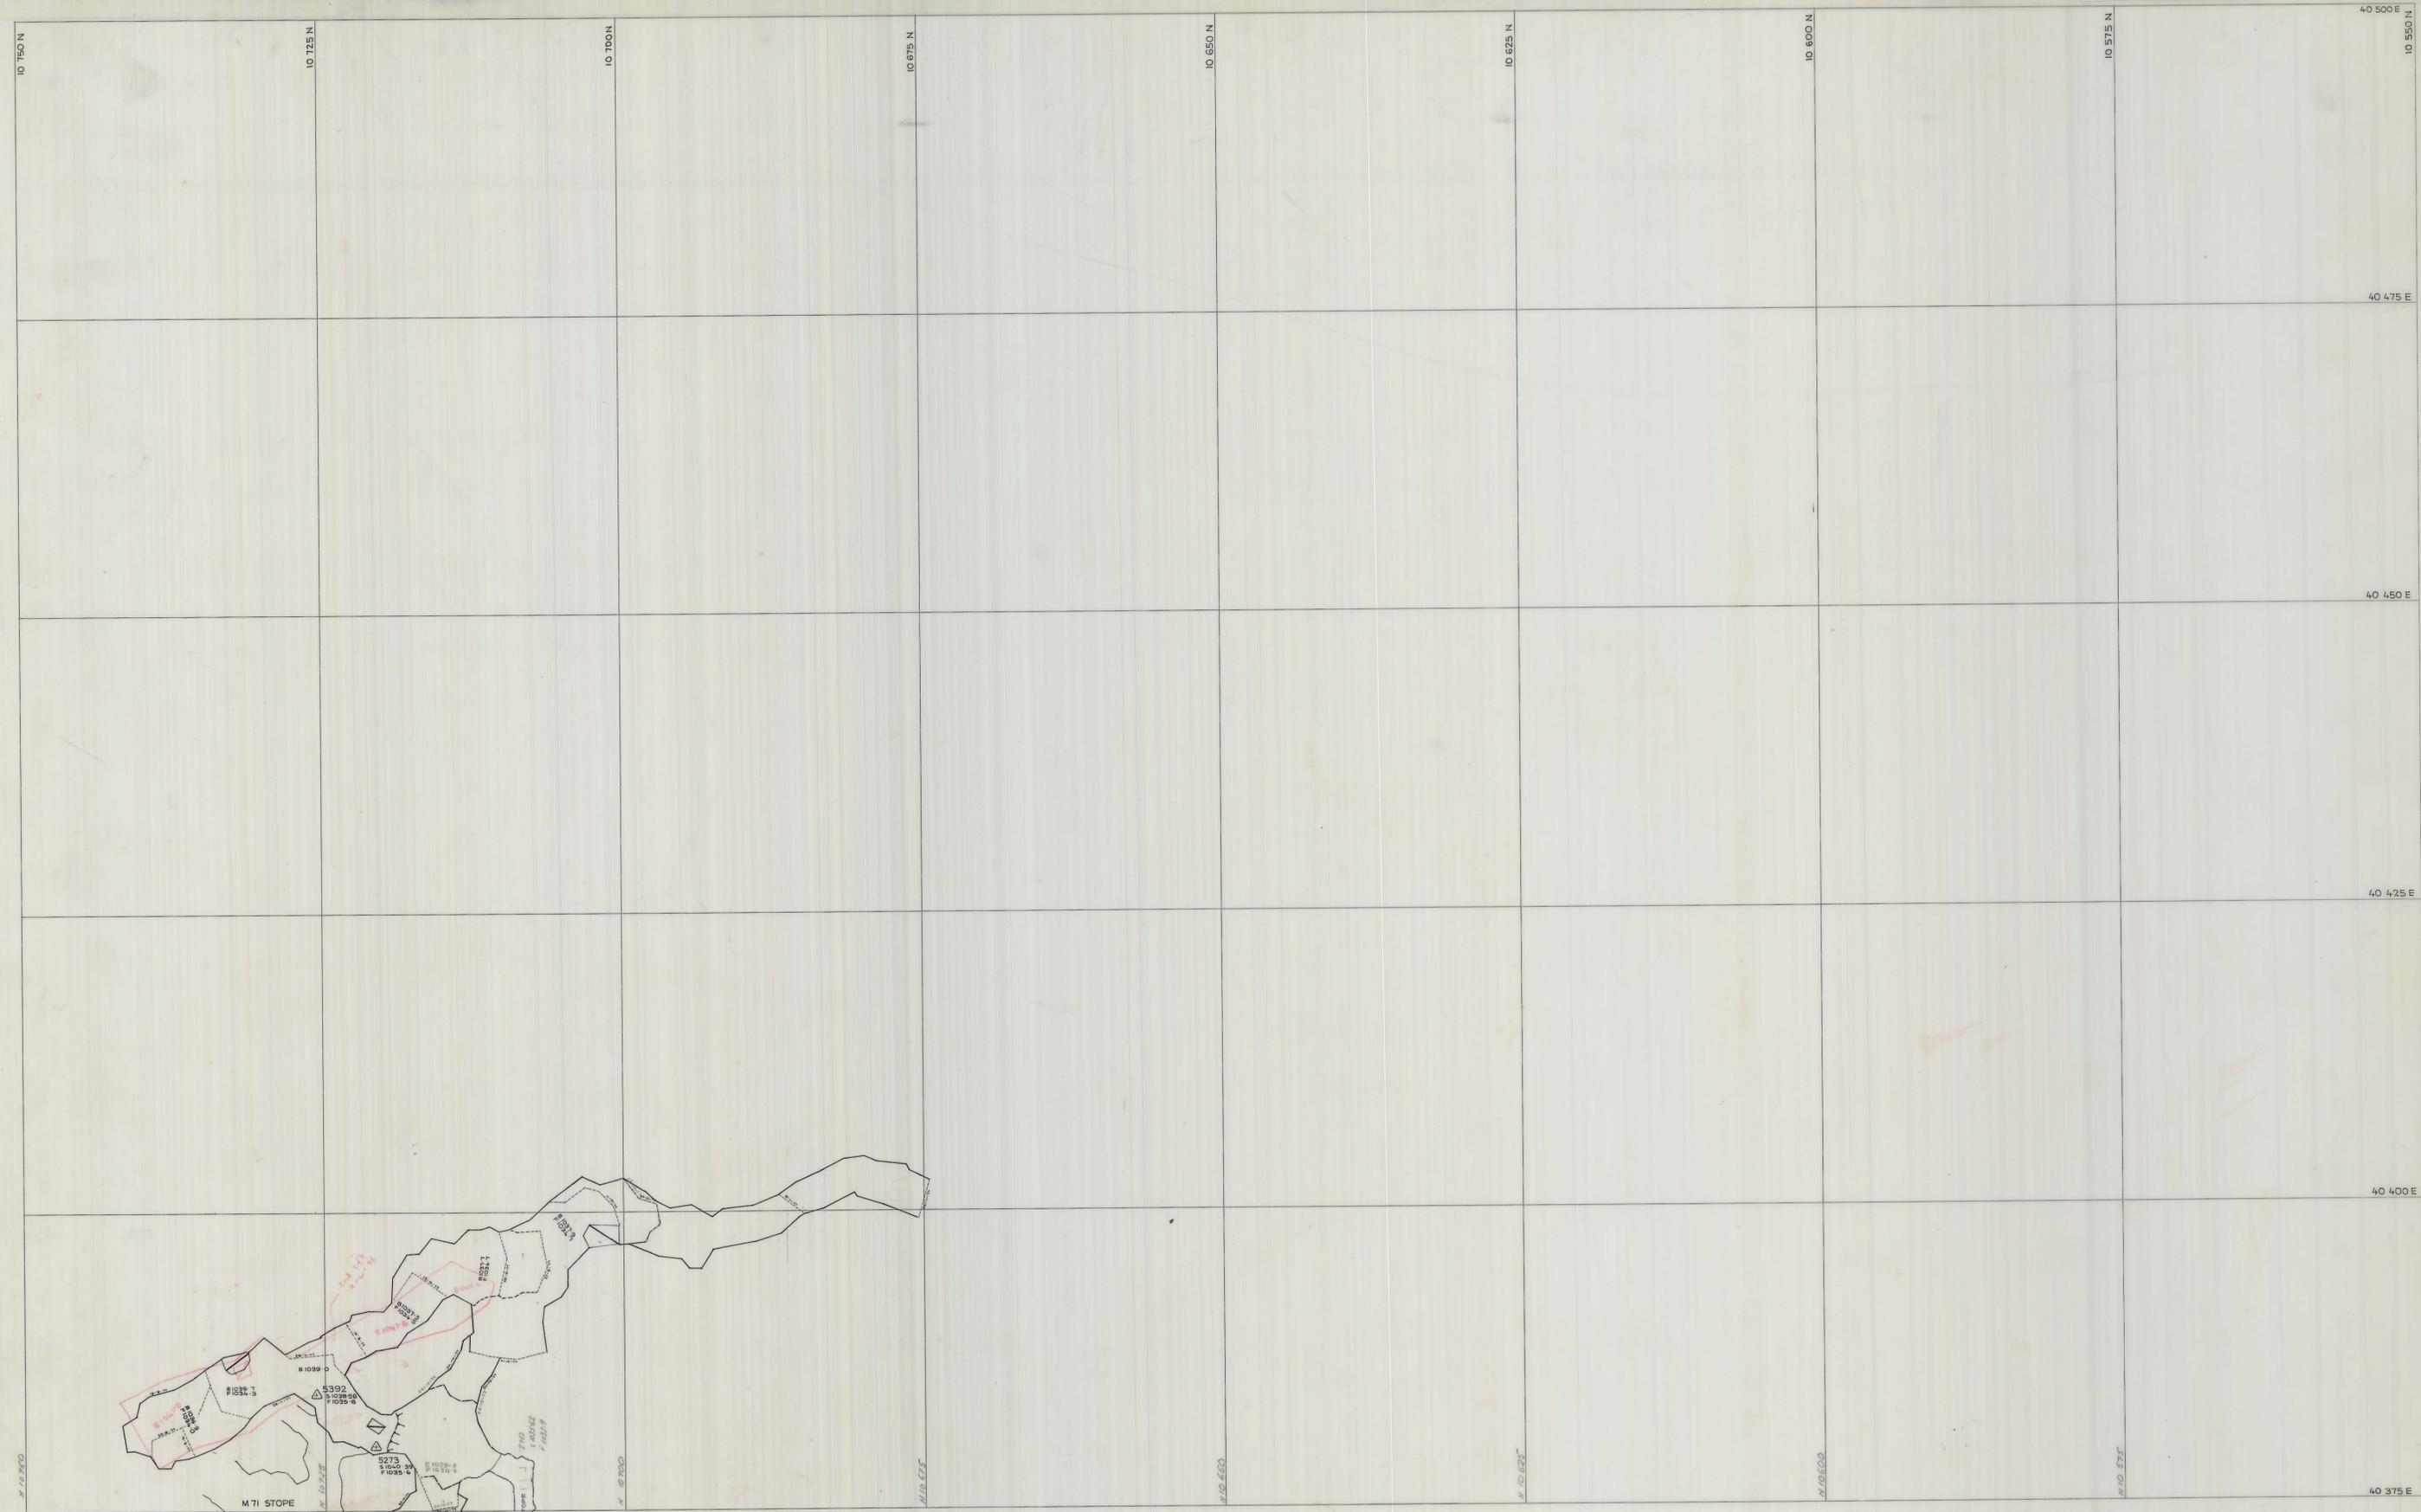


0374\_4509

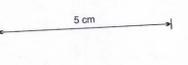

N 10 750

10 725 N

10 700 N

10 675 N

10 650 N

10 625 N

10 600 N

10 575 N

40 500 E

40 475 E

40 450 E

40 425 E

40 400 E

40 375 E

SCALE 1:250

north

LOCATION  
BOLD HEAD MINE

SUBJECT  
P70 STOPE  
B LENS MAIN OREBODY

GRASSY KING ISLAND

PLAN NUMBER  
04BH13 - 166 114