
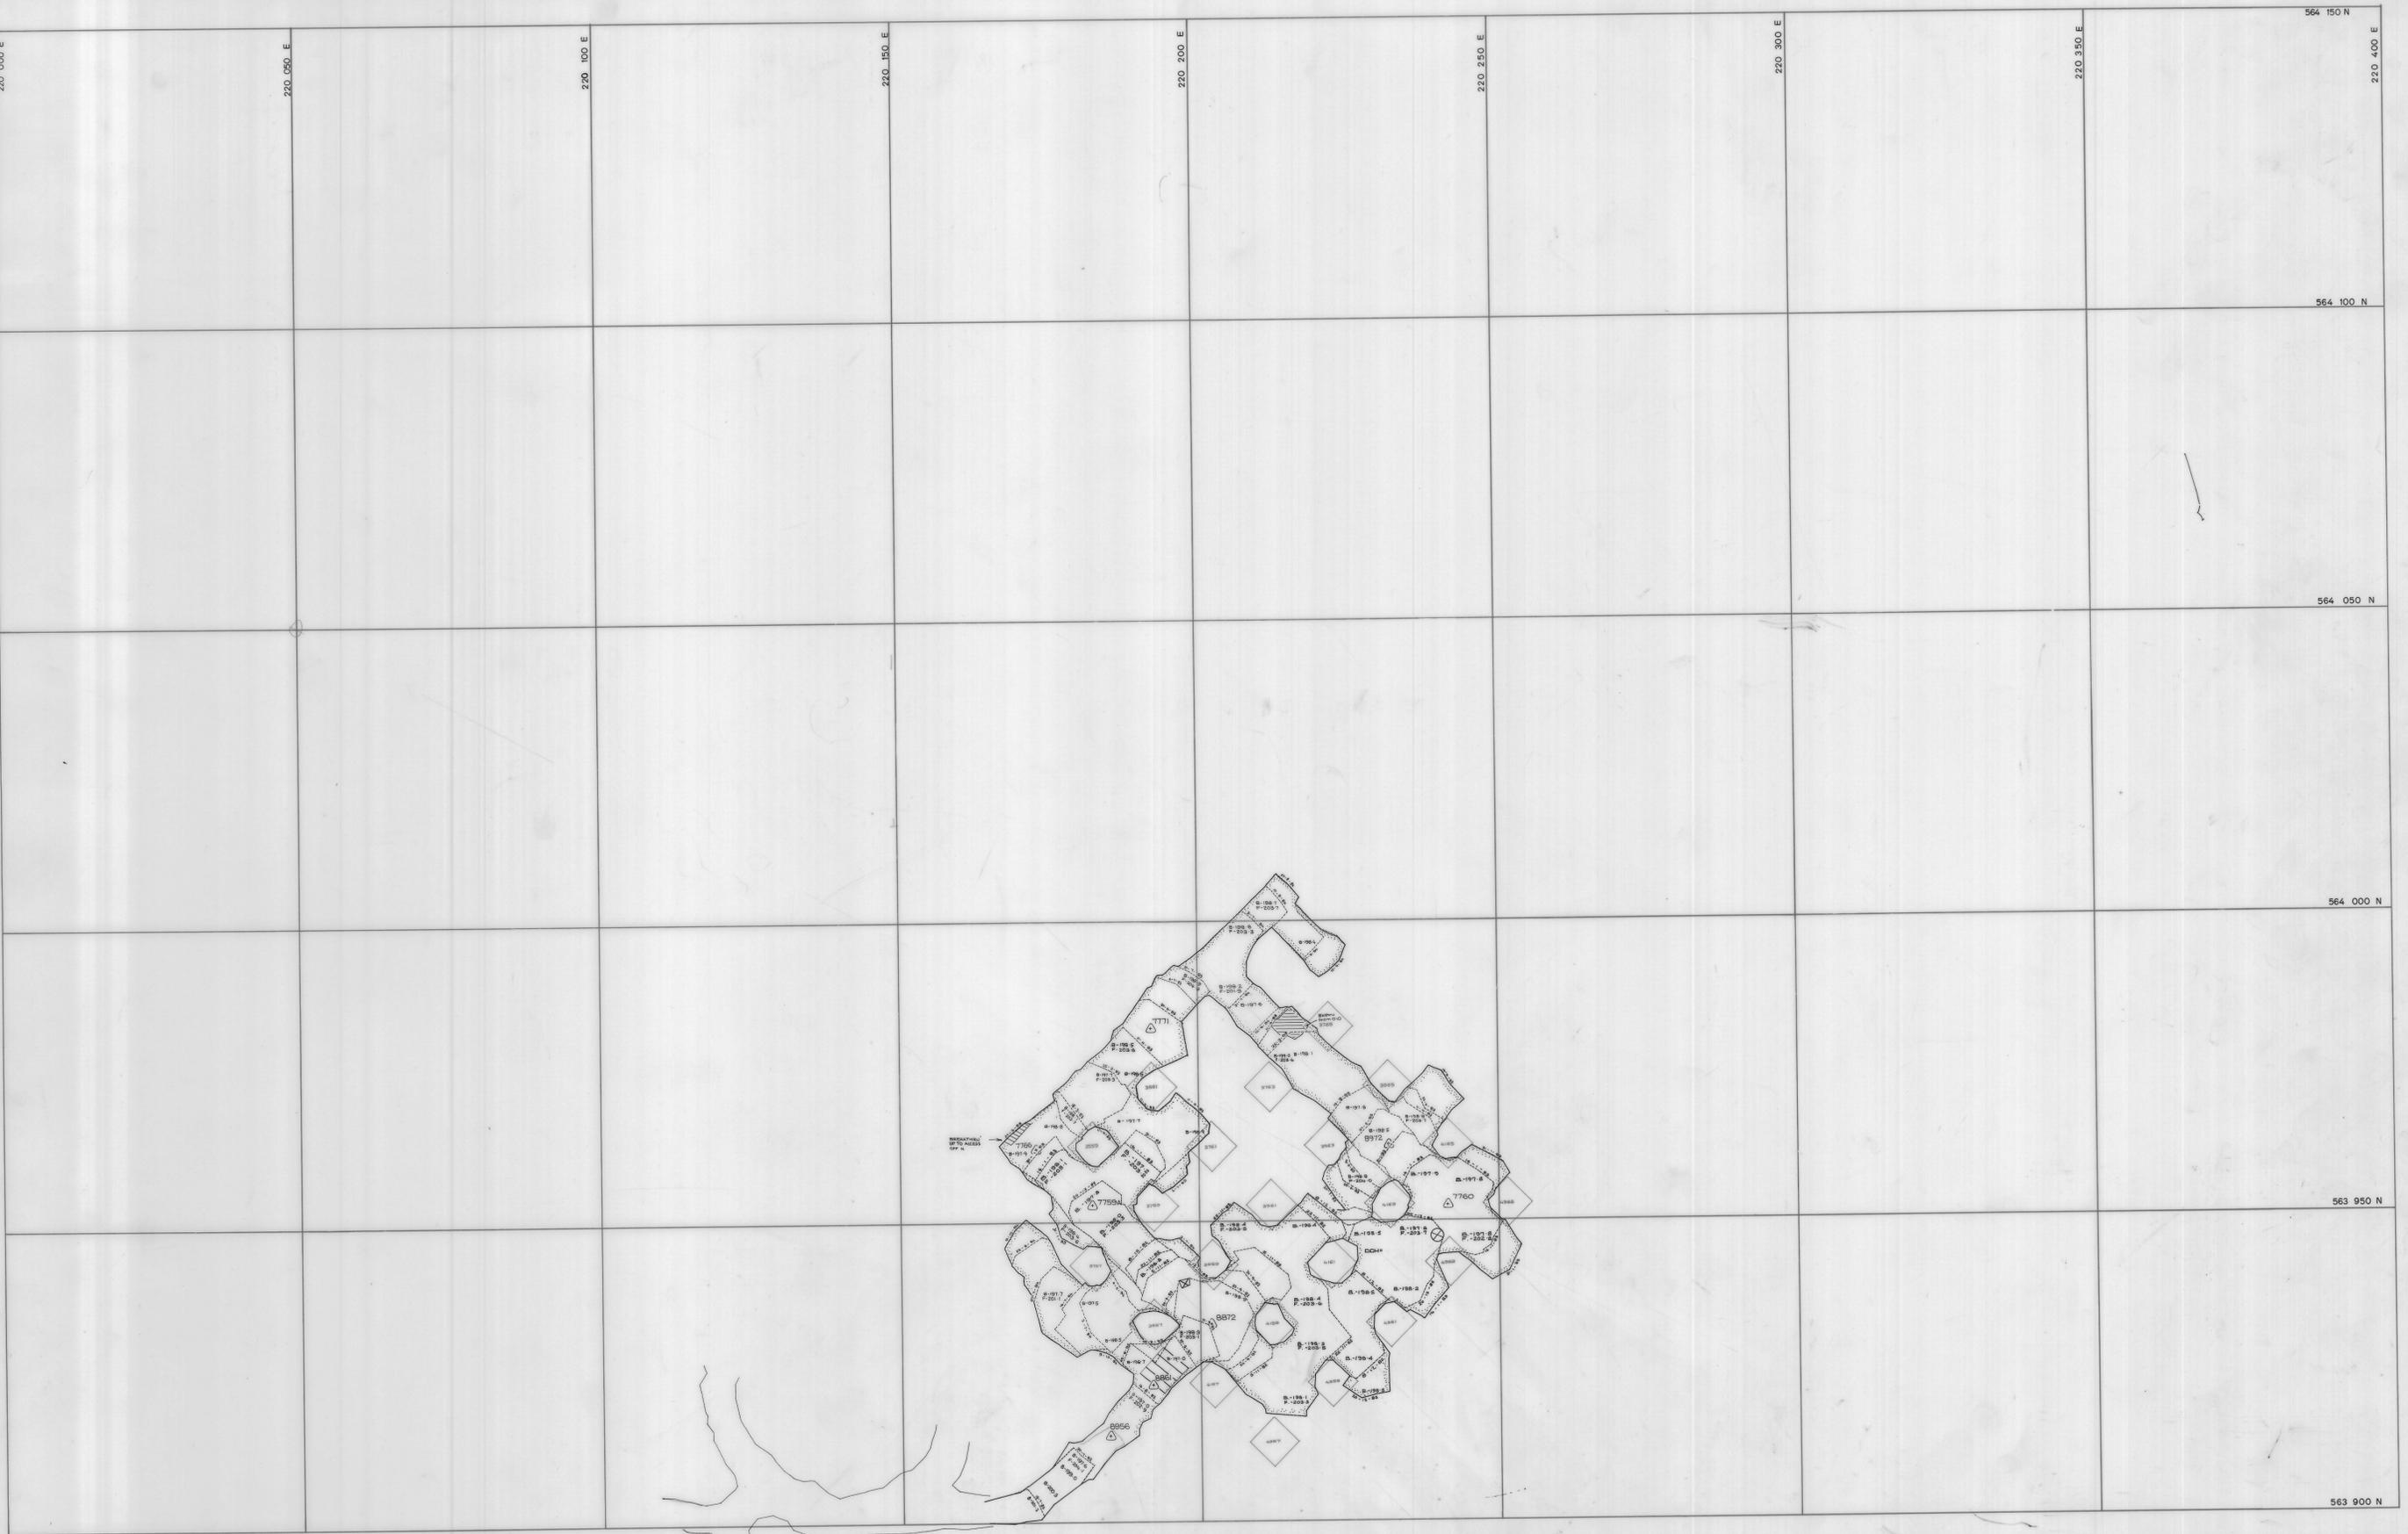


0374 - 451

04DM15 - 1052  
SECTION DATE 1987

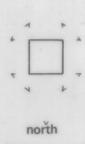

	<p>SCALE 1:500</p> 	 <p>north</p>	<p>LOCATION DOLPHIN MINE</p> <p>SUBJECT LOWER PIT STOPE -202.5 m CONTOUR</p>	 <p>KING ISLAND SCHEELITE A DIVISION OF WARMAN INTERNATIONAL</p> <p>GRASSY KING ISLAND</p> <p>PLAN NUMBER 04DM15 - 1052</p>
--	--	--	--	--