



27 JUN 1981

04 BH 13-166 122

P57 STOPE

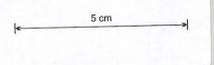

0374_4510

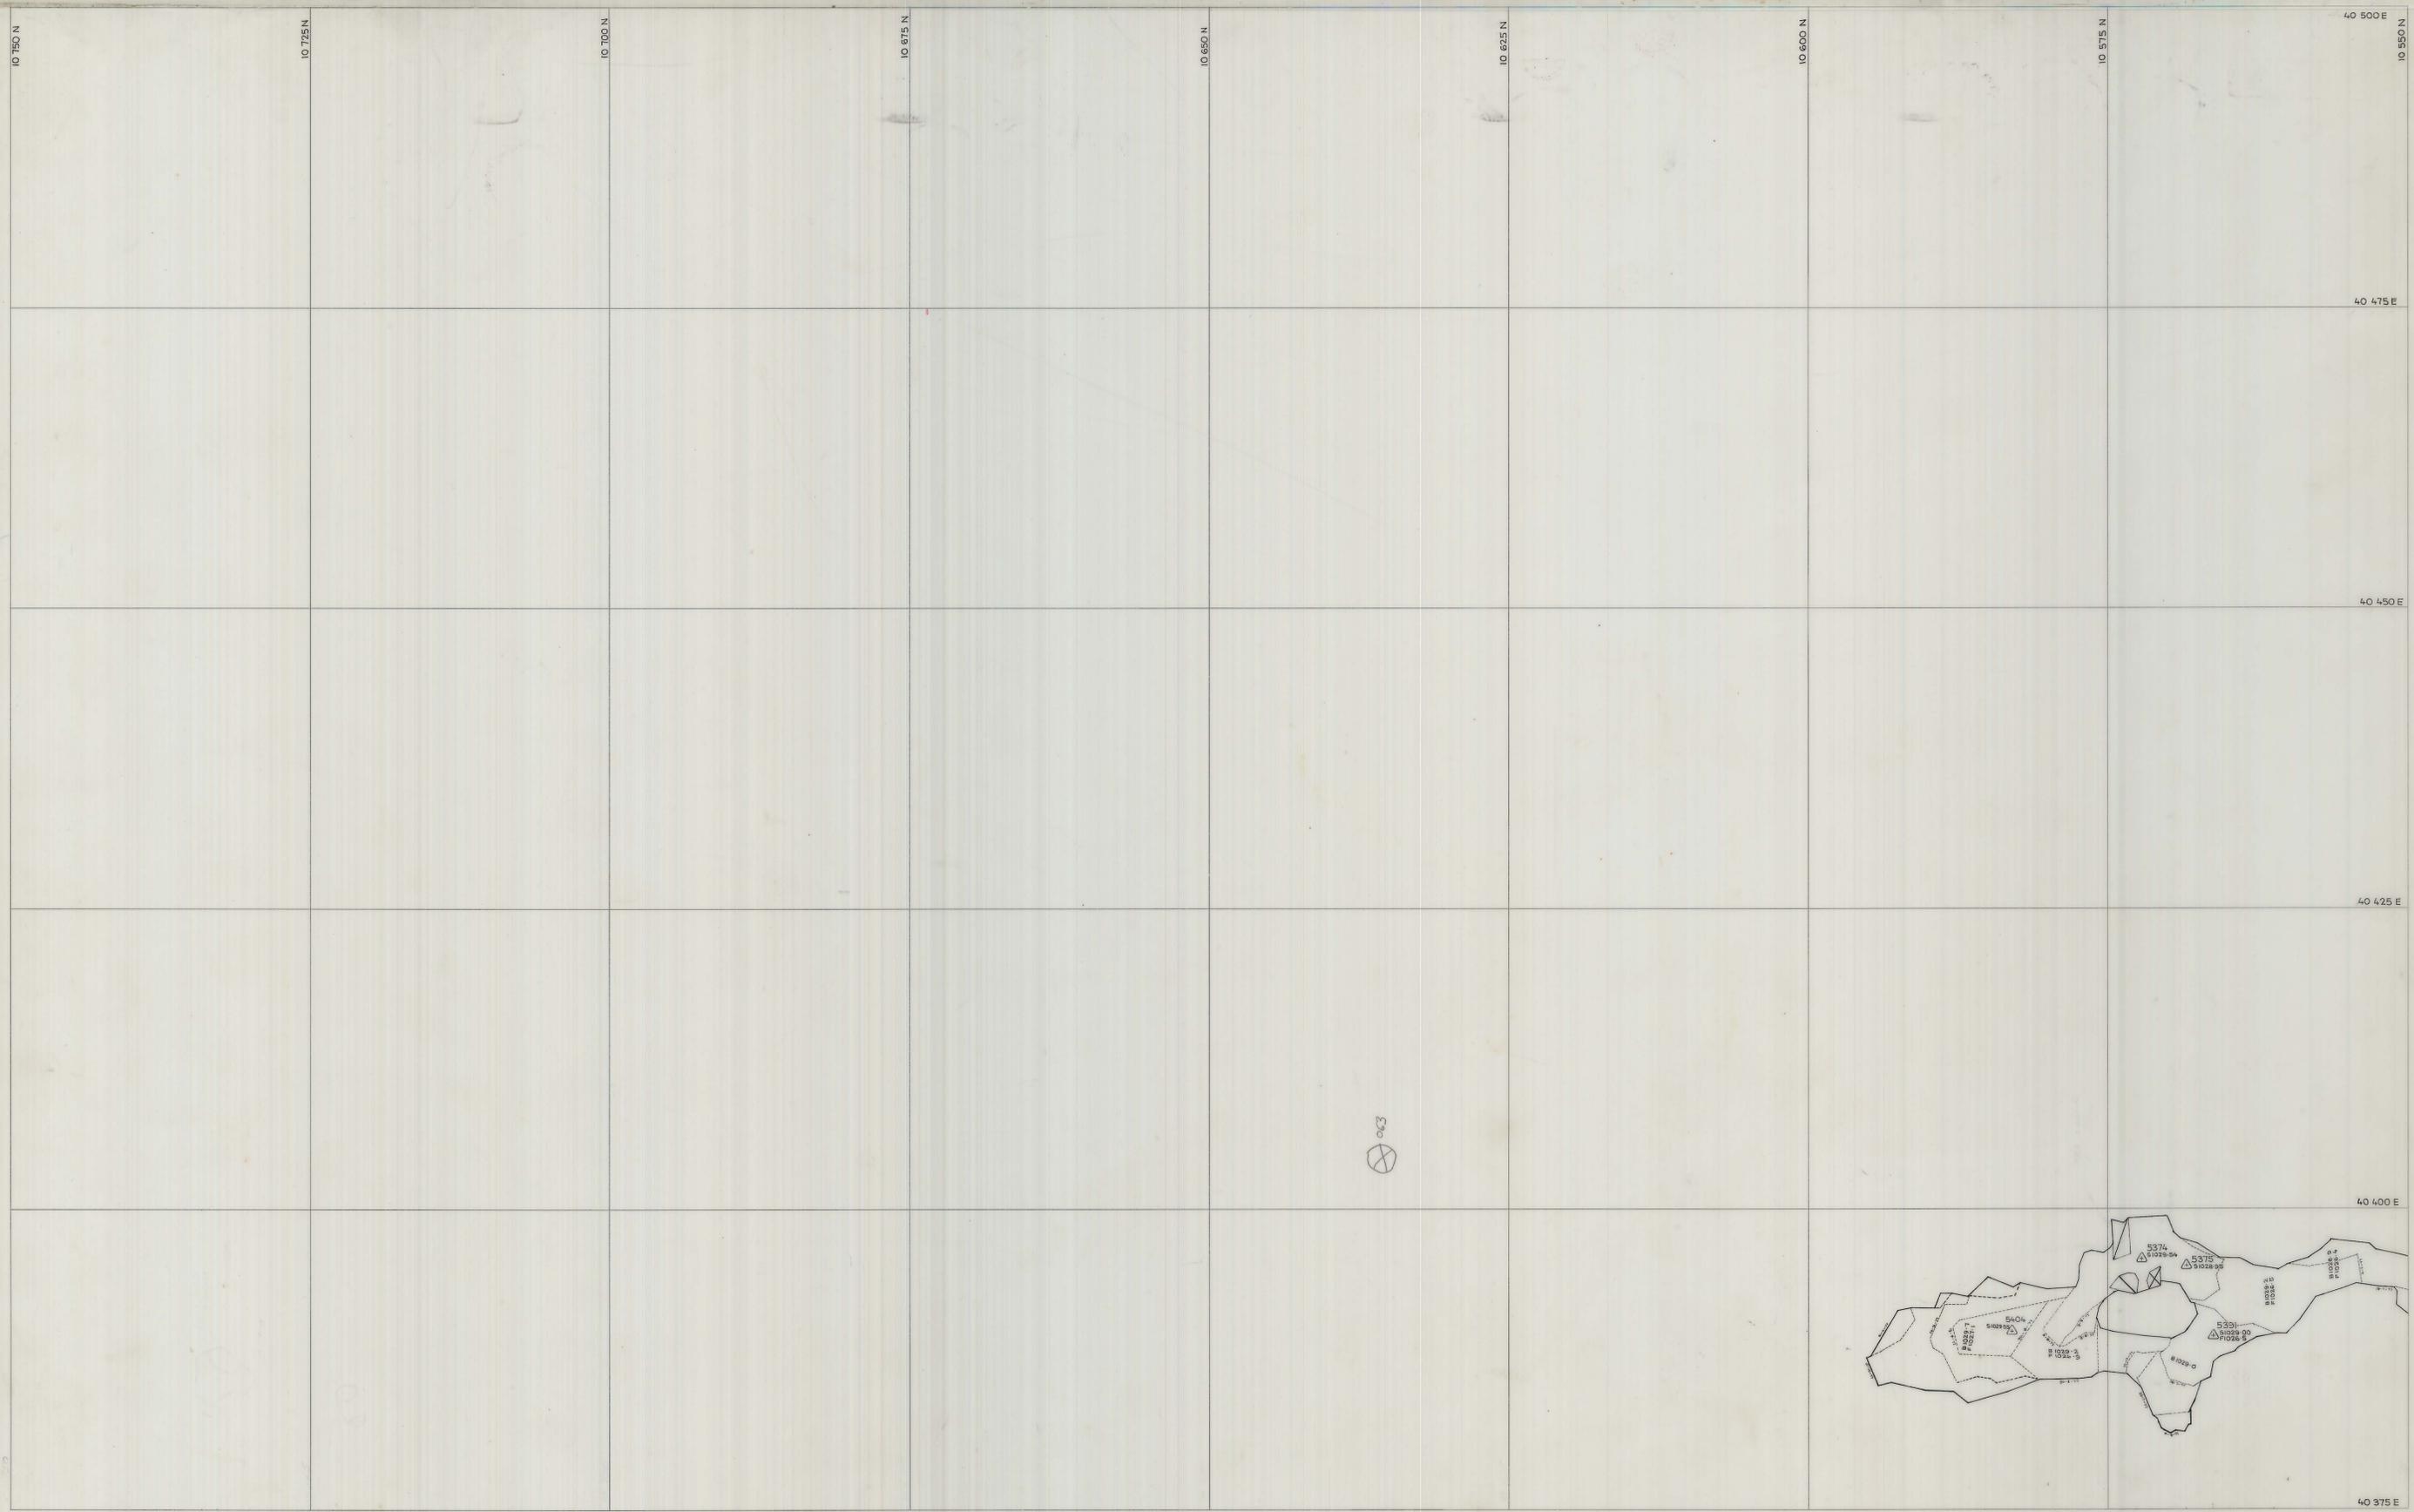

	SCALE	1:250		LOCATION	BOLD HEAD MINE
	SUBJECT	north			SUBJECT
	 A DIVISION OF WARMAN INTERNATIONAL GRASSY KING ISLAND PLAN NUMBER 04BH13 - 166 122				