


27 JUN 1981

5 cm

04BH13 - 166 154

N 54
3RD LIFT

0374_4514

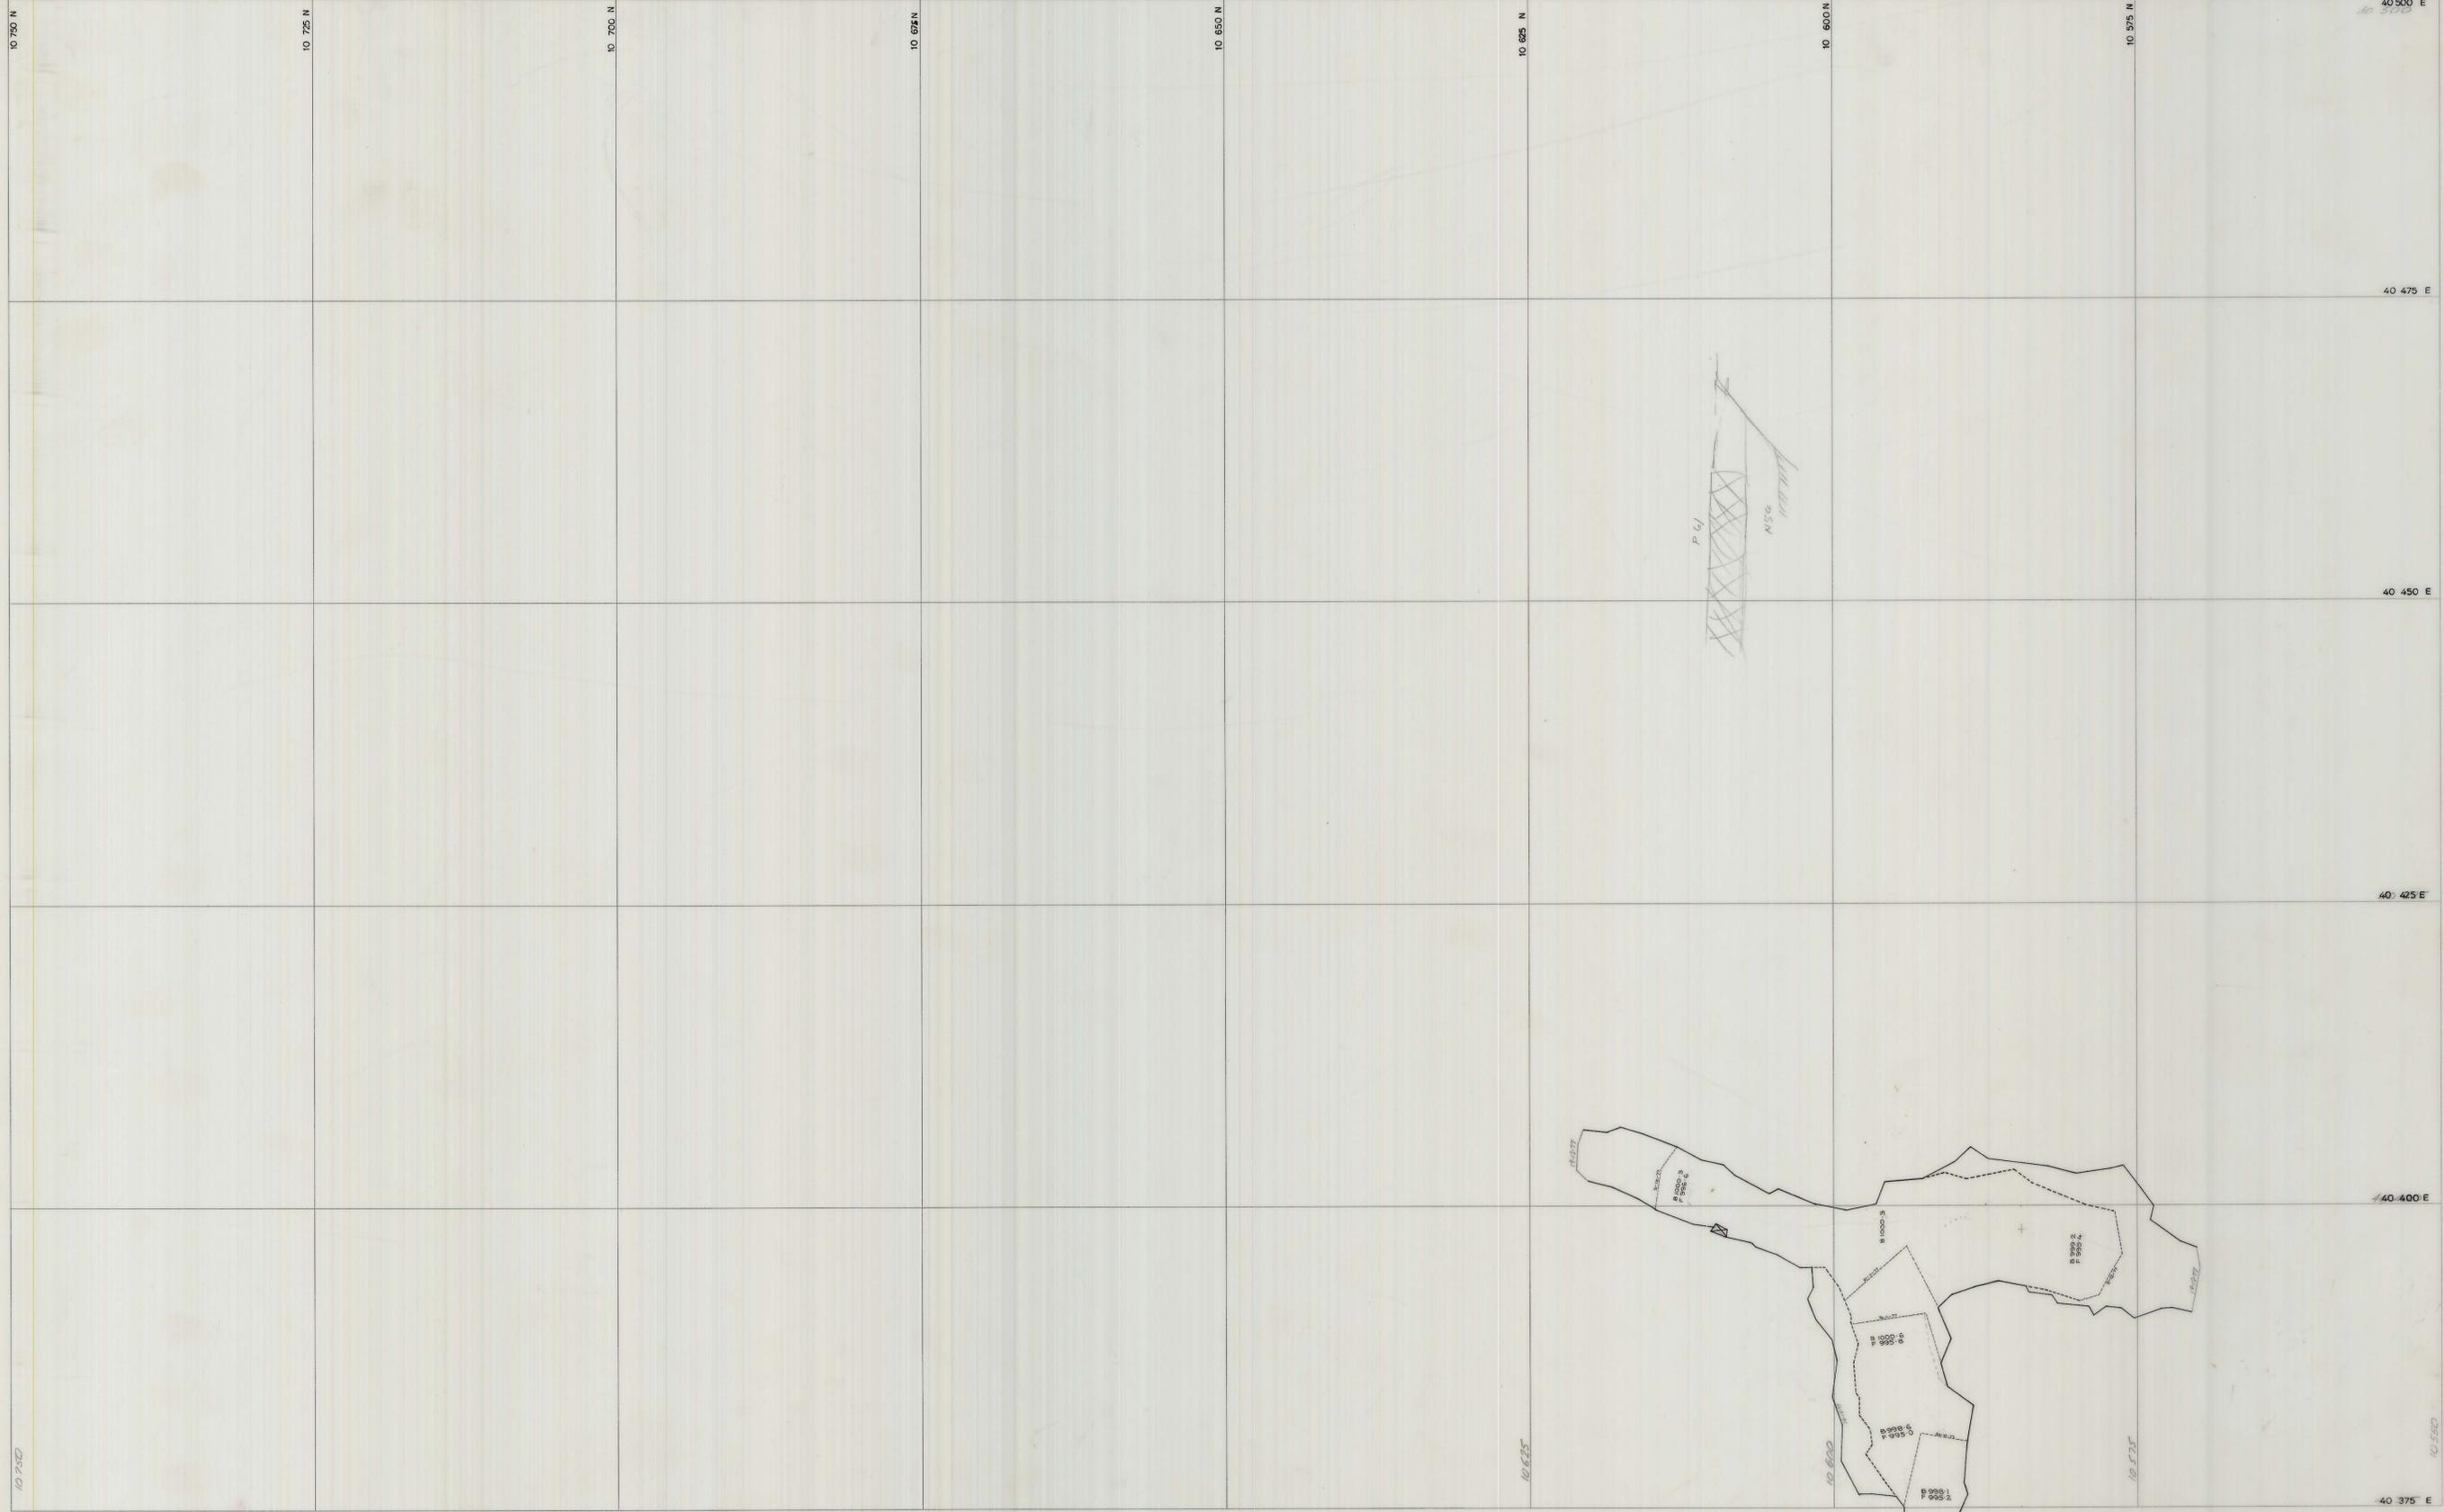

SCALE 1:250

north

LOCATION
BOLD HEAD MINE

SUBJECT
N54
CUT & FILL STOPE
[3rd LIFT]

KIS KING ISLAND SCHEELITE
A DIVISION OF WARMAN INTERNATIONAL

GRASSY KING ISLAND

PLAN NUMBER
04BH13 - 166 154