


27 JUN 1981

04BH13-166 156

N54  
2nd LIFT

0374\_4515

5 cm

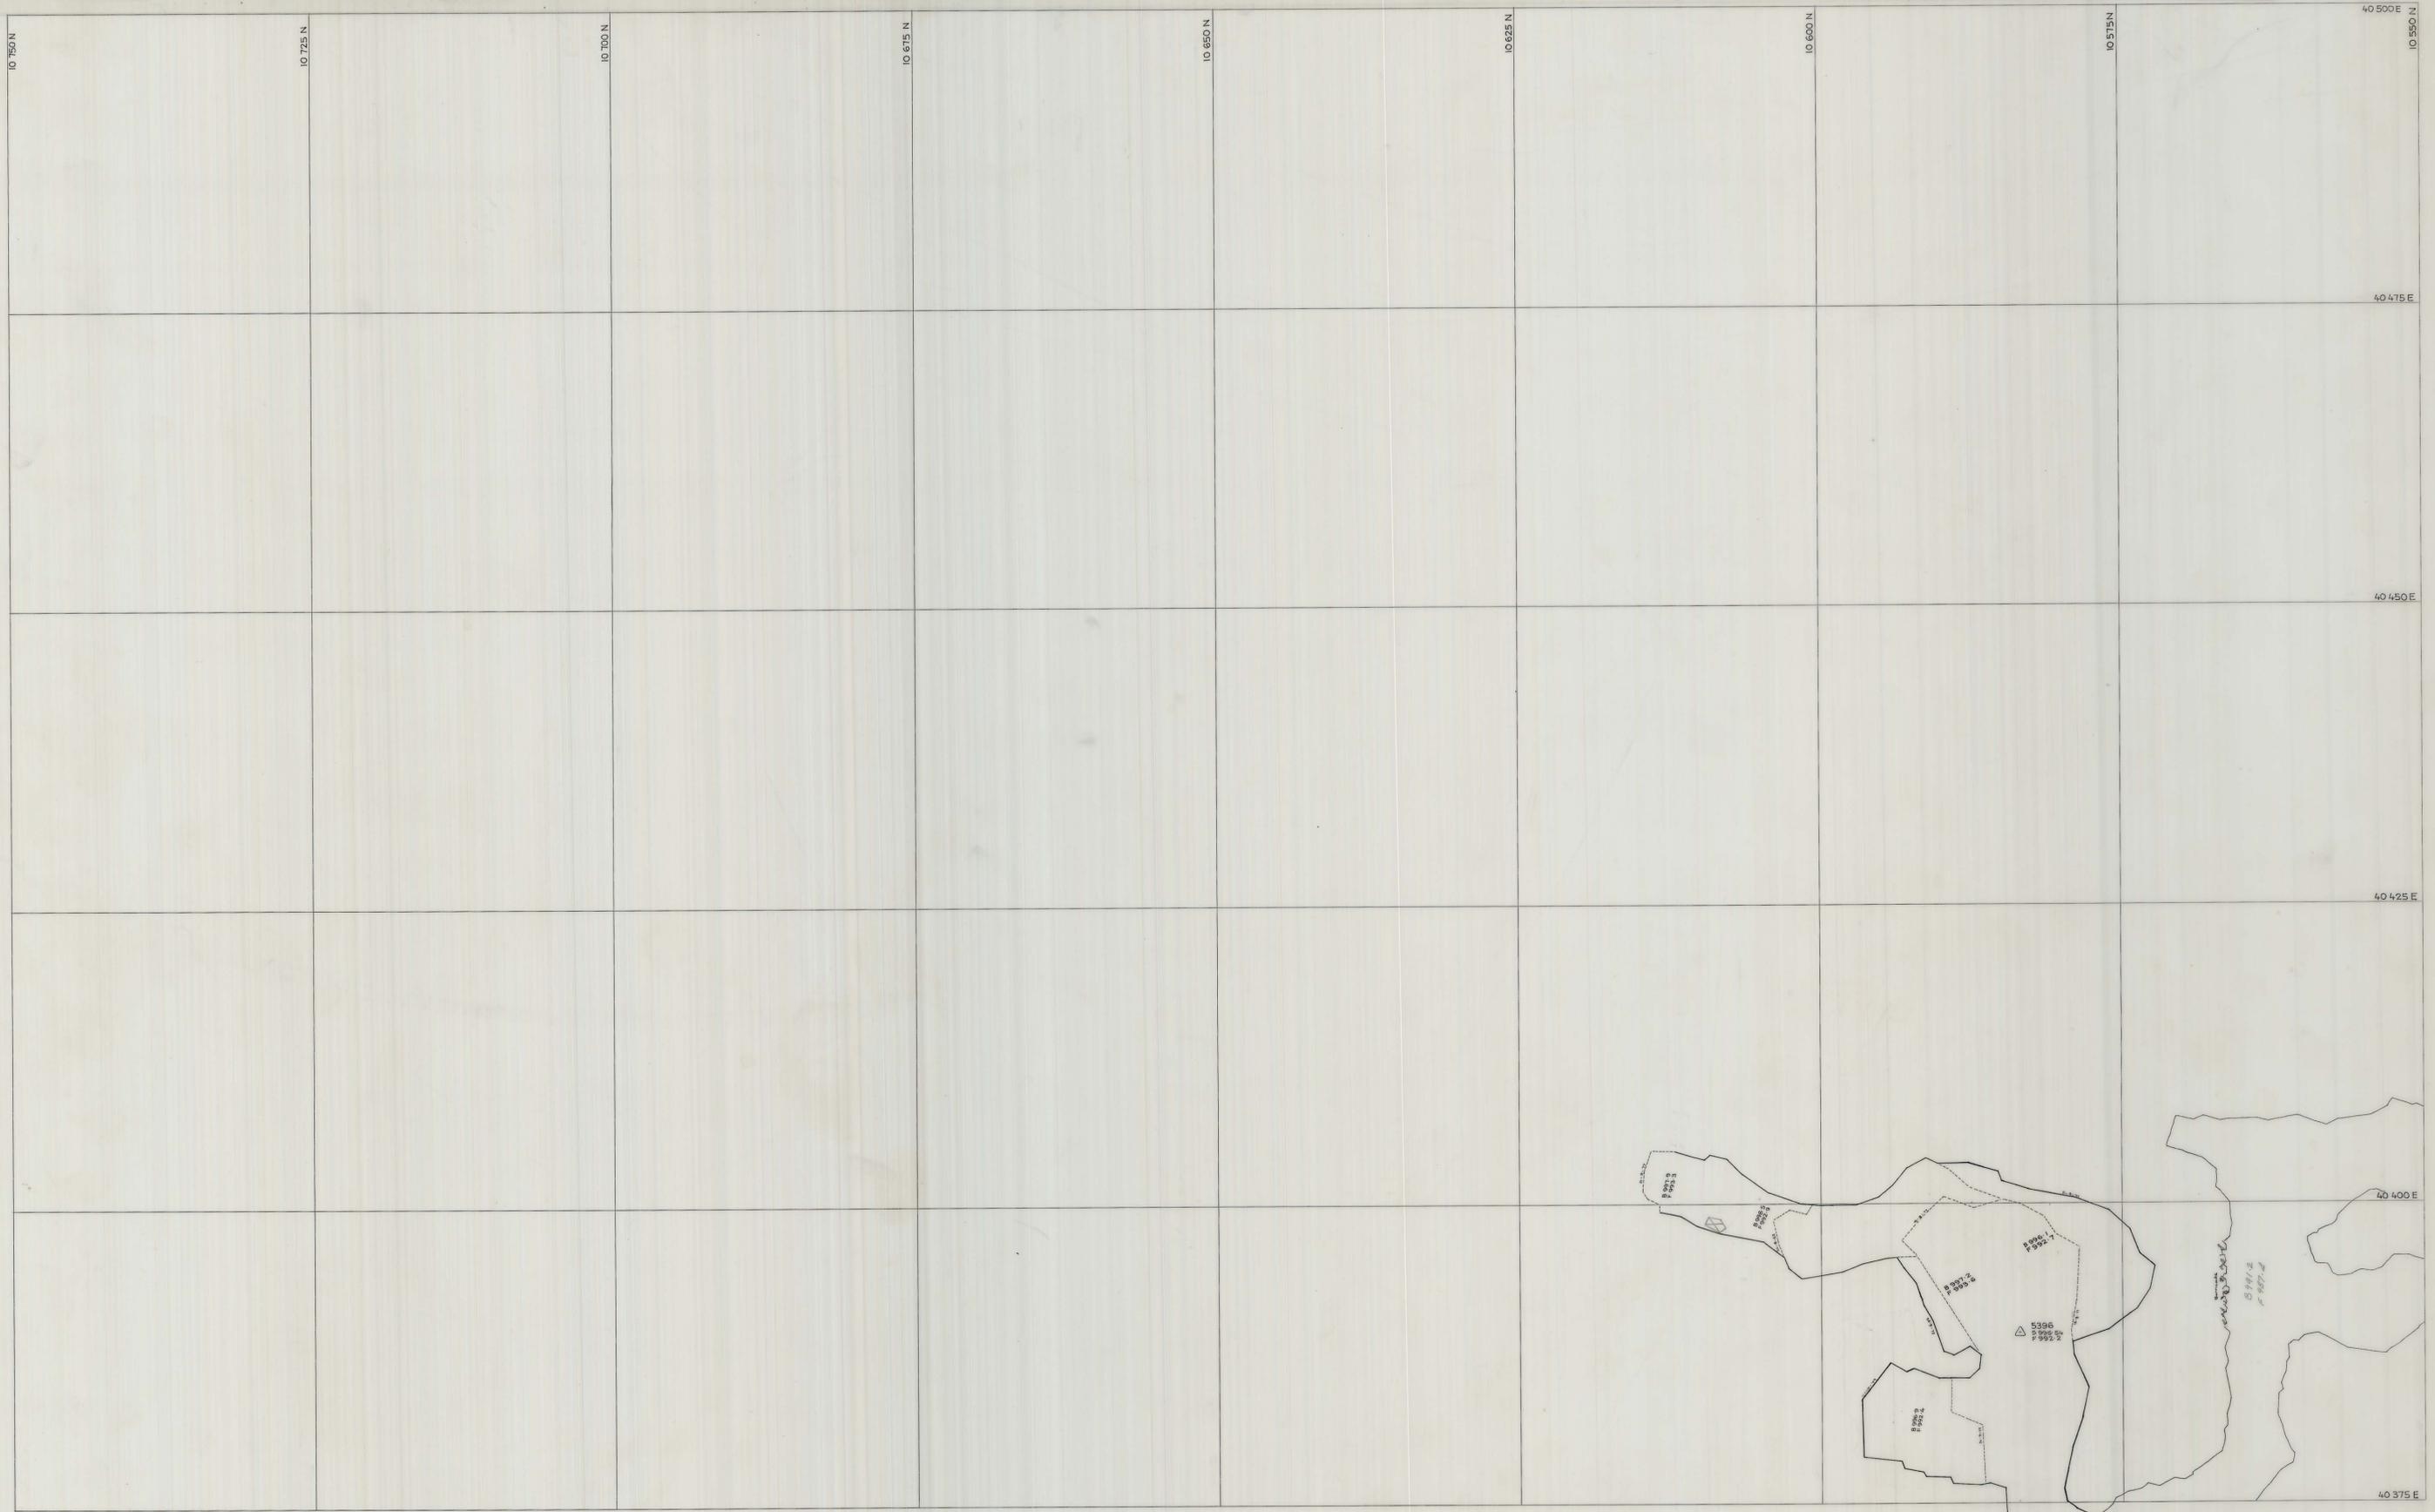

SCALE 1:250		LOCATION BOLD HEAD MINE	 GRASSY KING ISLAND PLAN NUMBER 04BH13 - 166 156
north		SUBJECT N 54 STOPE CUT & FILL STOPE [2nd LIFT]	