


27 JUN 1981

5 cm

04BH13-166 158

0374_4516

N54
FIRST
LIFT

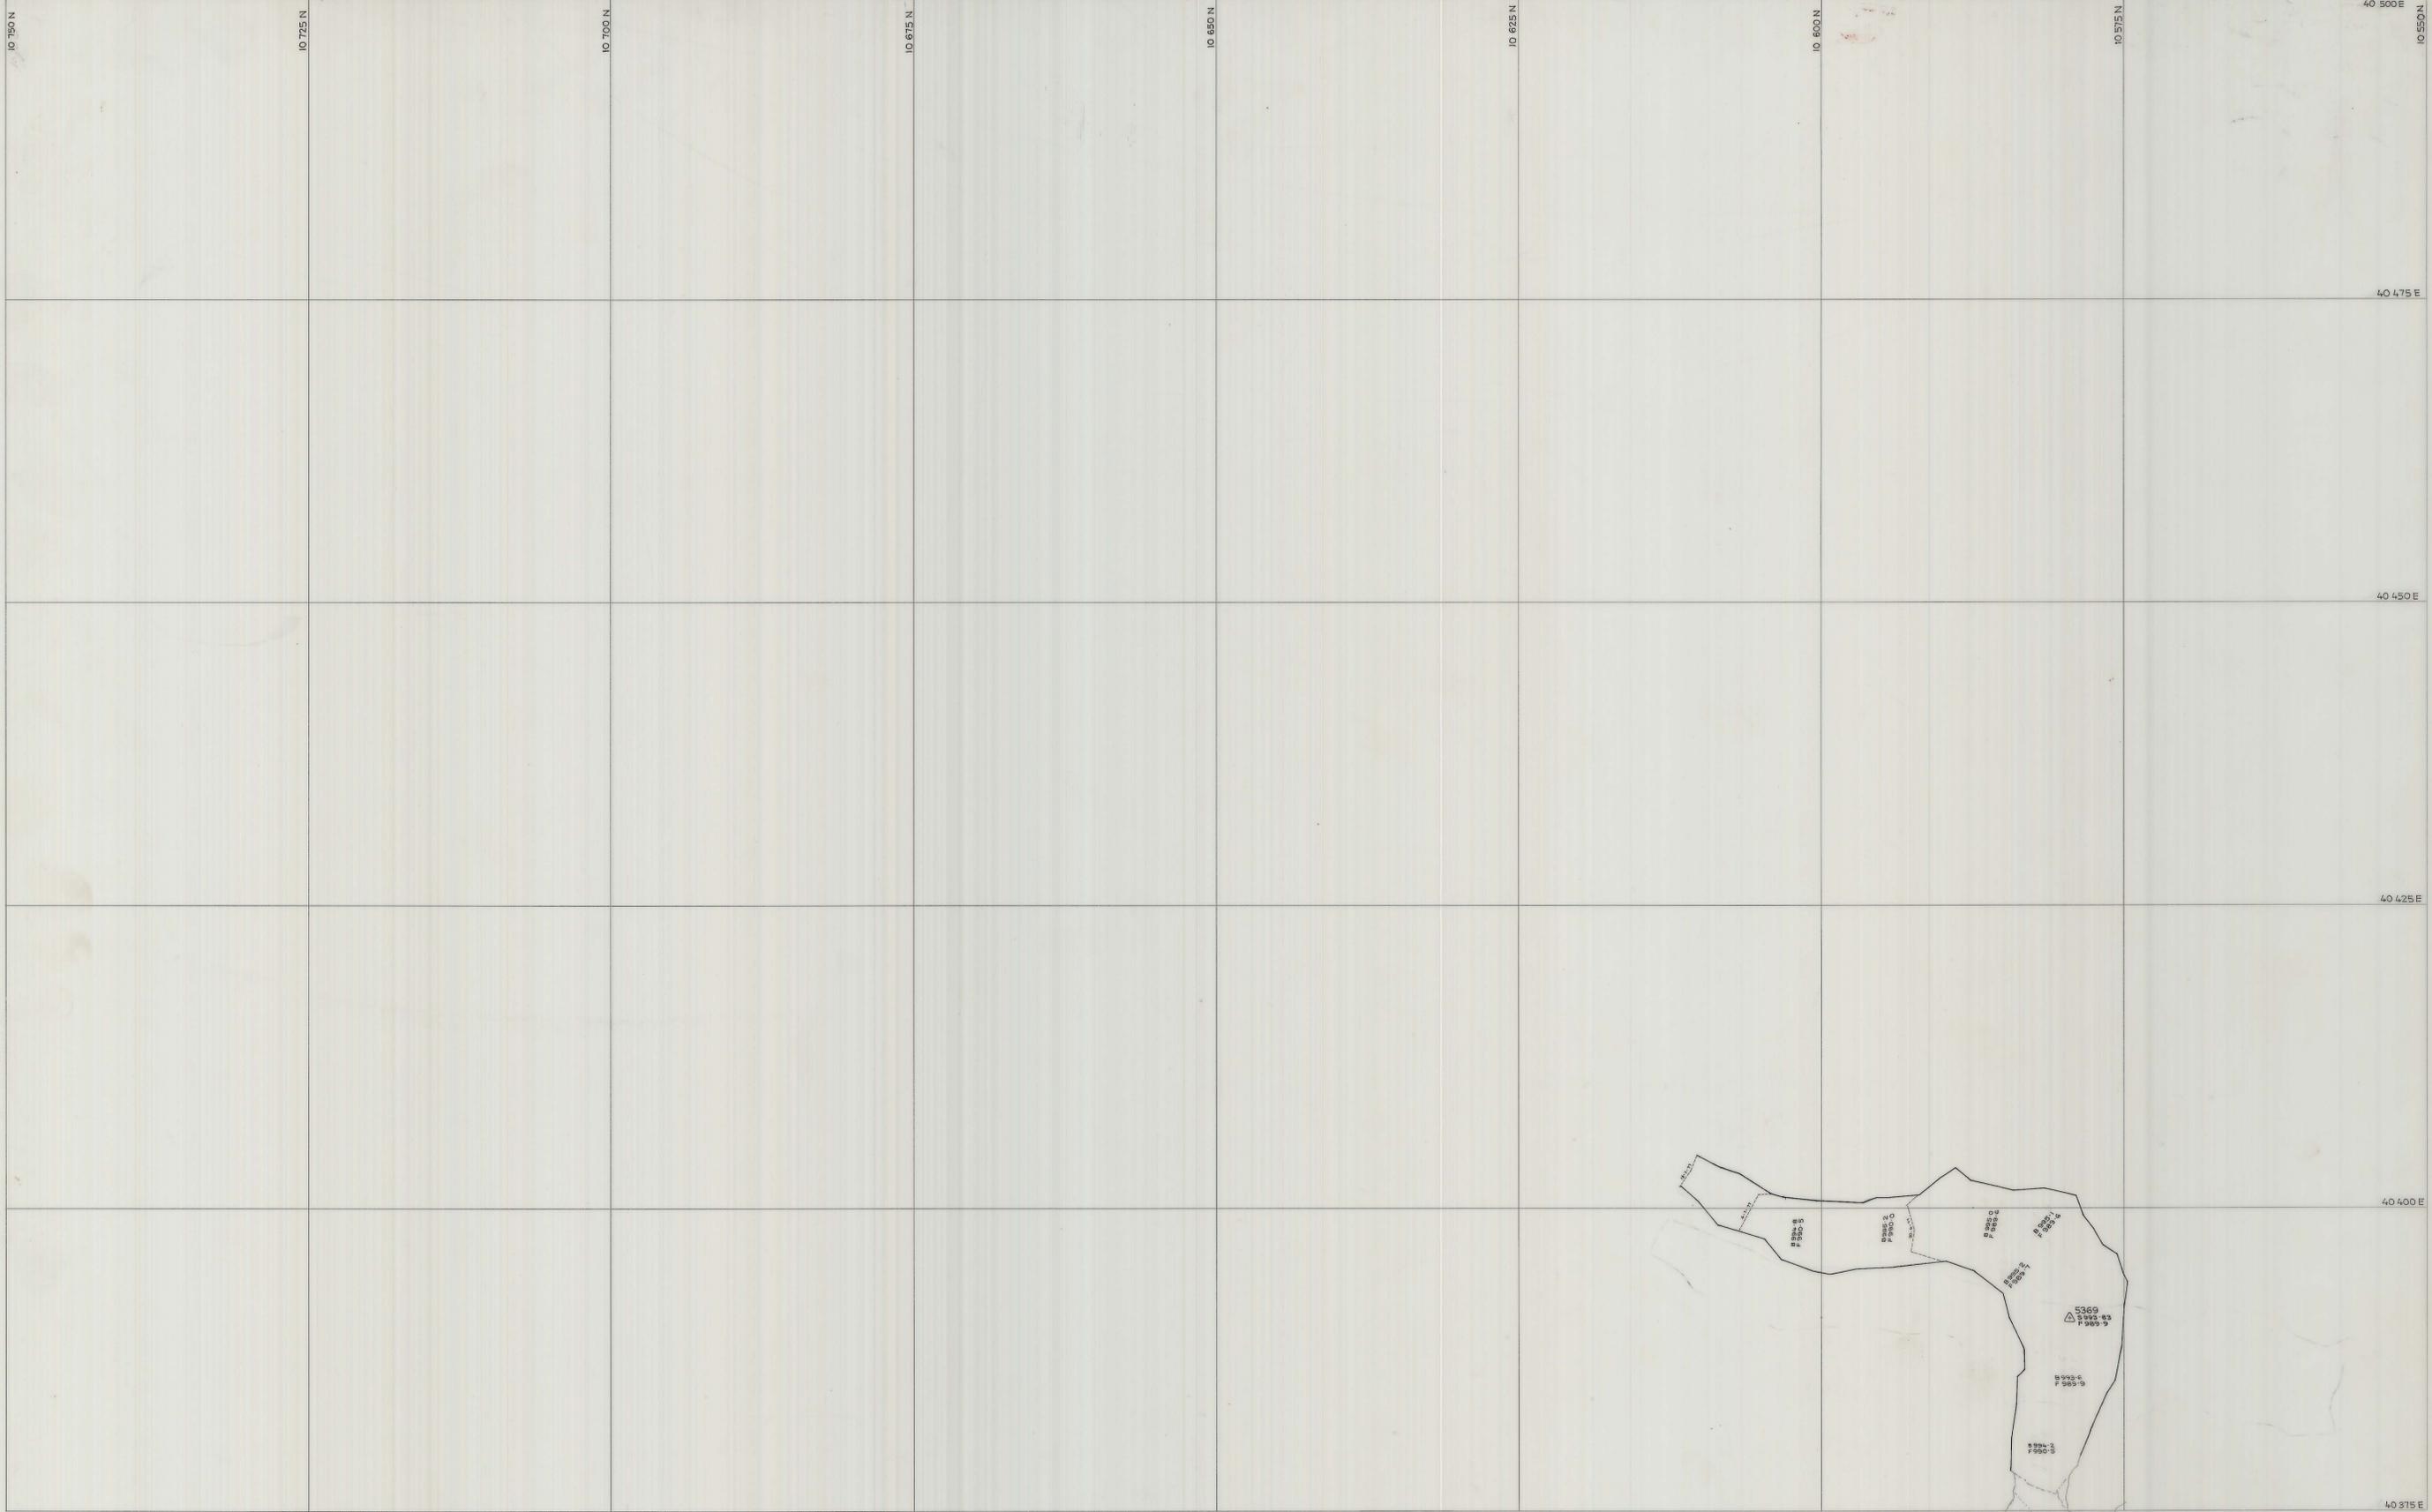

SCALE 1:250

LOCATION BOLD HEAD MINE

SUBJECT N54 STOPE
CUT & FILL STOPE
[1st. LIFT]

north

KIS KING ISLAND SCHEELITE
A DIVISION OF WARRAN INTERNATIONAL

GRASSY KING ISLAND

PLAN NUMBER 04BH13 - 166 158