


27 JUN 1981


5 cm

04BH13-166164

0374_4518

N54 Stope
Crown Pillar

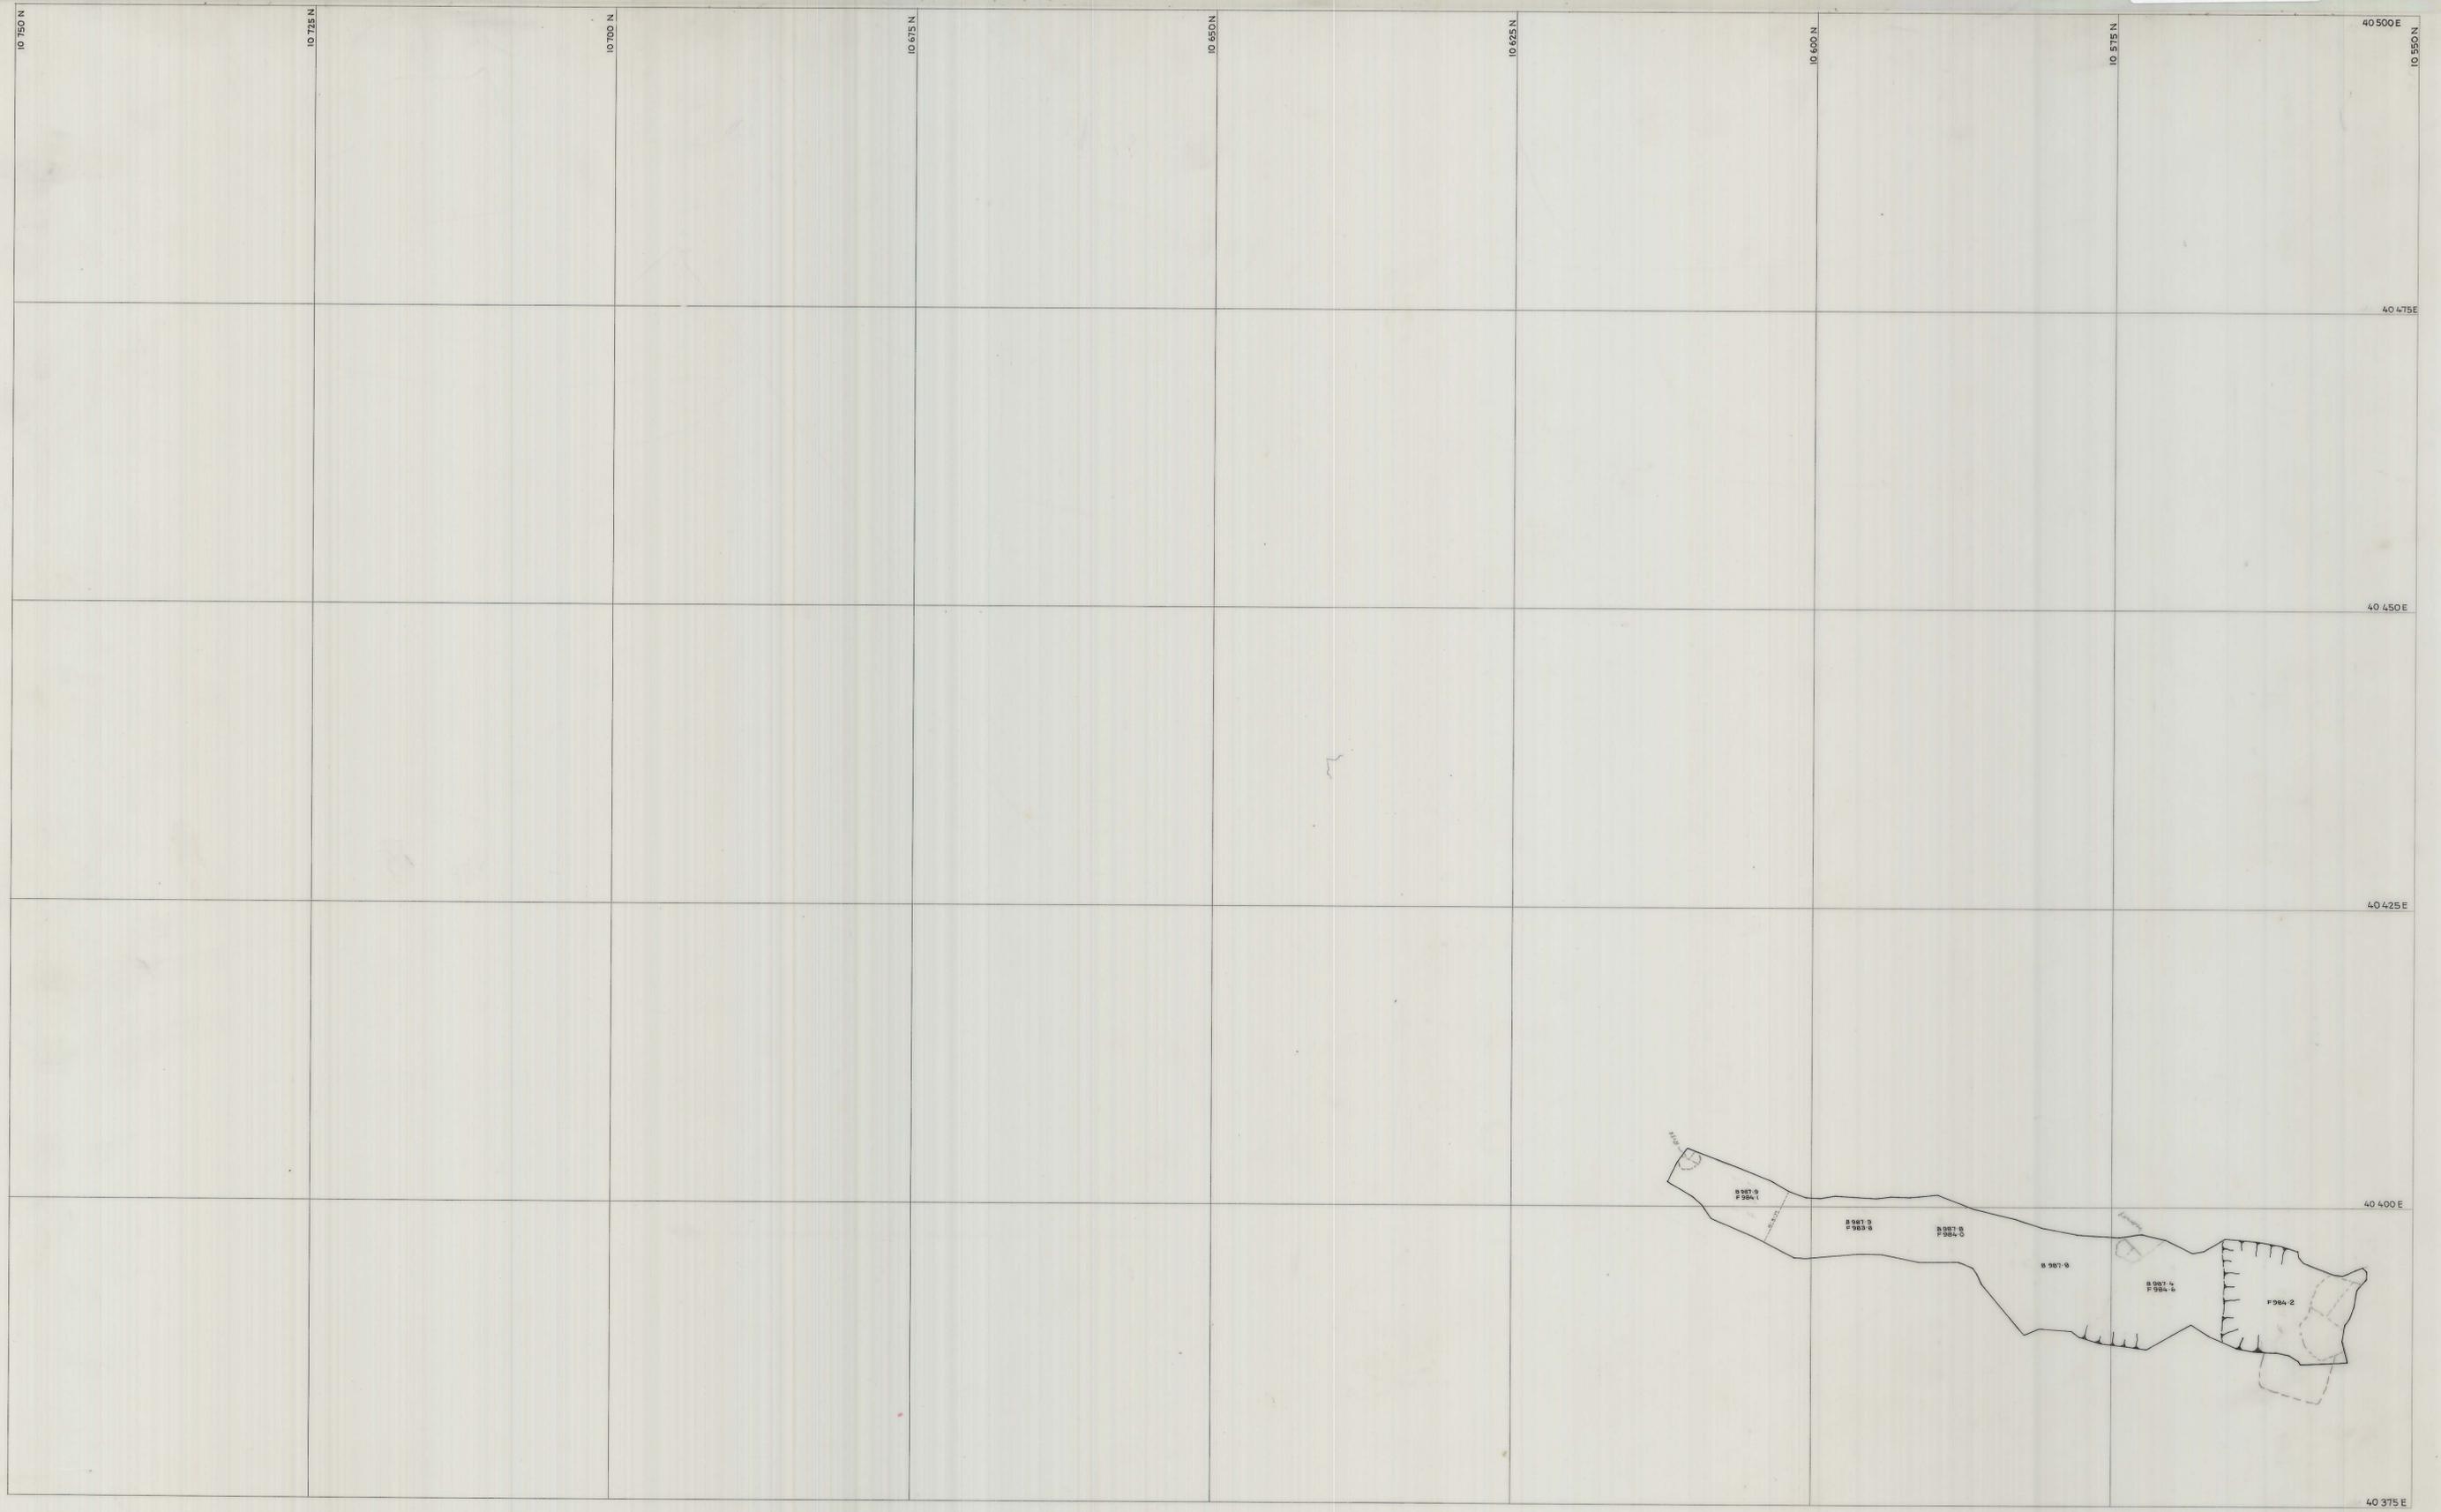

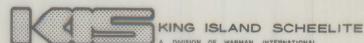	SCALE 1:250	LOCATION BOLD HEAD	 KING ISLAND SCHEELITE <small>A DIVISION OF WARMAN INTERNATIONAL</small> GRASSY KING ISLAND
		SUBJECT N 54 STOPE CROWN PILLAR	

north