


27 JUN 1981

5 cm

04BH13 - 165 074 S

H50
LIFT 13

0374_4519

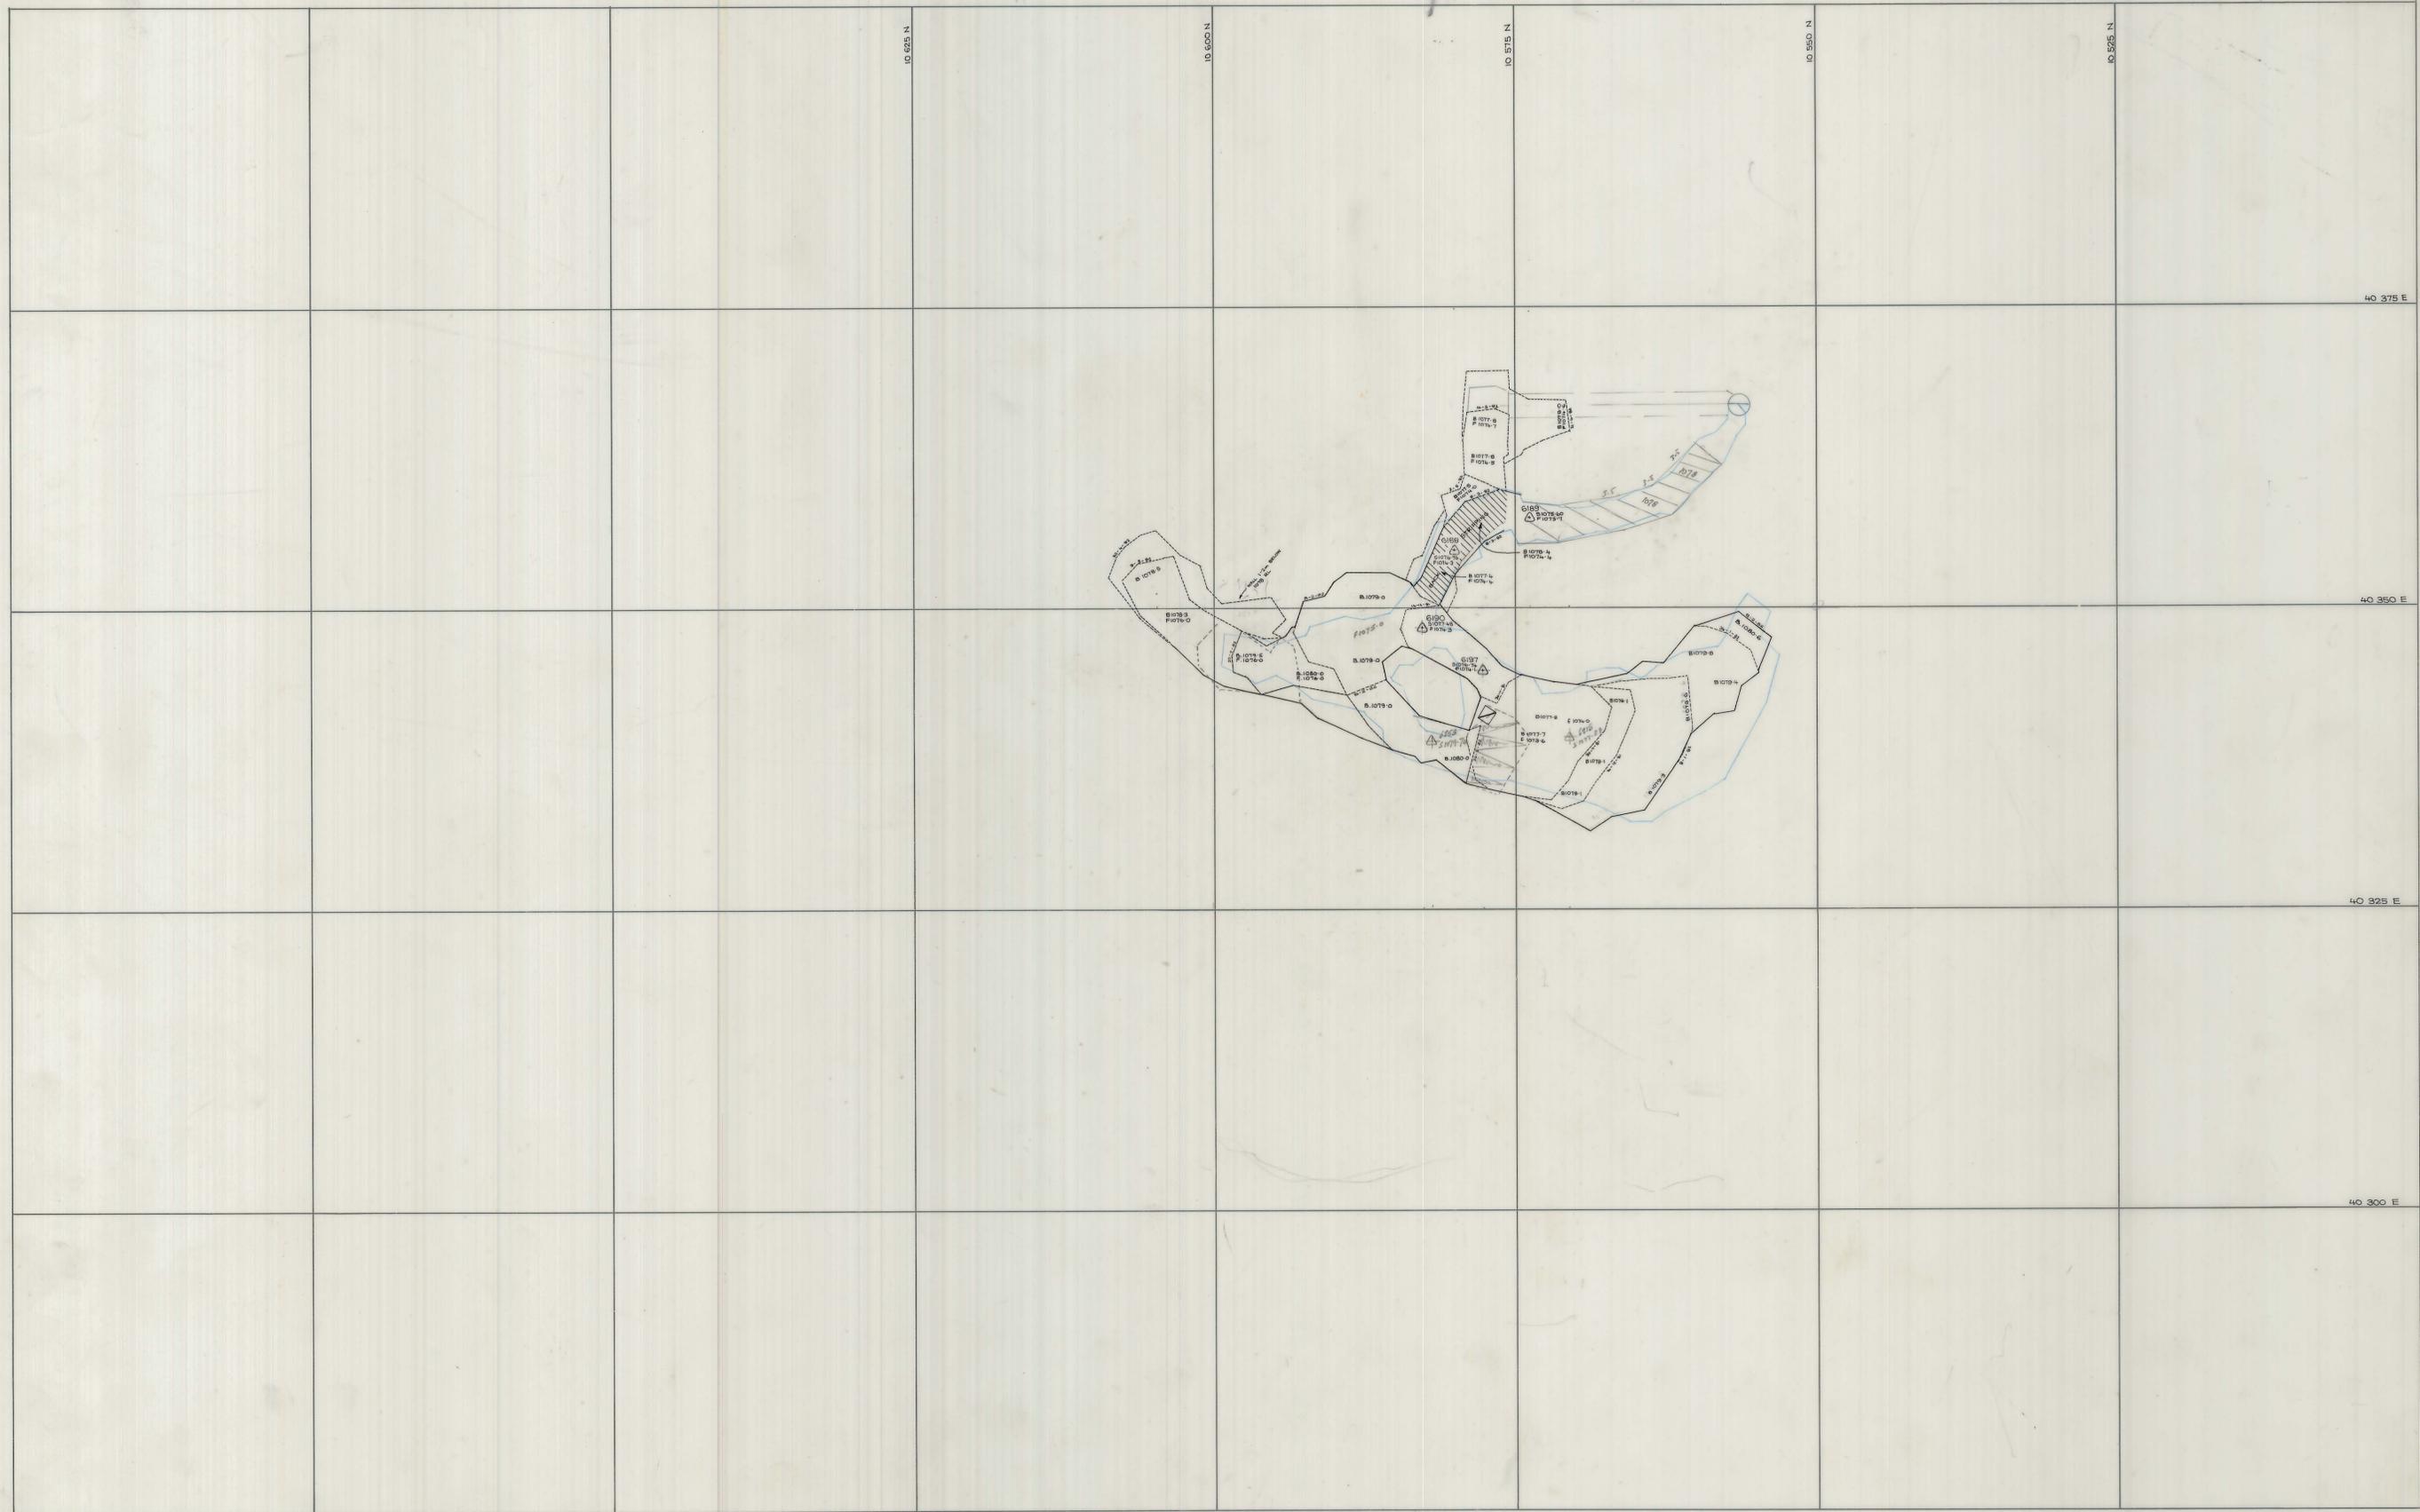

| | | | | |
|---------------|--------------------|--|---------------------------------------------------------------------------------|-------------------------------------------|
| <p>BS 100</p> | <p>SCALE 1:250</p> | | <p>LOCATION BOLD HEAD MINE</p> <p>SUBJECT H 50 STOPE 13 th lift</p> | <p>PLAN NUMBER 04BH13 - 165 074 S</p> |
|---------------|--------------------|--|---------------------------------------------------------------------------------|-------------------------------------------|