



0374-452

04DM15-1053
SECTIONS DATE 29-8-92

206

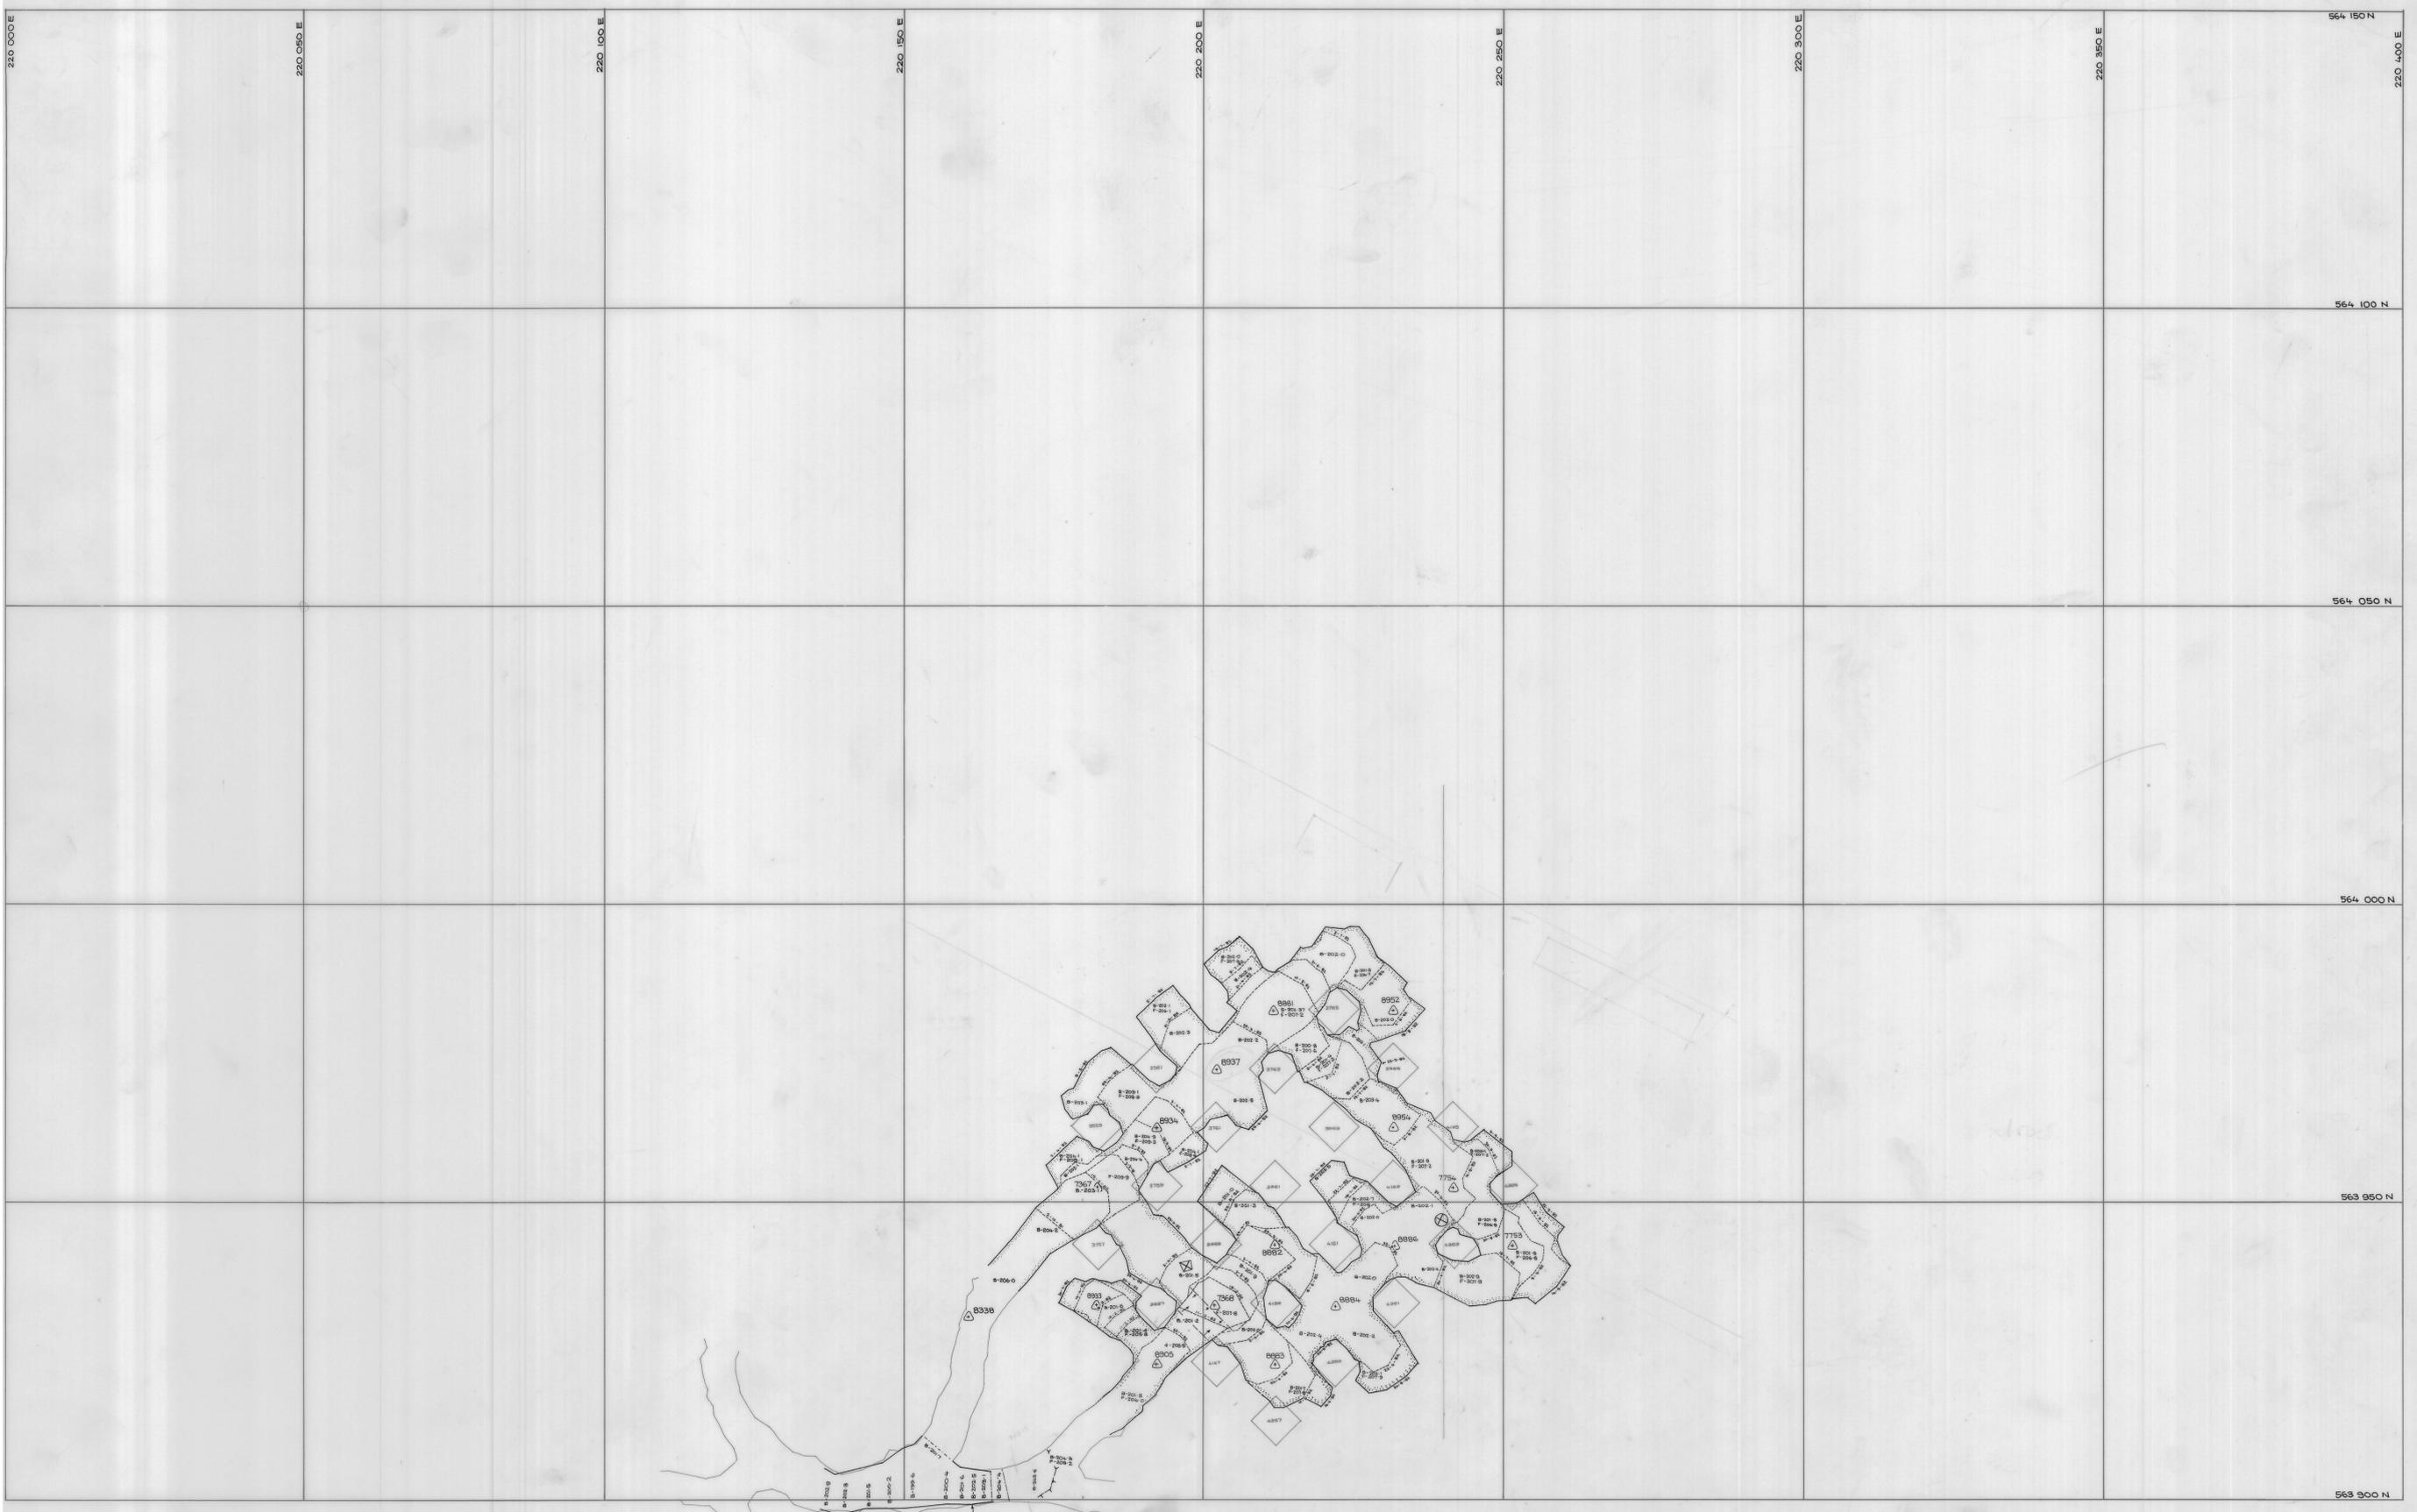

SCALE 1:500

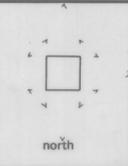

LOCATION DOLPHIN MINE
 SUBJECT LOWER PIT STOPE
 -206 m CONTOUR

KIS KING ISLAND SCHEELITE
 A DIVISION OF WARMAN INTERNATIONAL

GRASSY KING ISLAND

PLAN NUMBER 04DM15 - 1053