
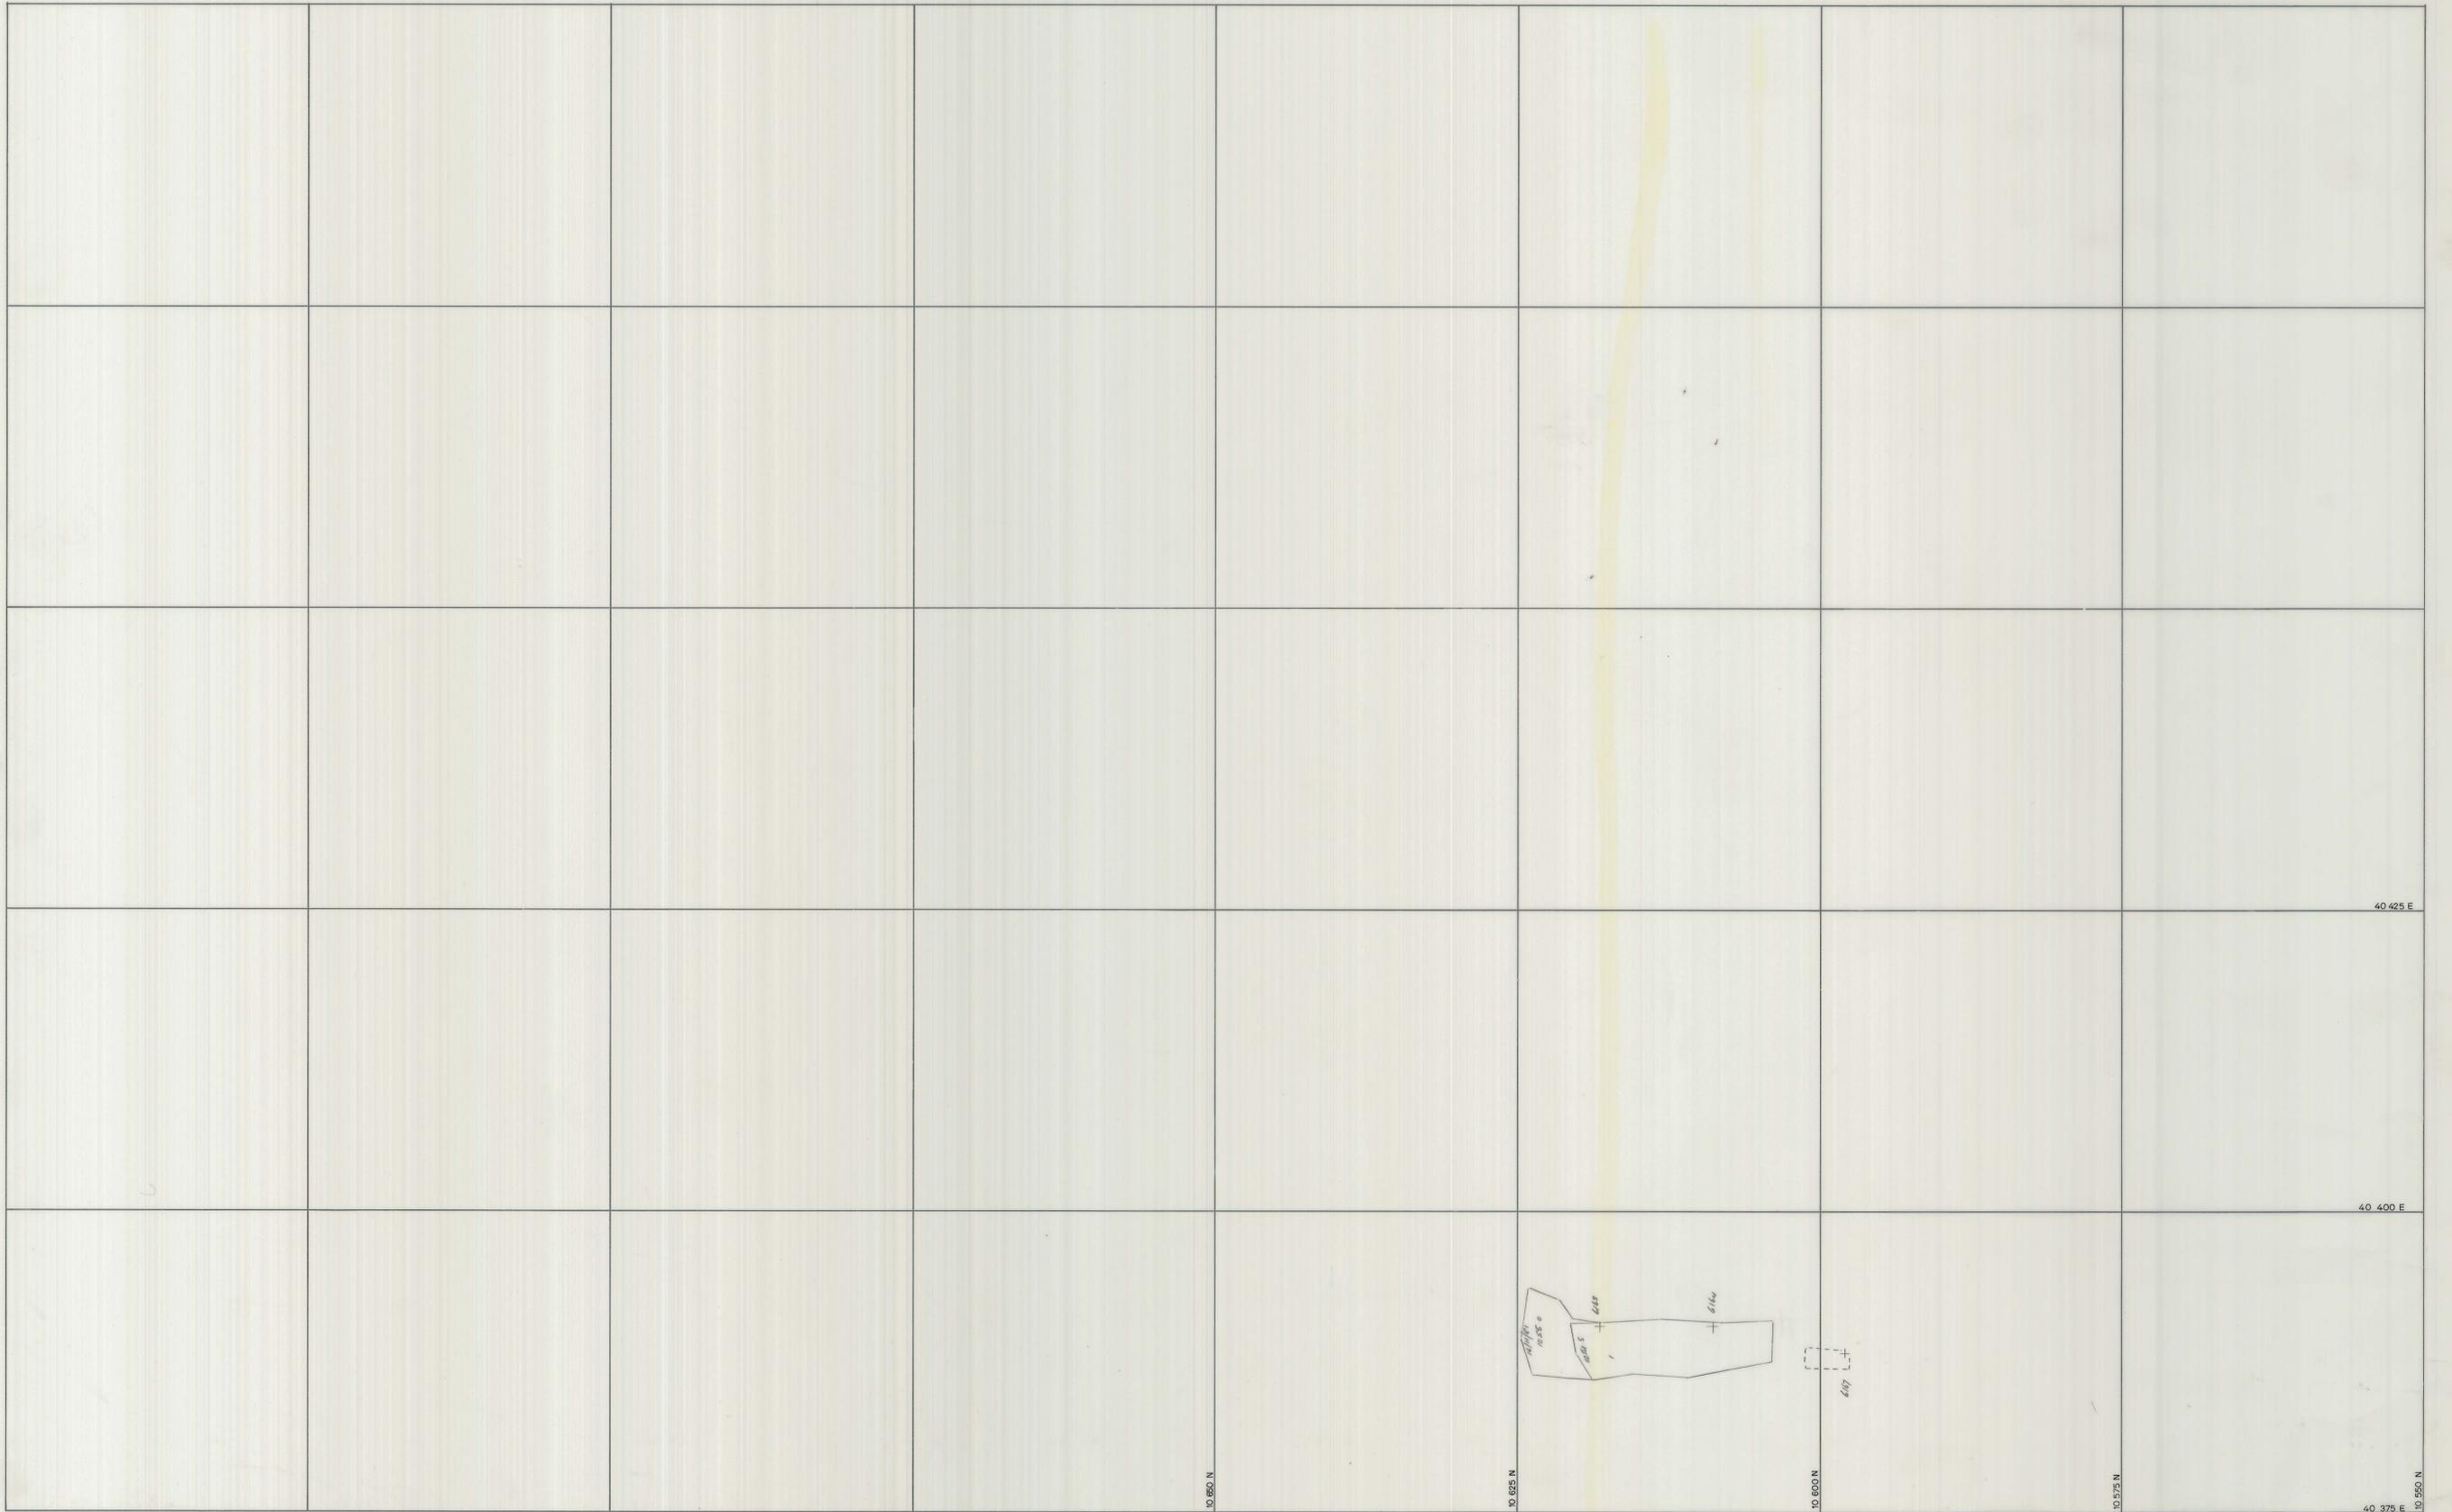


04BH13 - 166 095

P57 Shaft lift II

0374\_4522

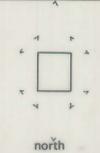

	SCALE 1:250	 north	LOCATION BOLD HEAD MINE	 <b>KING ISLAND SCHEELITE</b> A DIVISION OF WARMAN INTERNATIONAL <small>GRASSY KING ISLAND</small>
			SUBJECT P 57 11th lift	