




04BH13 - 166 096

P 70
Lift B
Upper B
Lens

0374_4525

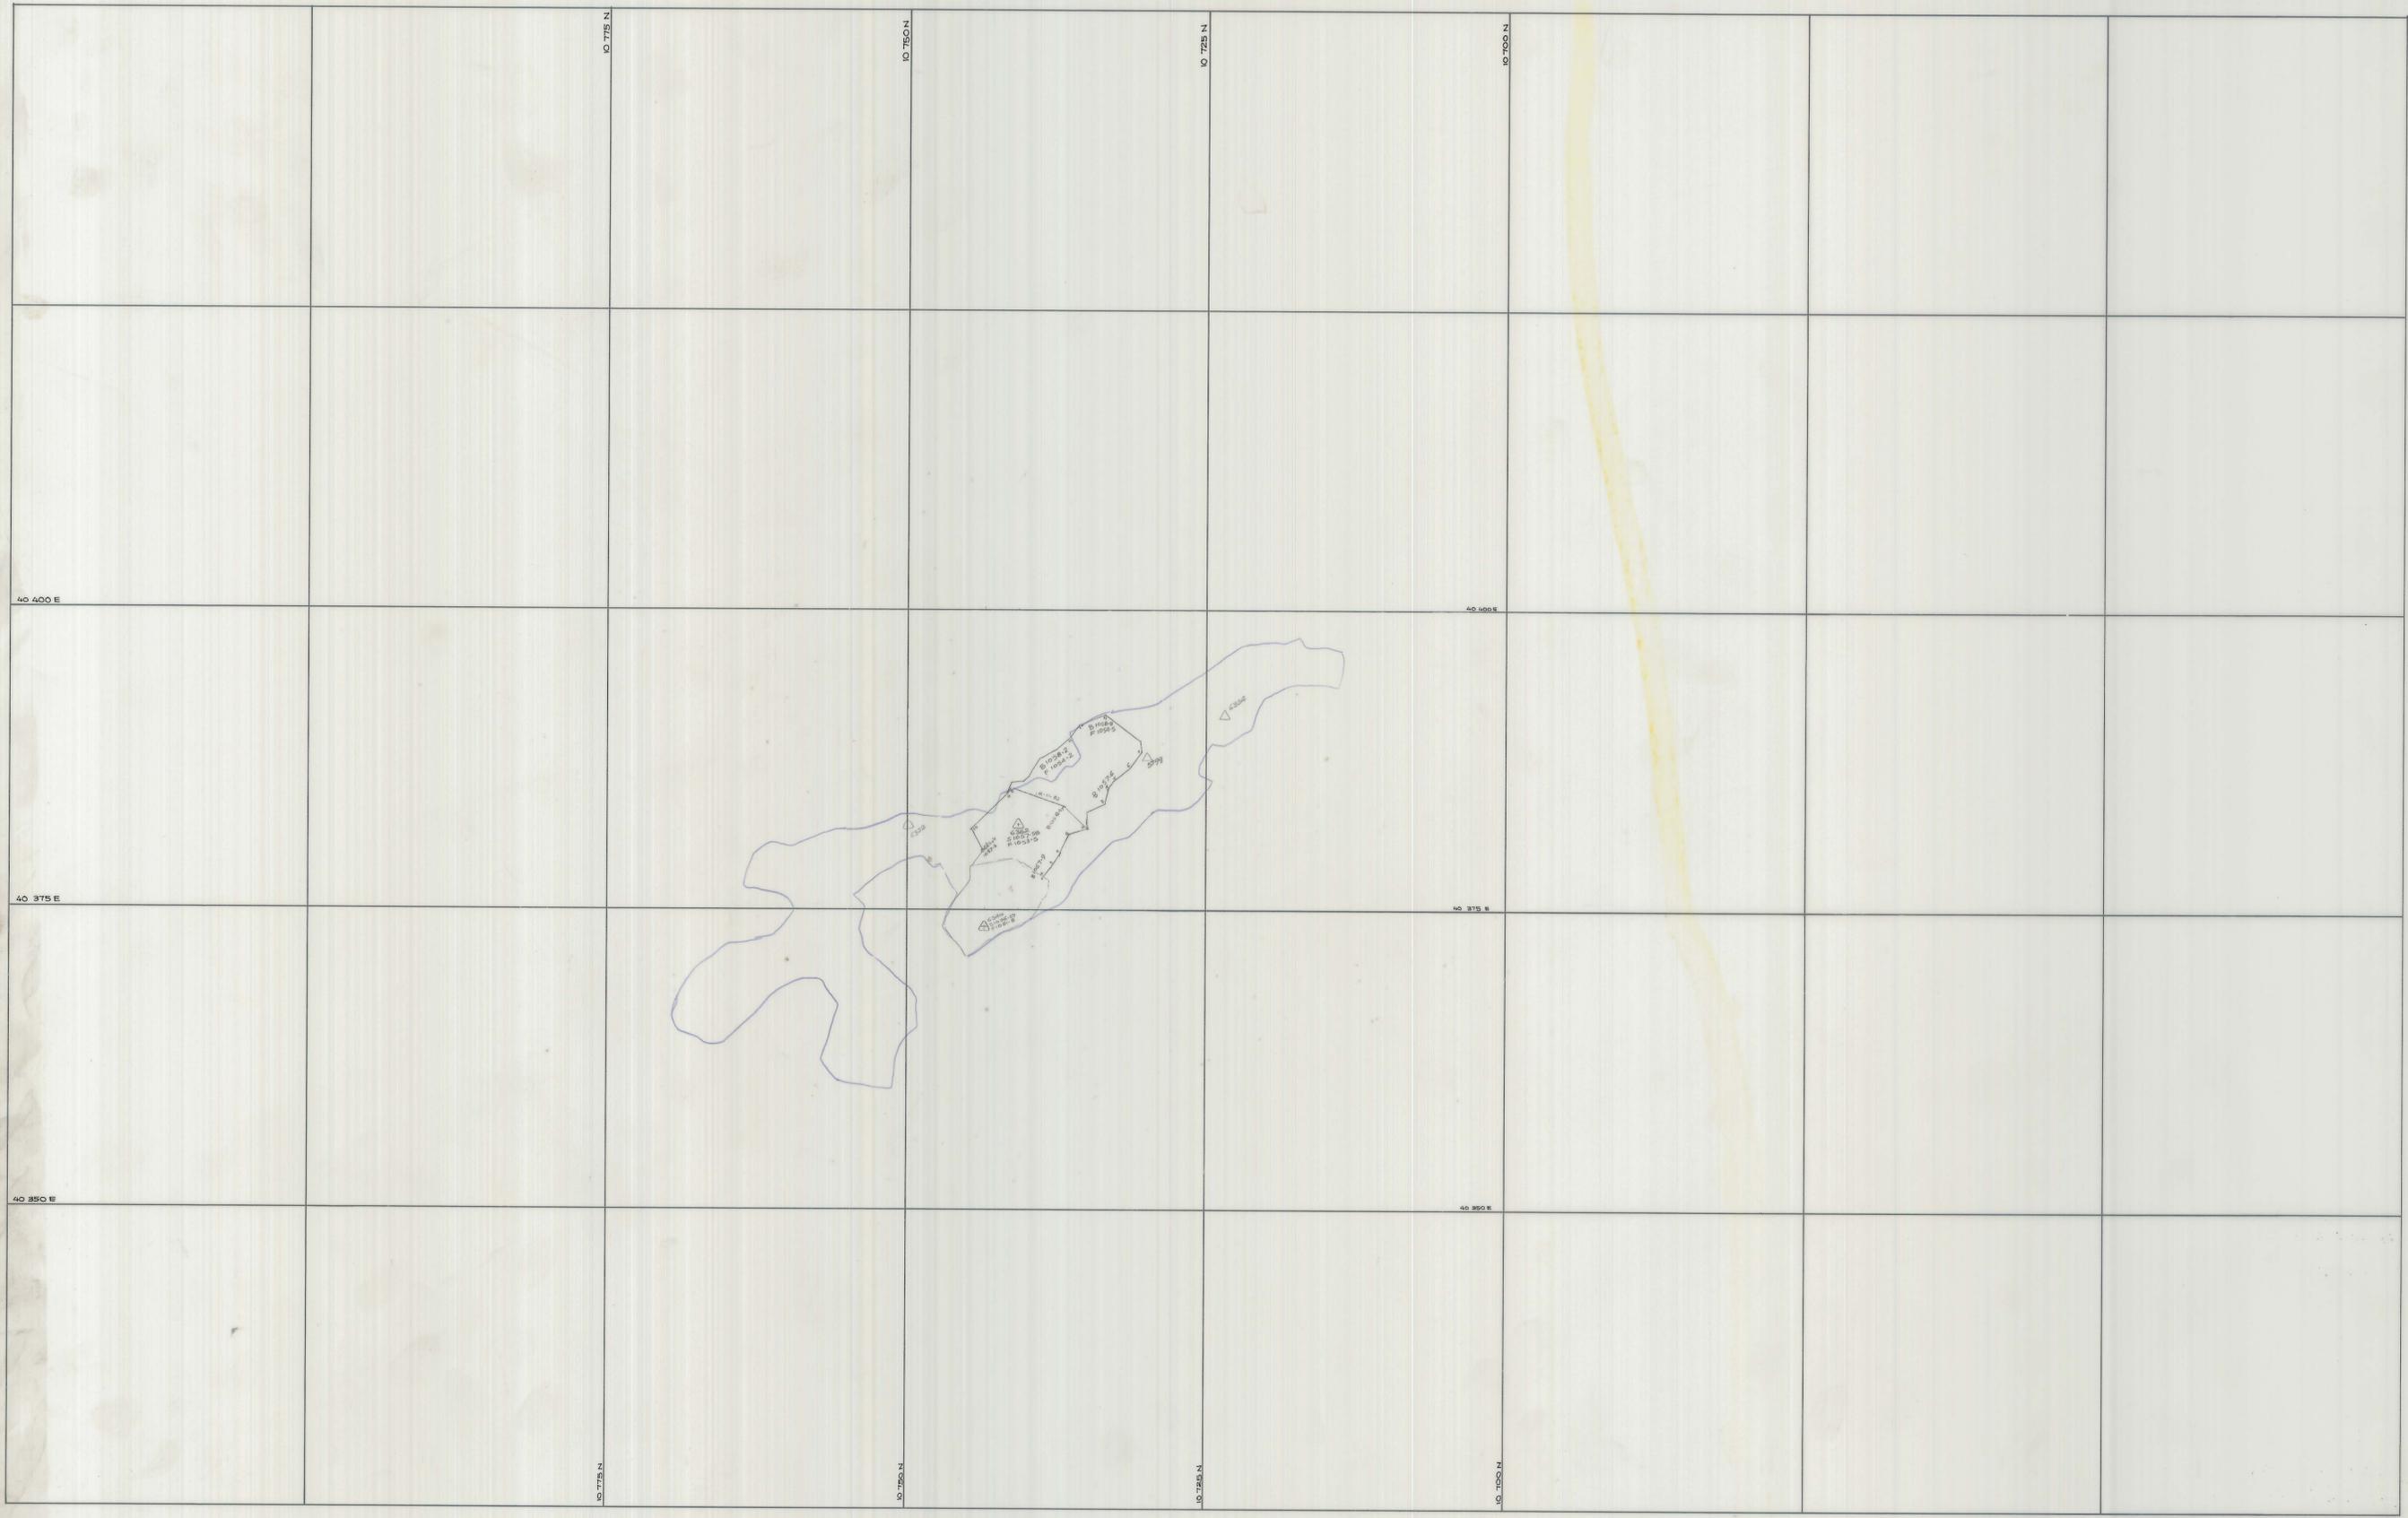

<p>SCALE 1: 250</p> <p>SI 112</p>		<p>LOCATION BOLD HEAD MINE</p> <p>SUBJECT P 70 STOPE 8th lift</p> <p>UPPER B LENS</p>	<p>KING ISLAND SCHEELITE A DIVISION OF WARMAN INTERNATIONAL</p> <p>GRASSY KING ISLAND</p> <p>PLAN NUMBER 04BH13 - 166 096</p>
-----------------------------------	--	---	---