


04BH13-166 097 S P70 Stope  
Lift 7

0374\_4526

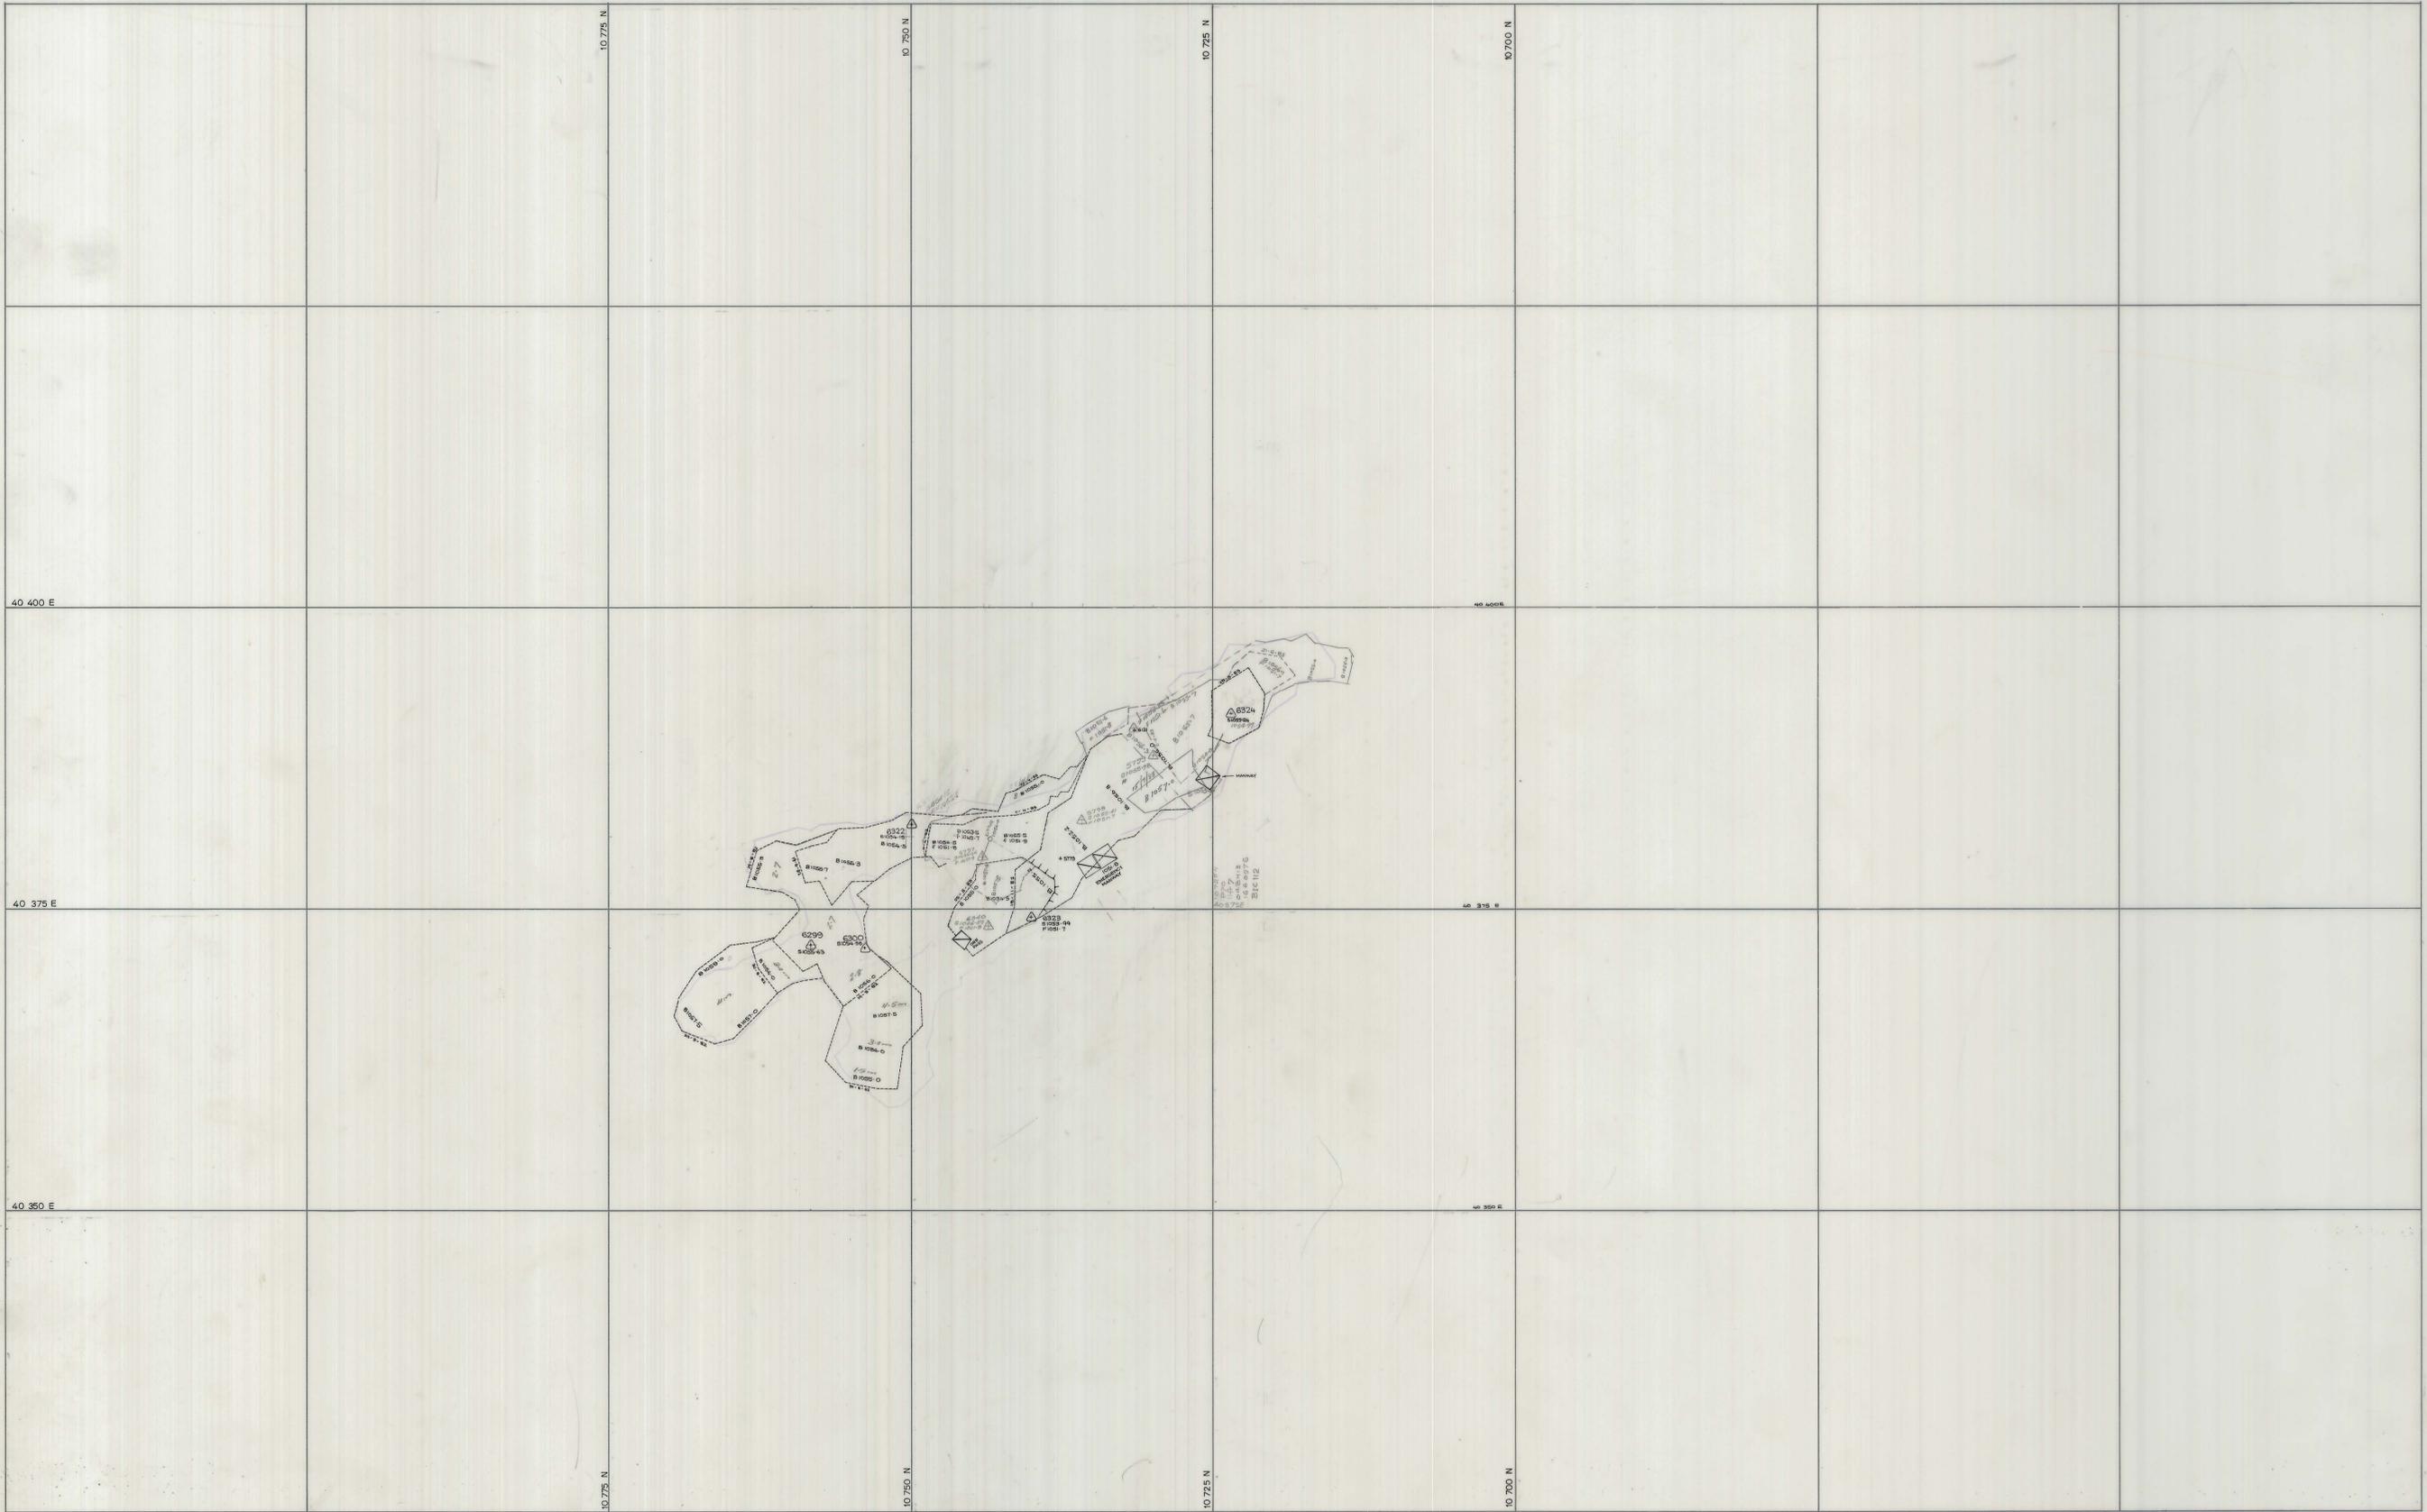

	SCALE 1:250	<p>north</p>	<p>LOCATION BOLD HEAD MINE</p> <p>SUBJECT P 70 STOPE 7th lift</p>	<p>GRASSY KING ISLAND</p> <p>PLAN NUMBER 04BH13 - 166 097 S</p>
--	-------------	--------------	---	---